


SCALE 1" = 20'
 O = IRON PIPE
 X = CROSS CUT IN CONC.



FENCE ALONG LOT LINE

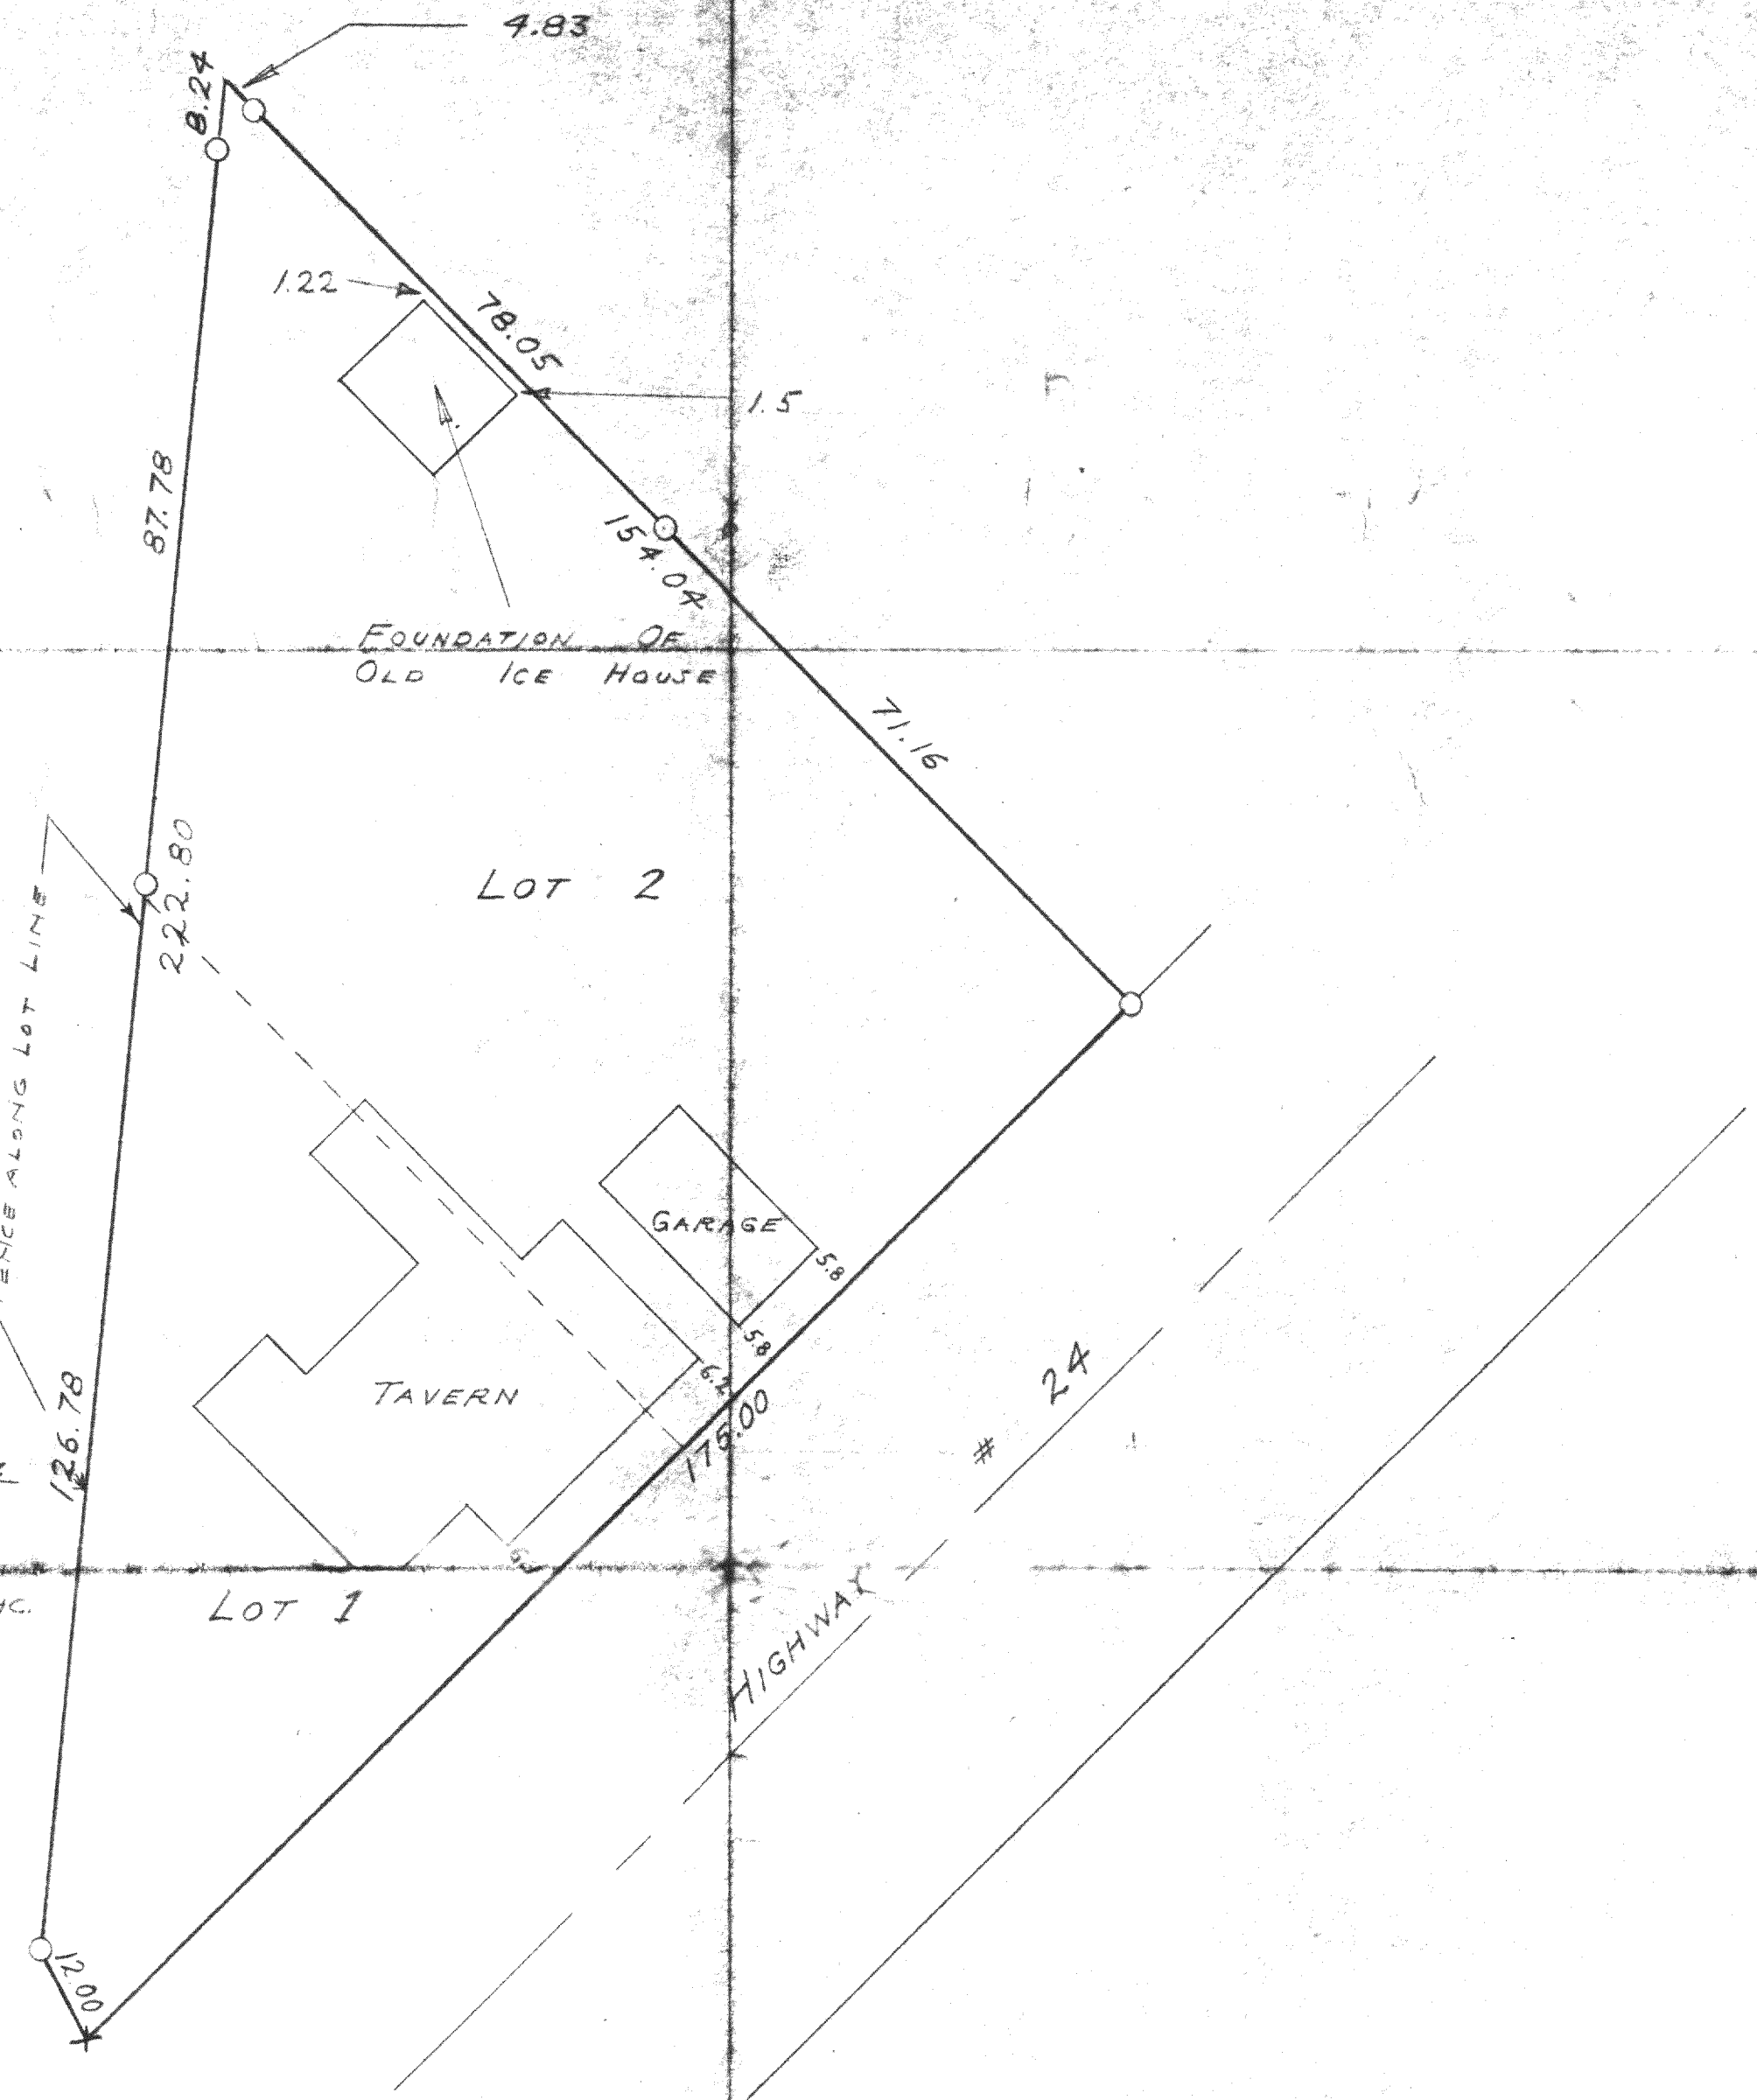

PLAT OF A SURVEY OF LOTS 1 AND 2
 OF BLOCK I OF THE ORIGINAL PLAT OF LAKE
 BEULAH WALWORTH COUNTY WISCONSIN
 AUGUST 1952

Lloyd L. Jensen
 WALWORTH COUNTY SURVEYOR