
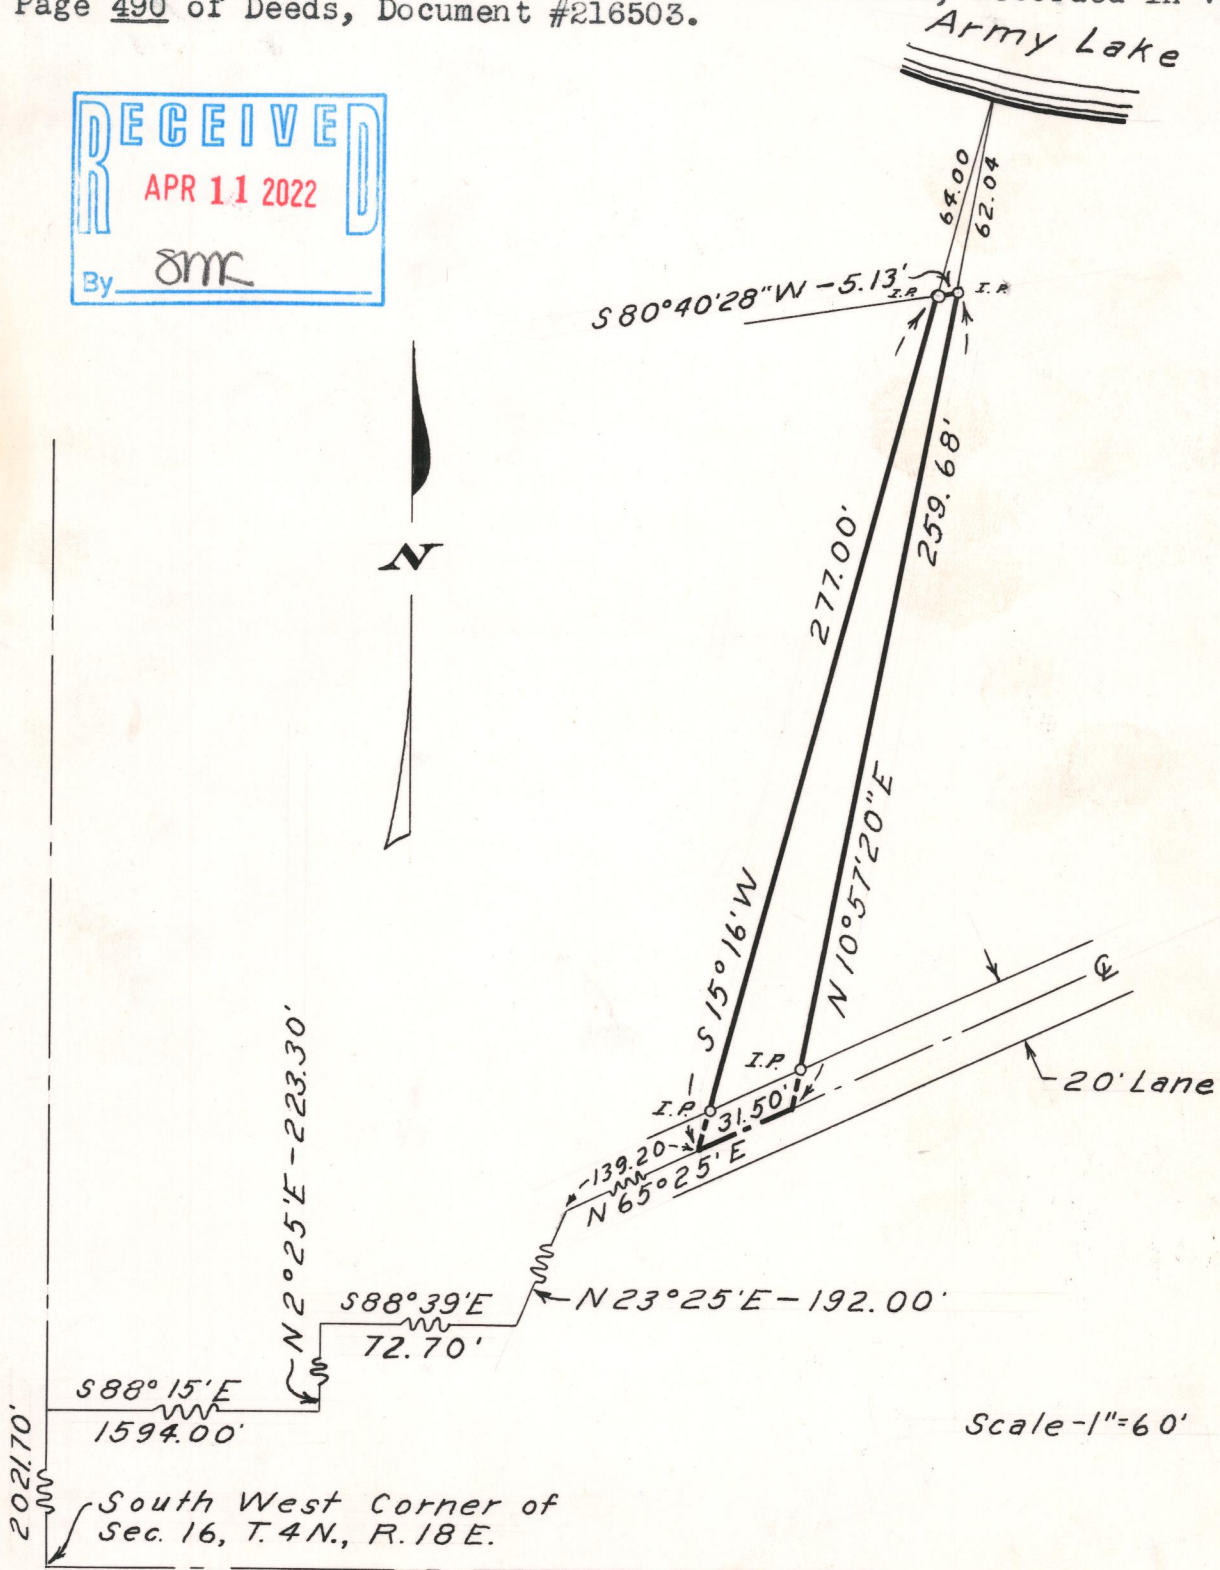


PLAT OF SURVEY

That part of Section 16, Town 4 North, Range 18 East, Town of East Troy, Walworth County, Wisconsin, bounded and described as follows, to-wit: Commencing at the South West corner of said Section; running thence North along the West line of said Section 2021.70 feet to a point; thence South 88° 15' East 1594.00 feet to a point; thence North 2° 25' East 223.30 feet to a point; thence South 88° 39' East 72.70 feet to a point; thence North 23° 25' East 192.00 feet to a point in the center line of a 20 foot Lane; thence North 65° 25' East along said center line 139.20 feet to a point, said point being the place of beginning of the land herein described; running thence North 65° 25' East along the center line of said Lane 31.50 feet to a point; thence North 10° 57' 20" East 259.68 feet to a point on the shore of Army Lake, said point being 62.04 feet South West-erly of the waters edge of Army Lake; thence South 80° 40' 28" West along the shore of Army Lake 5.13 feet to a point, said point being 64 feet South Westerly of the waters edge of Army Lake; thence South 15° 16' West 277.00 feet to the place of beginning, reserving the Southerly 10 feet for a Lane and subject to an easement for a road, Recorded in Volume 151 Page 490 of Deeds, Document #216503.

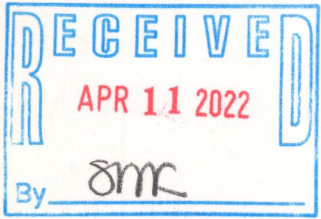

State of Wisconsin }
County of Milwaukee } ss.

I, Roman C. Engel, do hereby certify that I have made the above survey on the 24th day of May 1946, and that the survey of the lot and information as shown on said survey, is complete and correct, and I further certify that Sawyer is the owner of record of the premises as described and shown above.

Signed Roman C. Engel
Surveyor

PO-9

418-2829