
LOCATION: W2369 New Deal Avenue, East Troy, Wisconsin

LEGAL Lot 20 DESCRIPTION: in FREUCK'S SU SUBDIVISION, located in the Northwest Fractional 1/4 of Section 18, Township 4 North, Range 18 East, in the Town 0 f East Troy, Walworth County, Wisconsin.

Survey No.

114538

August 15,

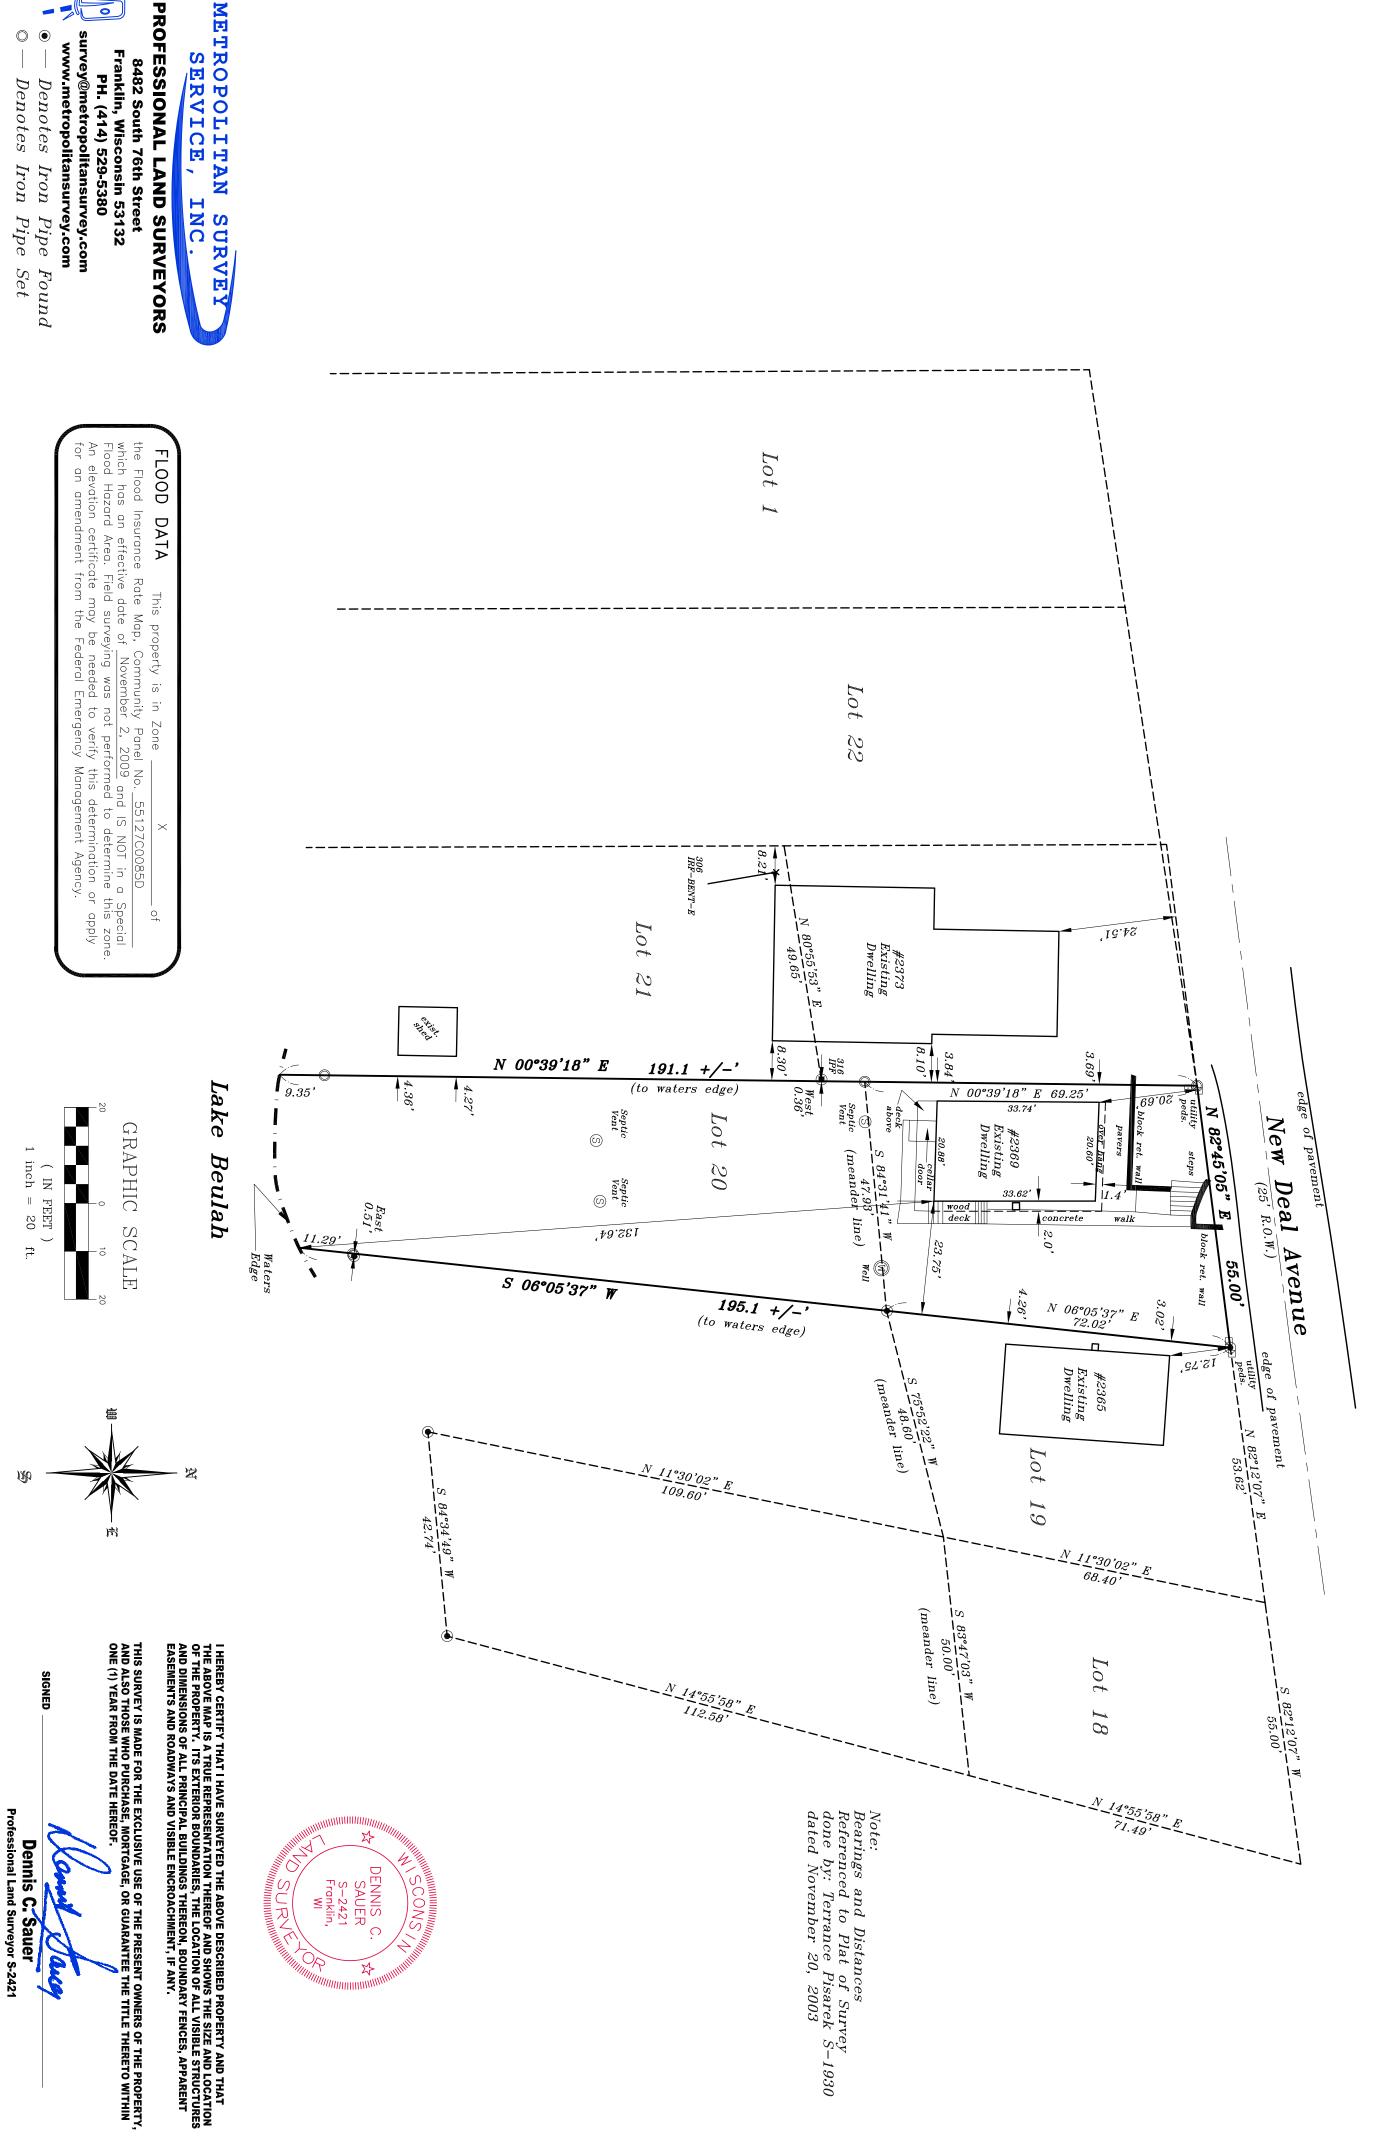

DenotesDenotes