


HOLLAND & THOMAS, L.L.C. - LAND SURVEYORS

202 West Street Johnson Creek, WI 53038 (920) 699-3305

PLAT OF SURVEY

FOR LOT 30 OF TROY HILL ESTATES, AND BEING A PART OF THE NE 1/4 & NW 1/4 OF THE SOUTHWEST QUARTER OF SECTION 30, TOWN 4 NORTH, RANGE 18 EAST, TOWN OF EAST TROY, WALWORTH COUNTY, WISCONSIN.

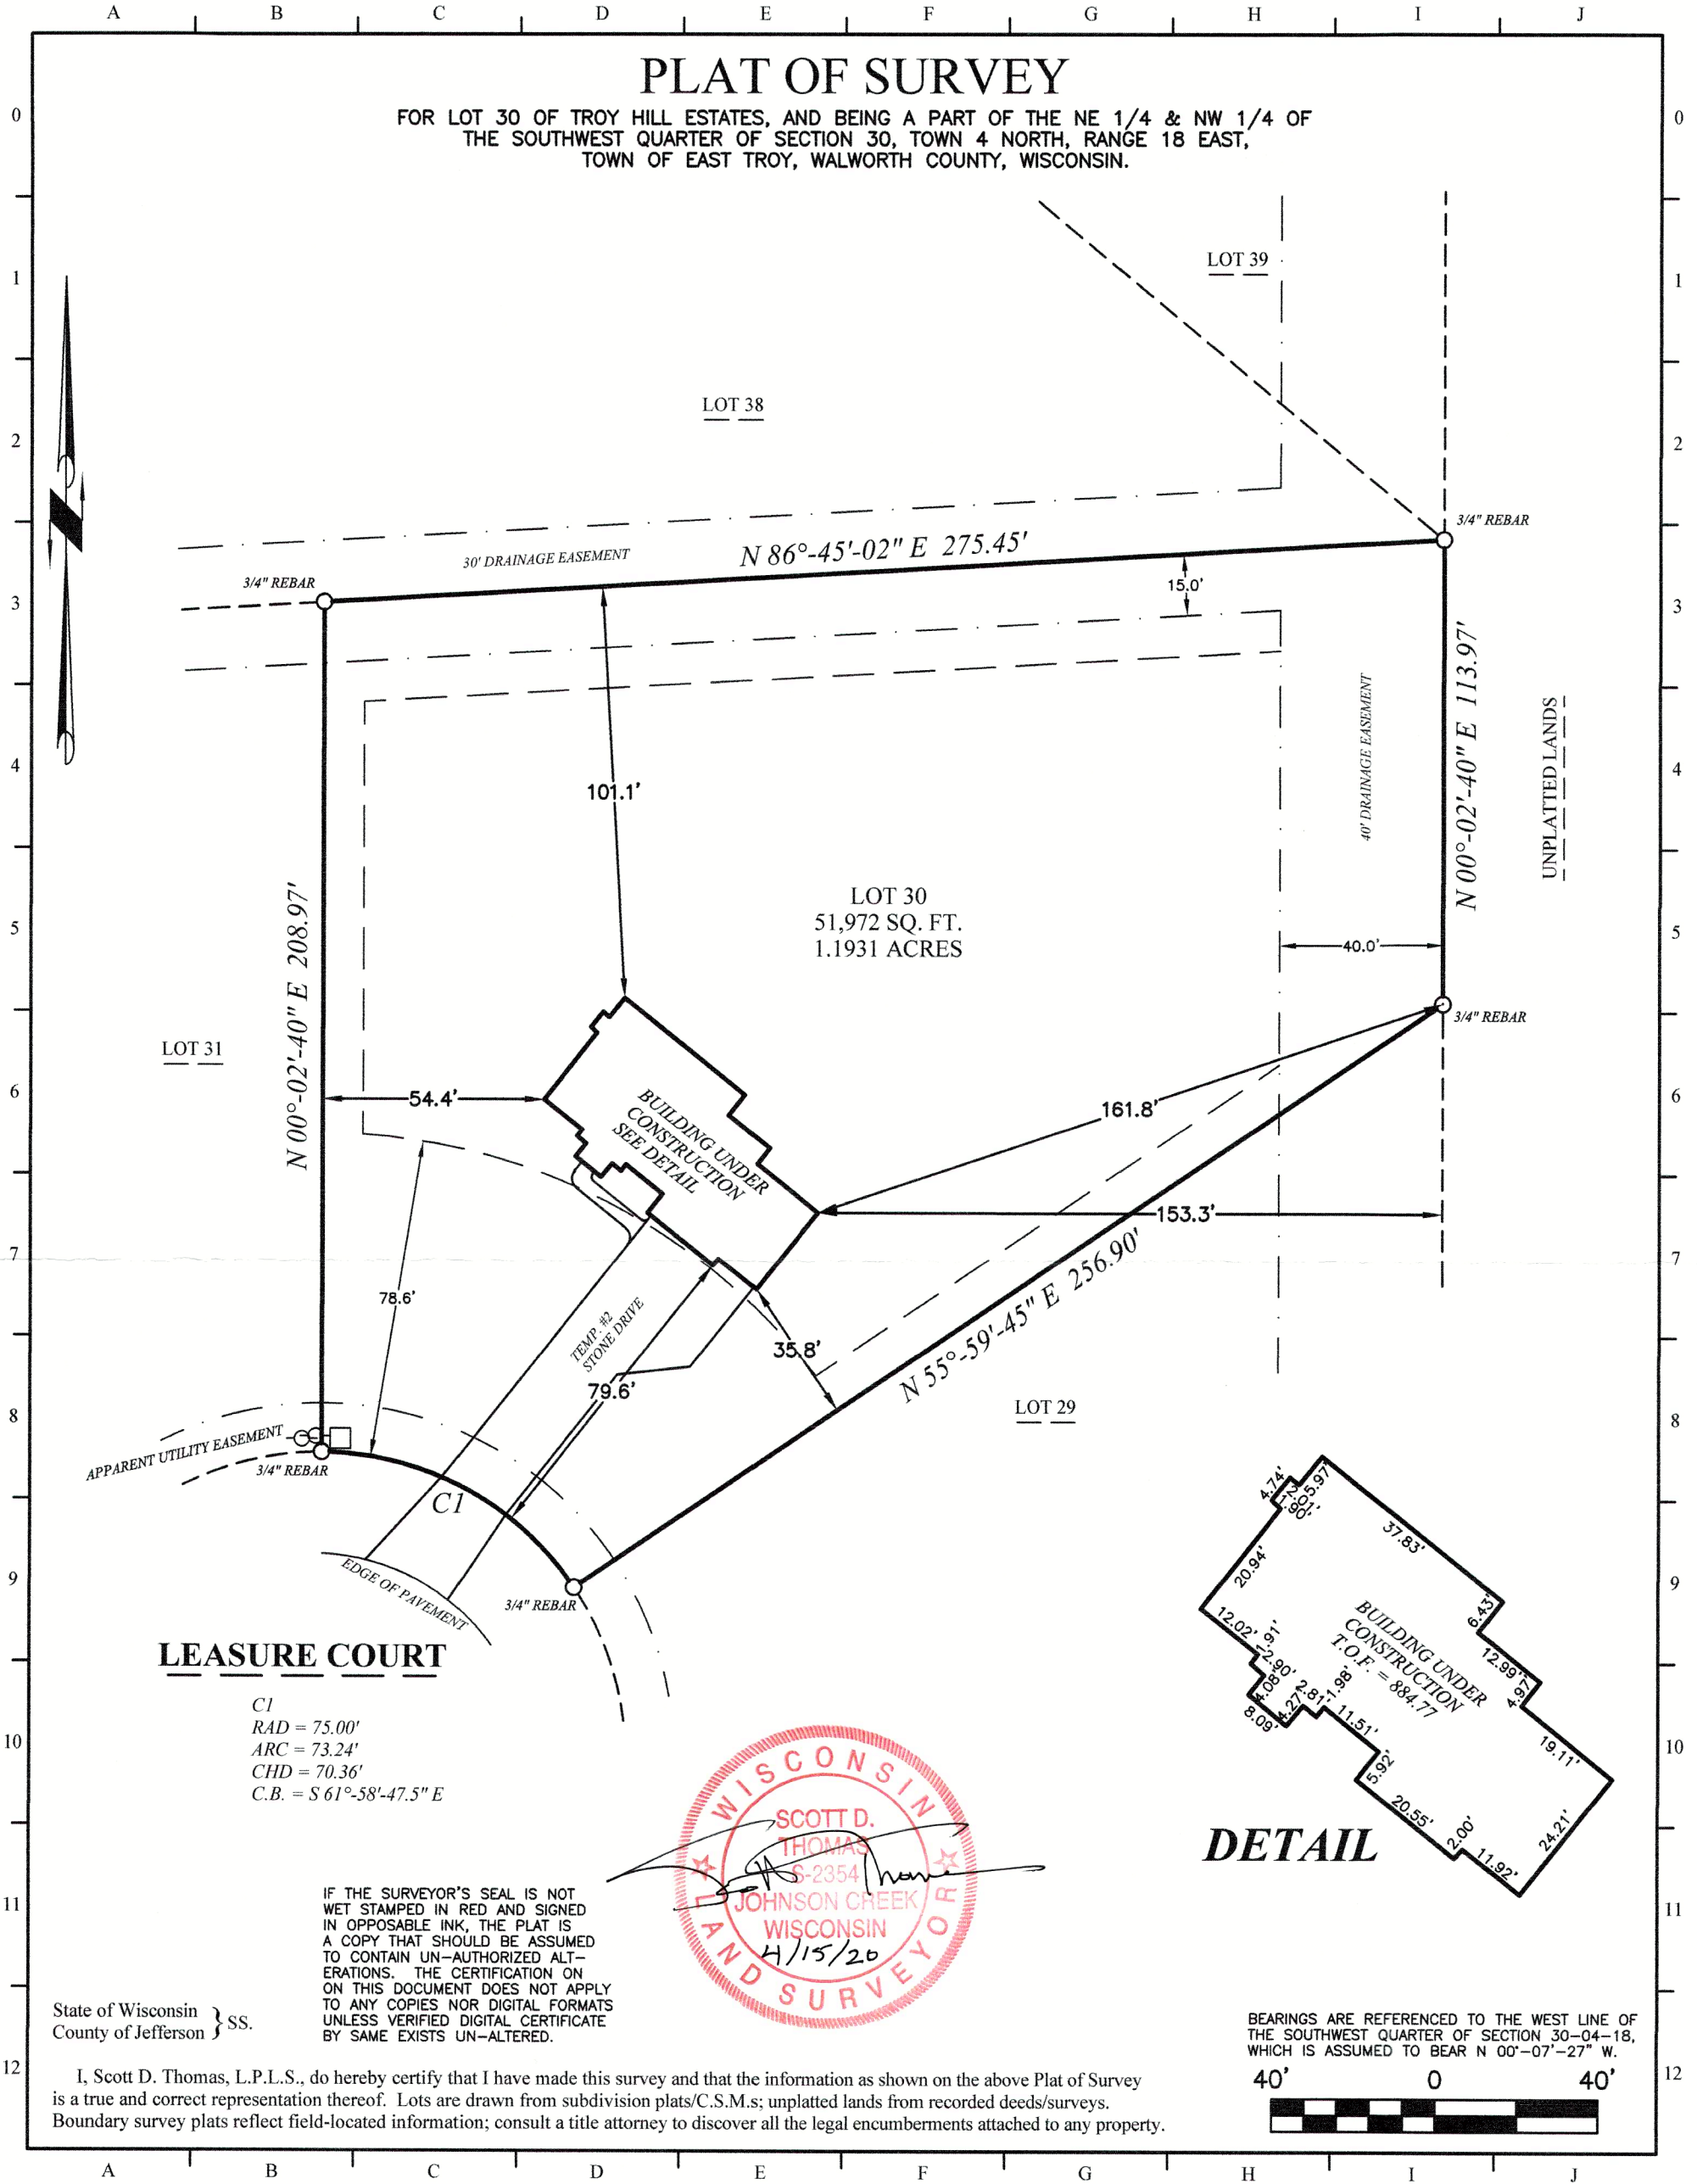

LEGEND: These standard symbols may be found in the drawing.

- Lot Corner (Found) w/desc.
- 18" X 3/4" Dia. Rebar (Set)
- Elec. Trans. Box
- ⊕ Man Hole
- Utility Pedestal
- Catch Basin
- Easement Boundary
- Setback Line

PROJECT: 999-146  
BUILDER: Halen Homes  
N27 W24025 Paul Court  
Suite 200  
Pewaukee, WI 53072  
Ph: (414) 219-0740  
Fax: (880) 918-3603

418-2971

PTHE-30