

DETAIL 'A' SCALE: 1" = 30'

NOTE: INSERTS ARE NOT DRAWN TO SCALE

PLAT OF SURVEY OF


TWO PARCELS OF LAND LOCATED IN THE SOUTHWEST 1/4 OF SECTION 36, T 4 N, R 18 E, WALWORTH COUNTY, WISCONSIN DESCRIBED AS FOLLOWS:

PARCEL A: BEGINNING AT THE WEST 1/4 CORNER OF SAID SECTION 36; THENCE S 89°54'55" E 1419.00 FEET ALONG THE EAST-WEST 1/4 LINE OF SAID SECTION 36; THENCE SOUTH 200.00 FEET; THENCE S 33°08'25" W 2184.92 FEET TO THE CENTERLINE OF HONEY CREEK ROAD; THENCE N 33°44'05" W 165.26 FEET ALONG SAID CENTERLINE; THENCE N 31°26'55" W 254.46 FEET ALONG SAID CENTERLINE TO THE WEST LINE OF THE SOUTHWEST 1/4 OF SAID SECTION 36; THENCE NORTH 1677.09 FEET ALONG THE WEST LINE OF THE SOUTHWEST 1/4 OF SAID SECTION 36 TO THE WEST 1/4 CORNER OF SAID SECTION 36 AND THE PLACE OF BEGINNING. CONTAINING 40.17 ACRES.

PARCEL B: COMMENCING AT THE WEST 1/4 CORNER OF SAID SECTION 36; THENCE S 89°54'55" E 1419.00 FEET ALONG THE EAST-WEST 1/4 LINE OF SAID SECTION 36; THENCE SOUTH 200.00 FEET TO THE PLACE OF BEGINNING; THENCE CONTINUE SOUTH 1120.00 FEET; THENCE N 89°54'55" W 143.88 FEET; THENCE S 38°28'35" W 1221.49 FEET TO THE CENTERLINE OF HONEY CREEK ROAD; THENCE N 33°44'05" W 400.00 FEET ALONG SAID CENTERLINE; THENCE N 33°08'25" E 2184.92 FEET TO THE PLACE OF BEGINNING. CONTAINING 20.00 ACRES. RESERVING A STRIP OF LAND 25.08 FEET WIDE AND 318.12 FEET LONG, SO LAID OUT AS TO COVER A SPRING AND THE OUTLET THEREOF, SITUATED NEAR THE SOUTHEAST PART OF THE ABOVE DESCRIBED PREMISES.

NOTE: BEARING ON THE WEST LINE OF THE SOUTHWEST 1/4 OF SAID SECTION 36 ASSUMED NORTH AS SHOWN ON PREVIOUS SURVEY RECORDS.


OWNER WILLIAM MEYER

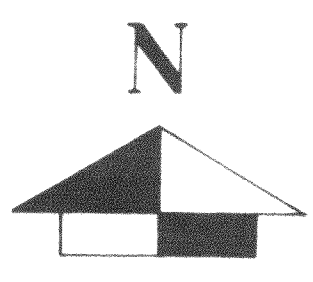

SCALE: 1" = 200'

LEGEND

- - IRON PIPE FOUND
- - IRON PIPE PLACED
- - STONE MONUMENT FOUND
- - BRASS CAPPED MONUMENT FOUND
- () - AS RECORDED
- ⊗ - RAILROAD SPIKE FOUND
- X- - FENCE

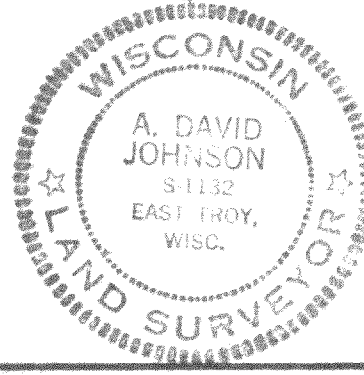

A. David Johnson
 A. DAVID JOHNSON
 WISCONSIN REGISTERED LAND SURVEYOR, S-1132
 DATE FEBRUARY 25, 1977