


418-324

LAND SURVEYORS

DESCRIPTION: Lot 9, Island Club, being a subdivision located in the Northwest Quarter of the Southwest Quarter and the Northeast Quarter of the Southwest Quarter and the Southeast Quarter of the Southwest Quarter and the Southwest Quarter of the Southwest Quarter of Section 4, Township 4 North, Range 18 East, Town of East Troy, Walworth County, Wisconsin.

Scale: $1" = 50'$

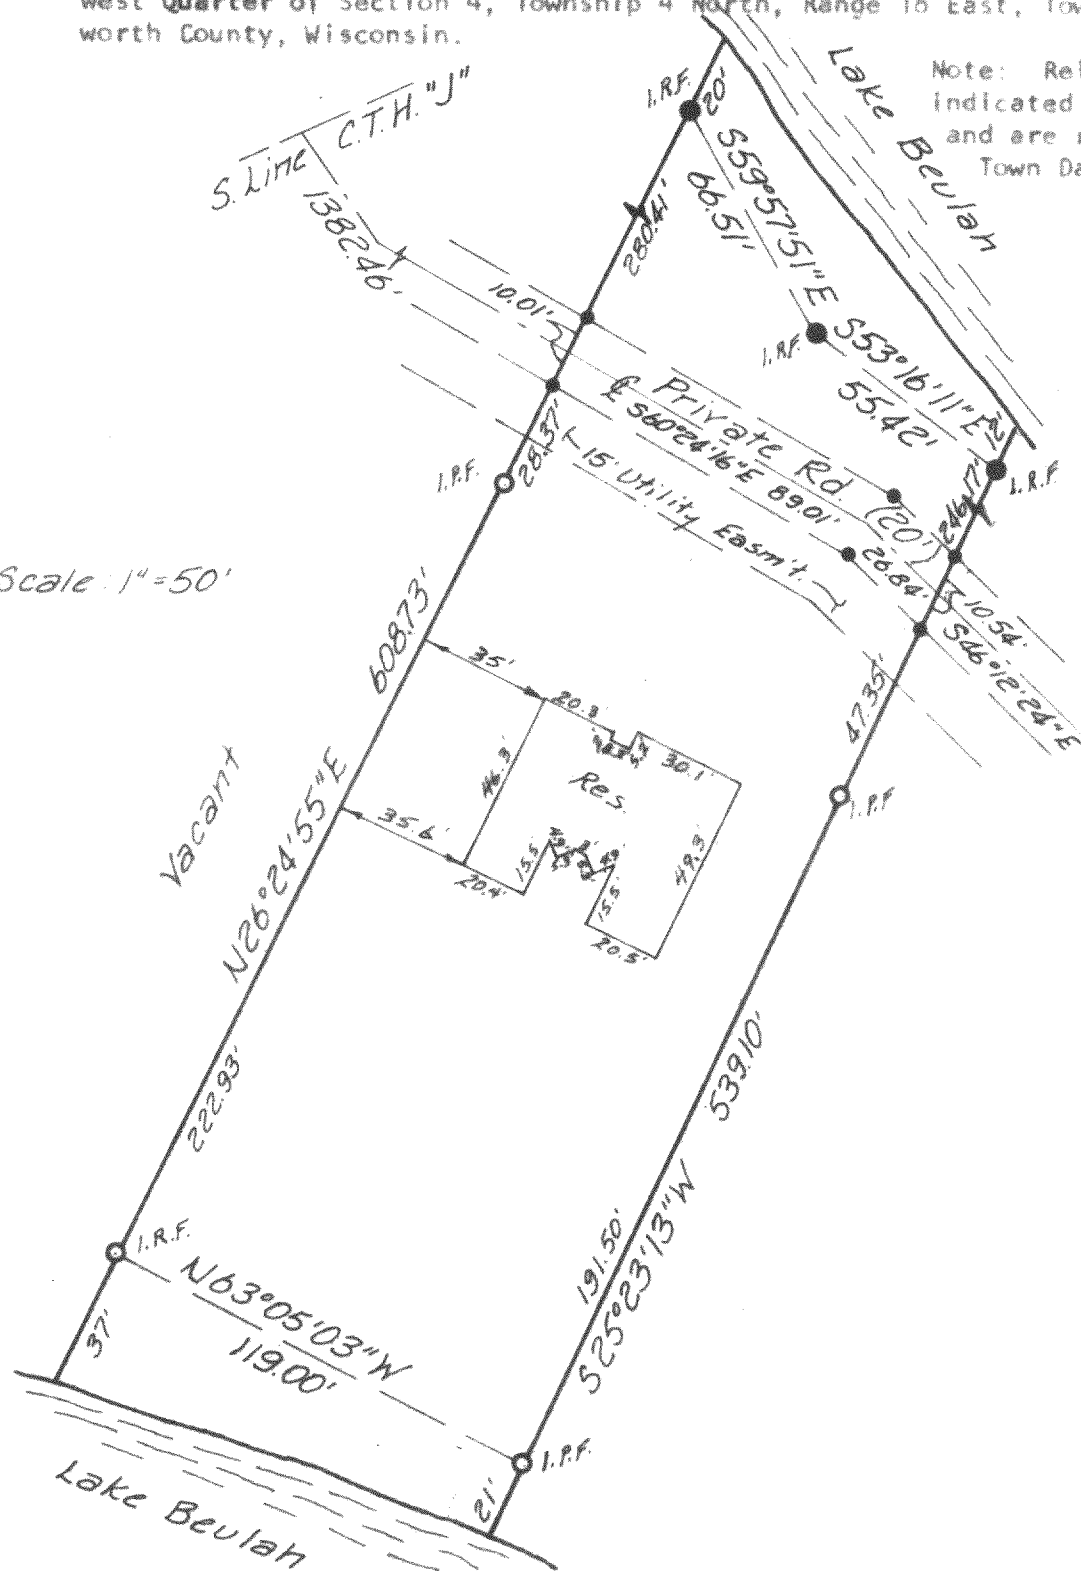

NOT VALID
UNLESS SEAL
IS IMPRESSED
HERE.

PHONE: 414-782-8799

21-9