
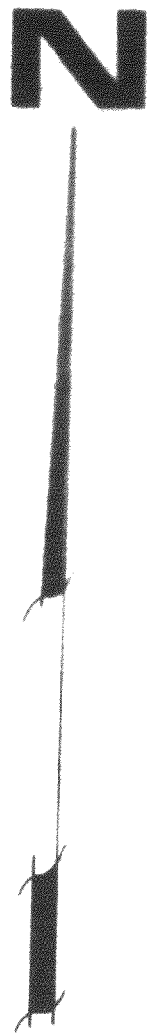


PLAT OF SURVEY

DESCRIPTION: LOT 1 OF CERT SURVEY MAP NO 58
PART OF N.W. 1/4 SEC. 9 T.4 N. R.18 E.
TOWN OF EAST TROY WALWORTH CO
WISCONSIN

CLIENT: WOLLENHAUP

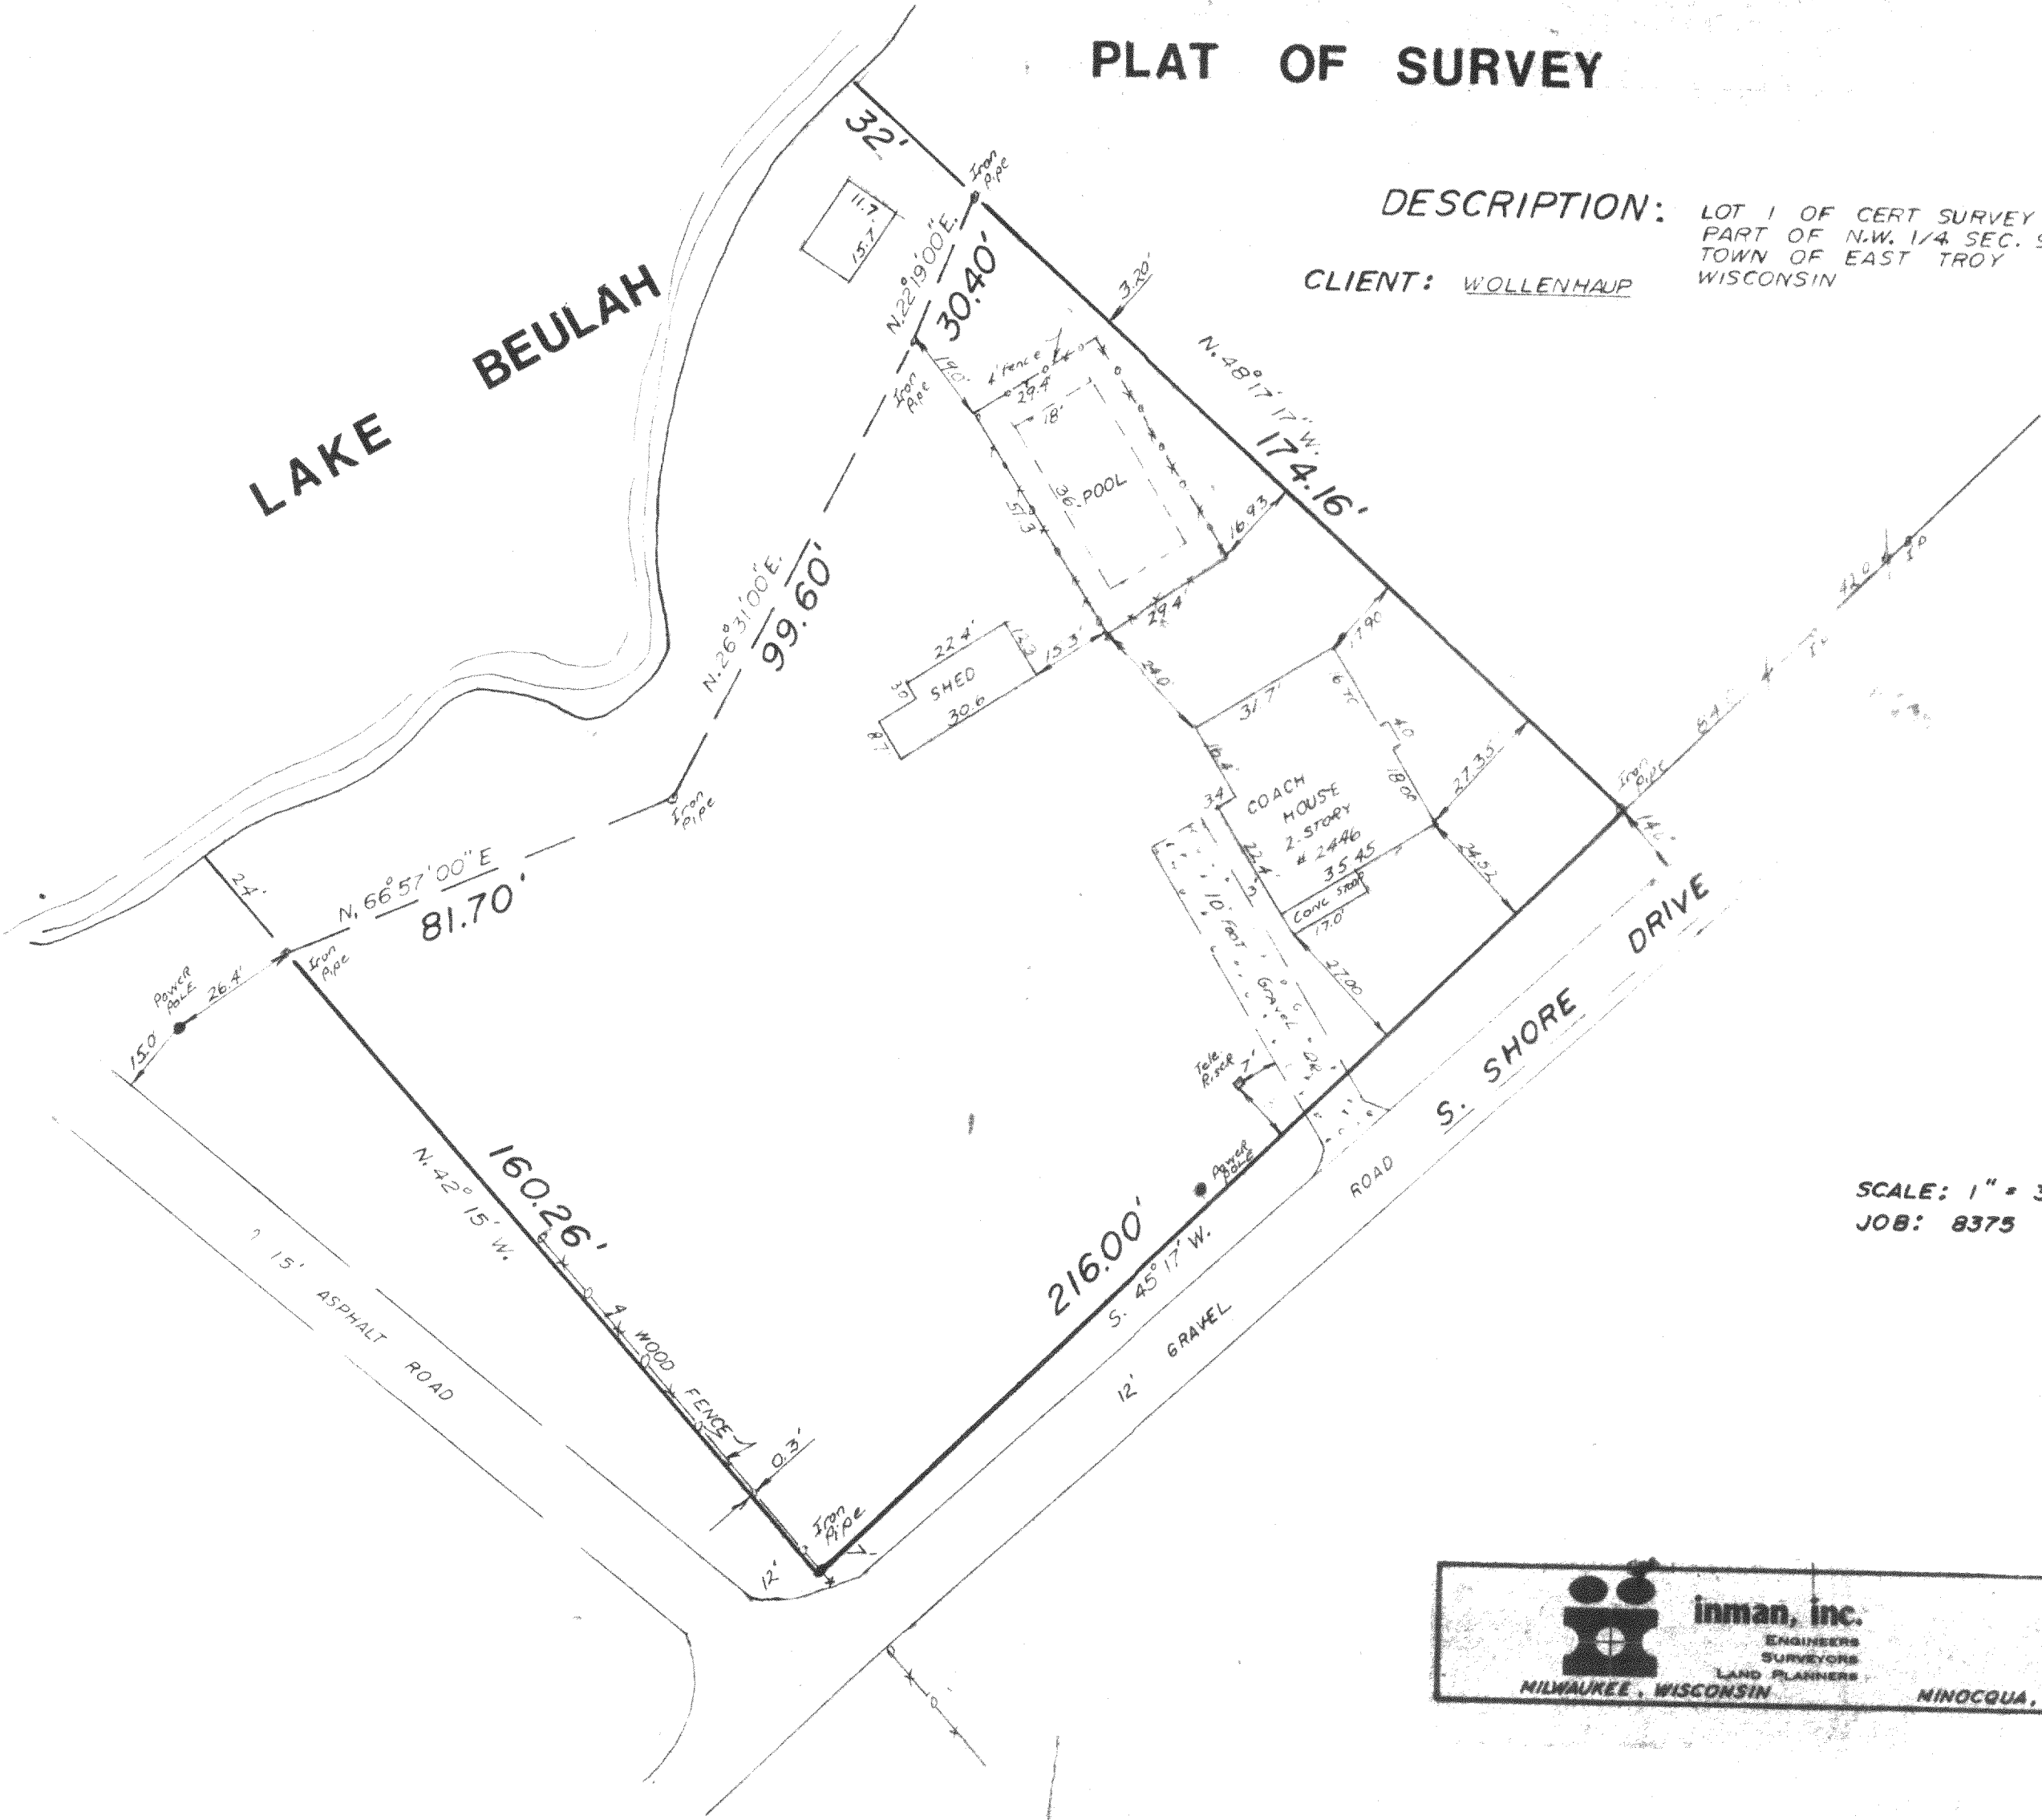

SCALE: 1" = 30'
JOB: 8375



inman, inc.
ENGINEERS
SURVEYORS
LAND PLANNERS

MILWAUKEE, WISCONSIN MINOCQUA, WISCONSIN

SURVEY CERTIFICATE

State of Wisconsin) ss I certify that I have surveyed the above described (property) and the above map is a true
Milwaukee County) representation thereof and shows the size and location of the Property, its exterior boundaries, the location and
dimensions of all visible structures thereon, fences, apparent easements and roadways and visible encroach-
ments, if any.

This survey is made for the exclusive use of the present owners of the Property, and also those who purchase,
mortgage, or guarantee the title thereto within one (1) year from date hereof;

Thomas Inman
THOMAS INMAN, Registered Land Surveyor

418-414-T