


PLAT OF SURVEY

LOTS 24 and 25, BLOCK 8, MIRAMAR SUBDIVISION (ON POTTER LAKE), being a part of Section 10 and 11, Town 4 North, Range 18 East, in the Town of East Troy, Walworth County, Wisconsin.

Survey location: 1003 Maple Street Buyer: Craig & Sandra Bronikowski

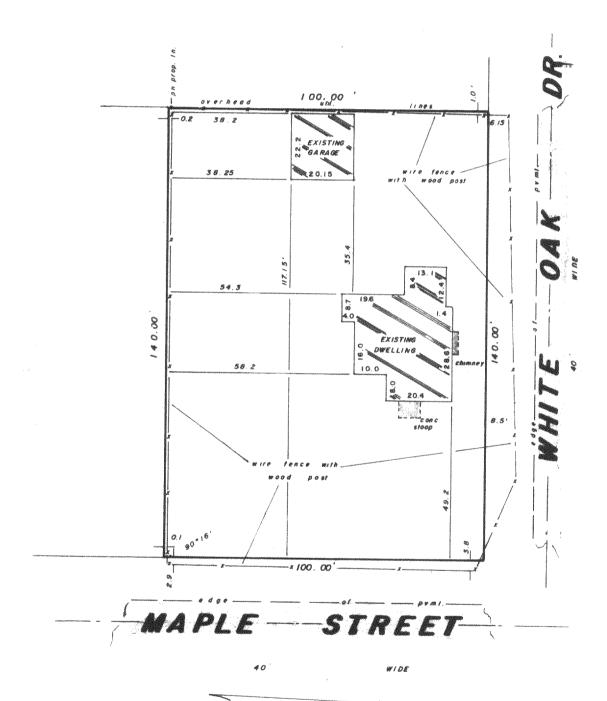

Surveyed for: WAUWATOSA MORT. CORP

"I hereby certify that I have surveyed the above described property and that the above map is a true representation thereof and shows the size and location of the property, its exterior boundaries, the location of all visible structures and dimensions of all principal buildings thereon, boundary fences, apparent easements, roadways and encroachments, if any

"This survey is made for the use of the present owners of the property, and also those who purchase, mortgage, or guarantee the title thereto within one year from date hereof"

MONUMENTATION BY WRITTEN AGREEMENT WITH THE ABOVE NAMED CLIENT.

S C AL E 1" = 30

(HAS MEDICAL) BEEN WAIVED IN ACCORDANCE WITH A-E 5.01 (1) (b) OF THE WISCONSIN ADMINISTRATIVE CODE

FREDERICK W.
SHIBILISH
S-1154
MILWAUKEE
WIS

SURVEYOR

SURVEYOR

MILWAUKEE

SEPT. 14 1984 by W

by W d / f

m d n b, k

DRAWN BY

/k 5580 JOB NUMBER