


SURVEYING

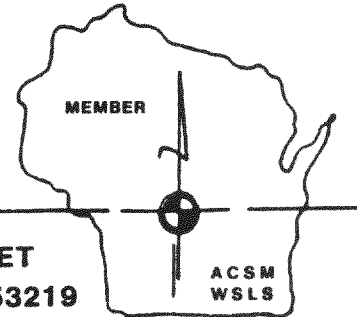

ASSOCIATES, INC.


2819 SOUTH 43rd STREET
MILWAUKEE, WISCONSIN 53219

FREDERICK W. SHIBILSKI RLS
(414) 321-5851

PLAT OF SURVEY
-of-

The Easterly 1/2 of LOT 114, except whatever portion of the South end as now used as Beulah Drive, as per plat of Beulah Heights, recorded by the Register of Deeds in Volume 7 of Plats on pages 14, 15 & 16, being a Subdivision of a part of Sections 7, 8, 17 & 18, Town 4 North, Range 18 East, in the Village of East Troy, Walworth County, Wisconsin. Also a right-of-way 33 feet wide from Beulah Drive in said Beulah Heights in Westerly direction to the public highway. Also a right-of-way of the entire width and length of the canal connected with Lake Beulah and encircling the entire marsh lying in Sections 7, 8, 17 & 18, Town 4 North, Range 18 East; No piers or other projections permitted outside of the lines of the canal.

Survey location: 2872 Beulah Heights Road
Buyer: Lynne F. & George Gramza

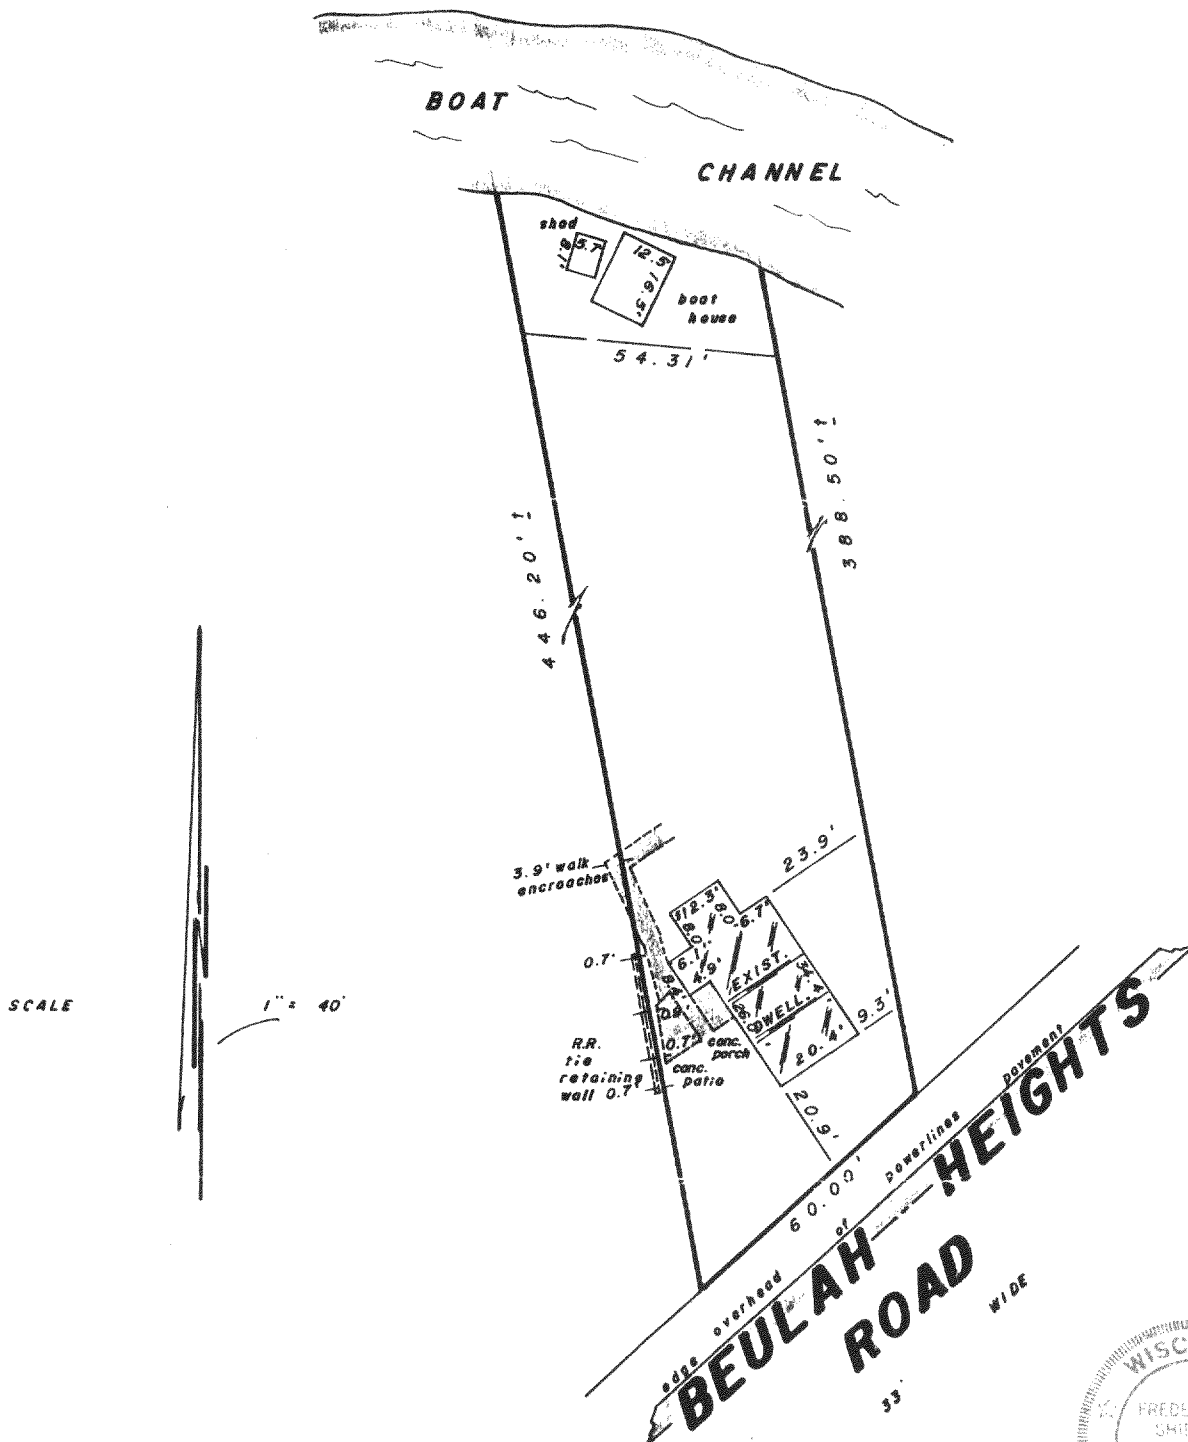

Surveyed for: SECURITY MORTGAGE CORP.

"I hereby certify that I have surveyed the above described property and that the above map is a true representation thereof and shows the size and location of the property, its exterior boundaries, the location of all visible structures and dimensions of all principal buildings thereon, boundary fences, apparent easements, roadways and encroachments, if any.

"This survey is made for the use of the present owners of the property, and also those who purchase, mortgage, or guarantee the title thereto within one year from date hereof."

MONUMENTATION BY WRITTEN AGREEMENT WITH THE ABOVE NAMED CLIENT (HAS BEEN) BEEN WAIVED IN ACCORDANCE WITH A-E 5.01 (1) (b) OF THE WISCONSIN ADMINISTRATIVE CODE



"THIS IS NOT AN ORIGINAL SURVEY UNLESS THIS SEAL IS RED."

Frederick W. Shibilski
WISCONSIN REGISTERED LAND SURVEYOR

JAN. 4, 1985
DATE

rth bju
FIELD WORK BY

mdn rth
DRAWN BY

6358
JOB NUMBER

PBN-9

418-4