

ASSOCIATES, INC.

WAUWATOSA, WISCONSIN 53226


FREDERICK W. SHIBILSKI RLS (414) 257-2212

PLAT OF SURVEY

LOTS 19, 20 and 21, ELOCK 8, MIRAMAR SUBDIVISION (on Potter Lake), being a part of Section 10 and 11, Township 4 North, Range 18 East, in the Town of East Troy, Walworth County, Wisconsin.

Survey location: 1021 Marle Street Buyer: Douglas & Jill Heuiser

ECEIV JUL 3 0 1086

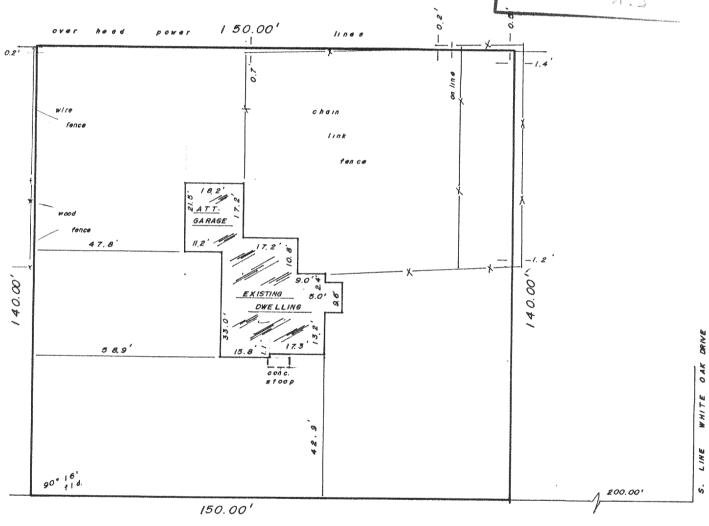

SCALE 30'

Surveyed for: WAUWATOSA MORTGAGE

"I hereby certify that I have surveyed the above described property and that the above map is a true representation thereof and shows the size and location of the property, its exterior boundaries, the location of all visible structures and dimensions of all principal buildings thereon, boundary fences, apparent easements, roadways and encroachments, if any.

"This survey is made for the use of the present owners of the property, and also those who purchase, mortgage, or guarantee the title thereto within one year from date hereof."

MONUMENTATION BY WRITTEN AGREEMENT WITH THE ABOVE NAMED CLIENT (HAS 400FF) BEEN WAIVED IN ACCORDANCE WITH A-E 5.01 (1) (b) OF THE WISCONSIN ADMINISTRATIVE CODE

WECONO,

"THIS IS NOT AN ORIGINAL SURVEY UNLESS THIS SEAL IS RED."

WISCONSIN REGISTERED LAND SURVEYOR JAN. 30, 1986 t a p 10217 FIELD WORK BY DATE DRAWN BY JOB NUMBER