
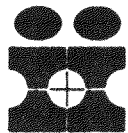


# Plat of Survey

PARCEL 6

Survey For: SAWYERS  
Location: Stringers Bridge Road

Description: All that part of the S.E. 1/4 of Section 18, T. 4 N., R. 18 E., in the Town of East Troy, Walworth County, Wisconsin, bounded and described as follows: Commencing at the South 1/4 corner of said Section 18; thence East along the south line of the Southeast 1/4 of said Section 18, 863.60 feet to a point; thence N. 01°21'55" E., 378.19 feet to the point of beginning of the lands to be described; thence Due West 677.42 feet to a point; thence N. 01°32'40" E., 97.23 feet to a point; thence Due West 185.00 feet to a point; thence N. 01°32'40" E., 202.79 feet to a point; thence Due East 861.48 feet to a point; thence S. 01°21'55" W., 300.00 feet to the point of beginning. Containing 5.52 acres.

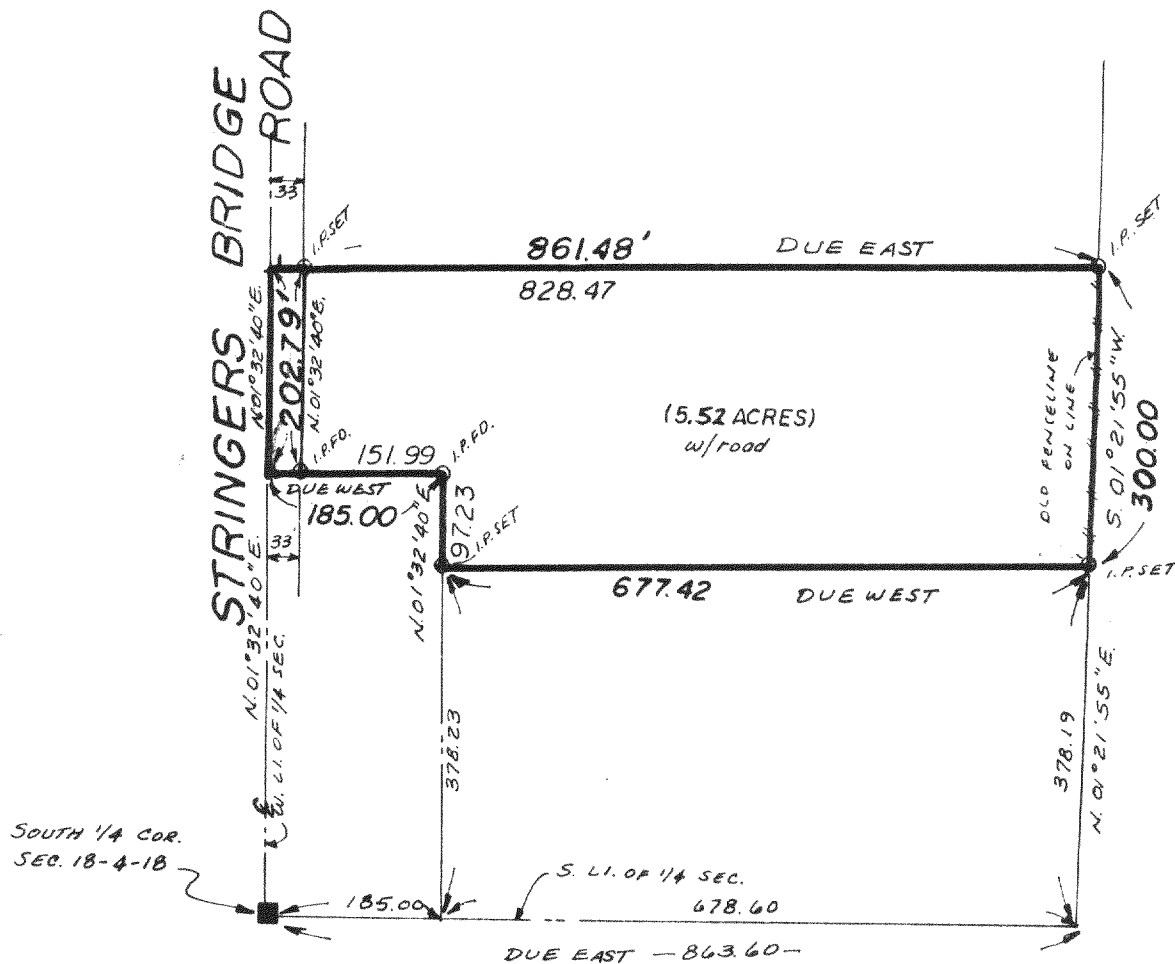

INMAN SURVEY

Scale: 1" = 200'

WEST OFFICE:  
P.O. BOX 286  
EAST TROY, WI 53120  
(414) 642-3113

EAST OFFICE:  
11221 W. FOREST HOME AVE.  
MILWAUKEE, WI 53130  
(414) 425-2060

## SURVEY CERTIFICATE

State of Wisconsin) ss  
Milwaukee County I certify that I have surveyed the above described (property) and the above map is a true representation thereof and shows the size and location of the Property, its exterior boundaries, the location and dimensions of all visible structures thereon, fences, apparent easements and roadways and visible encroachments, if any.

This survey is made for the exclusive use of the present owners of the Property, and also those who purchase, mortgage, or guarantee the title thereto within one (1) year from date hereof;

Thomas Inman  
THOMAS INMAN, Registered Land Surveyor

DATE: 12/29/82  
JOB NO.: 9742