PLAT OF SURVEY


LOCATION: 1621 S.T.H. 24, East Troy, Wisconsin

Lot 1 of CERTIFIED SURVEY MAP NO. 295, being a part of the NE 1/4 of LEGAL DESCRIPTION: Section 15, T 4 N, R 18 E, in the Town of East Troy, Walworth County,

Wisconsin.

May 25, 1983


Survey No. 59865

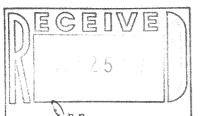

Drwg. Rev. 6/7/83

Recertification 2/20/87 355°52'09"W 155.00 NO SIZE OR COCATION 000 Ws METAL SHED 48.8 30.3 PORCH 4.92-CONC. BARN FOUNDATION 33.00 WOOD FENCE 8 2/6.00 35. N 56° 20' 00"E



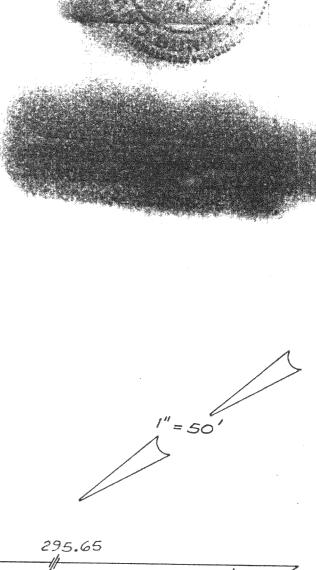

500 29'00". 2225.63 N/4 LINE SEC. 15

N/4 COR. SEC. 15,74N, RIBE

WE CERTIFY THAT WE HAVE SURVEYED THE ABOVE DESCRIBED PROPERTY, AND THE ABOVE MAP IS A TRUE REPRESENTATION THEREOF AND SHOWS THE SIZE AND LOCATION OF THE PROPERTY, ITS EXTERIOR BOUNDARIES, THE LOCATION AND DIMENSIONS OF ALL VISIBLE STRUCTURES THEREON, FENCES, APPARENT EASEMENTS, ROADWAYS AND VISIBLE ENCROACHMENTS.

201.97

S.T.H. #24

METROPOLITAN SURVEY SERVICE, INC.
REGISTERED LAND SURVEYORS

THIS SURVEY IS MADE FOR THE EXCLUSIVE USE OF THE PRESENT OWNERS OF THE PROPERTY; ALSO THOSE WHO PURCHASE, MORTGAGE OR GUARANTEE THE TITLE THERETO, WITHIN ONE YEAR FROM DATE HEREOF, AND TO THEM WARRANT THE ACCURACY OF SAID SURVEY AND MAP.

SIONED Pagne D. Mickelson