


Date October 2, 1986

PLAT OF SURVEY


Job No. Z-18-35184

LOT 7 AND THE SOUTH 20 FEET OF LOT 8 - BLOCK 1 - WILMER GROVE BEACH
lying and being in the East 1/2 of Section 18, Town 4 North, Range 18 East, Town of East Troy,
Walworth County, Wisconsin.

Located at 1516 Wilmer Grove

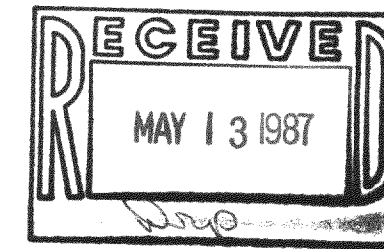

Owner: Douglas L. and Donn M. Anderson

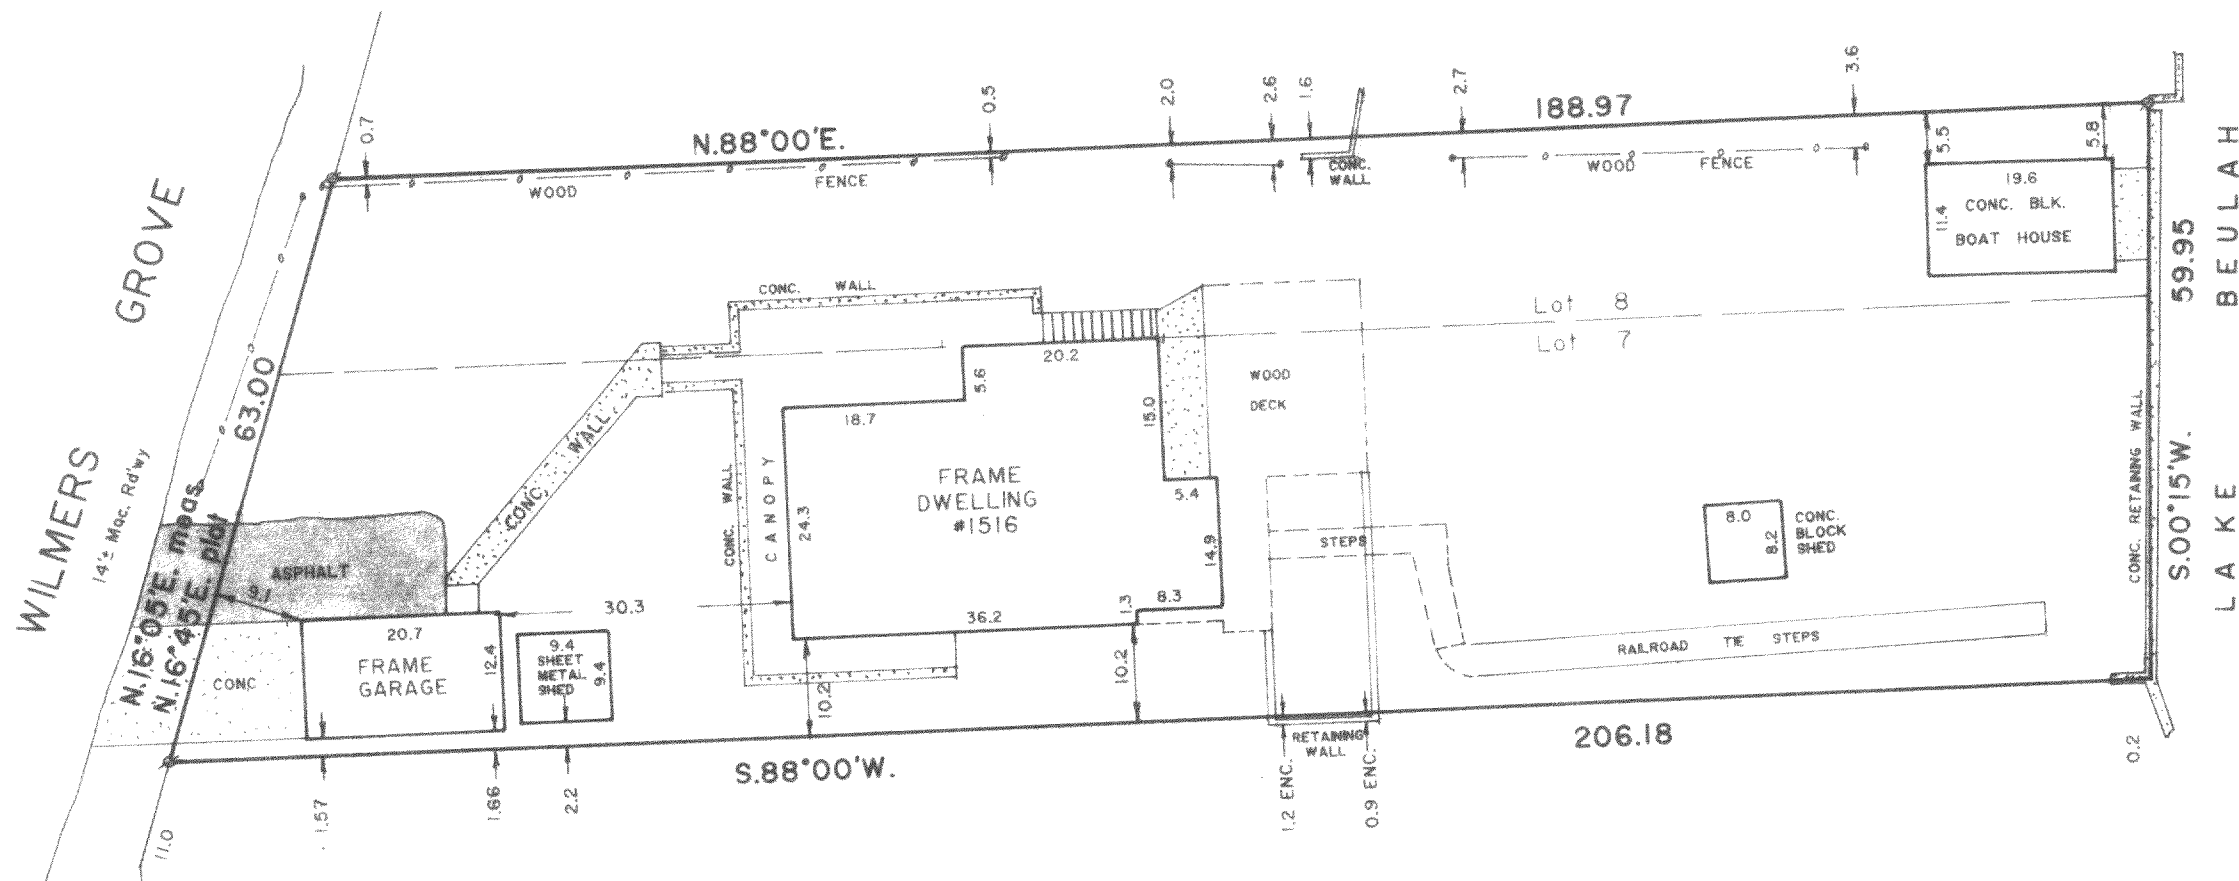

In accordance with Chapter A-E 5.01b
a signed agreement is on file waiving the
setting of monuments on the property.

o FOUND IRON PIPE
o SET IRON PIPE
8522 West Lisbon Avenue
Milwaukee, Wisconsin 53222

SURVEYED FOR

Landmark Credit Union
5100 W. Mitchell St.
Milwaukee, WI


LANDMARK SURVEYING CO.

I, Richard J. Lammi, surveyed the above described prop-
erty, and the above map is a true representation thereof
and shows the size and location of the property, its
exterior boundaries, the location and dimensions of
all visible structures thereon, fences, apparent ease-
ments, roadways and visible encroachments.

This survey is made for the exclusive use of the present
owners of the property; also those who purchase, mort-
gage or guarantee the title thereto, within one year
from date hereof.

Richard J. Lammi
REGISTERED LAND SURVEYOR NO. 5777 - STATE OF WISCONSIN

Scale 1"=20'
PHONE
461-3730

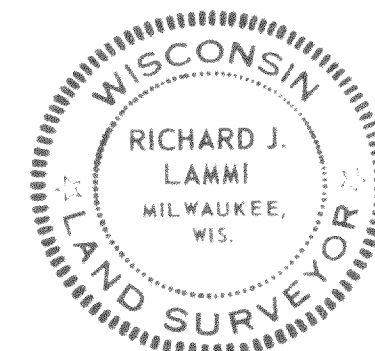

PW-7

418-566