

PLAT OF SURVEY  
OF

THE WESTERLY 71 FEET OF LOT 133 AND THE EASTERLY 19 FEET OF LOT 134 EXCEPT THAT PART OF THE EXTREME NORTH END OCCUPIED BY THE SAID ROAD CALLED BEULAH DRIVE, AS PER THE PLAT OF BEULAH HEIGHTS RECORDED BY THE REGISTER OF DEEDS IN VOL. 7 OF PLATS ON PAGES 14, 15 & 16 WAIMORTHE COUNTY, WIS CONSN. ALSO A RIGHT OF WAY 33 FEET WIDE FROM BEULAH DRIVE IN SAID BEULAH HEIGHTS IN A WESTERLY DIRECTION TO THE PUBLIC HIGHWAY. ALL OF SAID PROPERTY BEING LOCATED IN SAID BEULAH HEIGHTS SUBDIVISION OF PART OF SECTION 7, 8, 17 & 18, T. 4 N. R. 18 E.

FOR: PATRICK HEARDON

SCALE 1" = 20'

o = IRON PIPE STAKE SET.

o = IRON PIPE STAKE FOUND.



Δ = POWER POLE.

I have surveyed the above-described property, and the map hereon is a true representation thereof and shows the size and location of the property, its exterior boundaries, the location and dimensions of all visible structures thereon, fences, apparent easements and roadways and visible encroachments, if any.

This survey is made for the exclusive use of the present owners of the property, and also those who purchase, mortgage, or guarantee the title therein, within one year from date hereof.

Dated at Burlington, this 7th day of AUGUST, 1987

*John F. Dagen*  
John F. Dagen, Land Surveyor 8 242

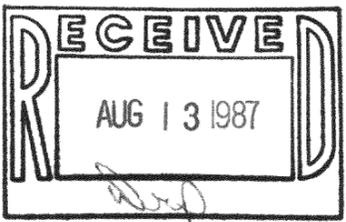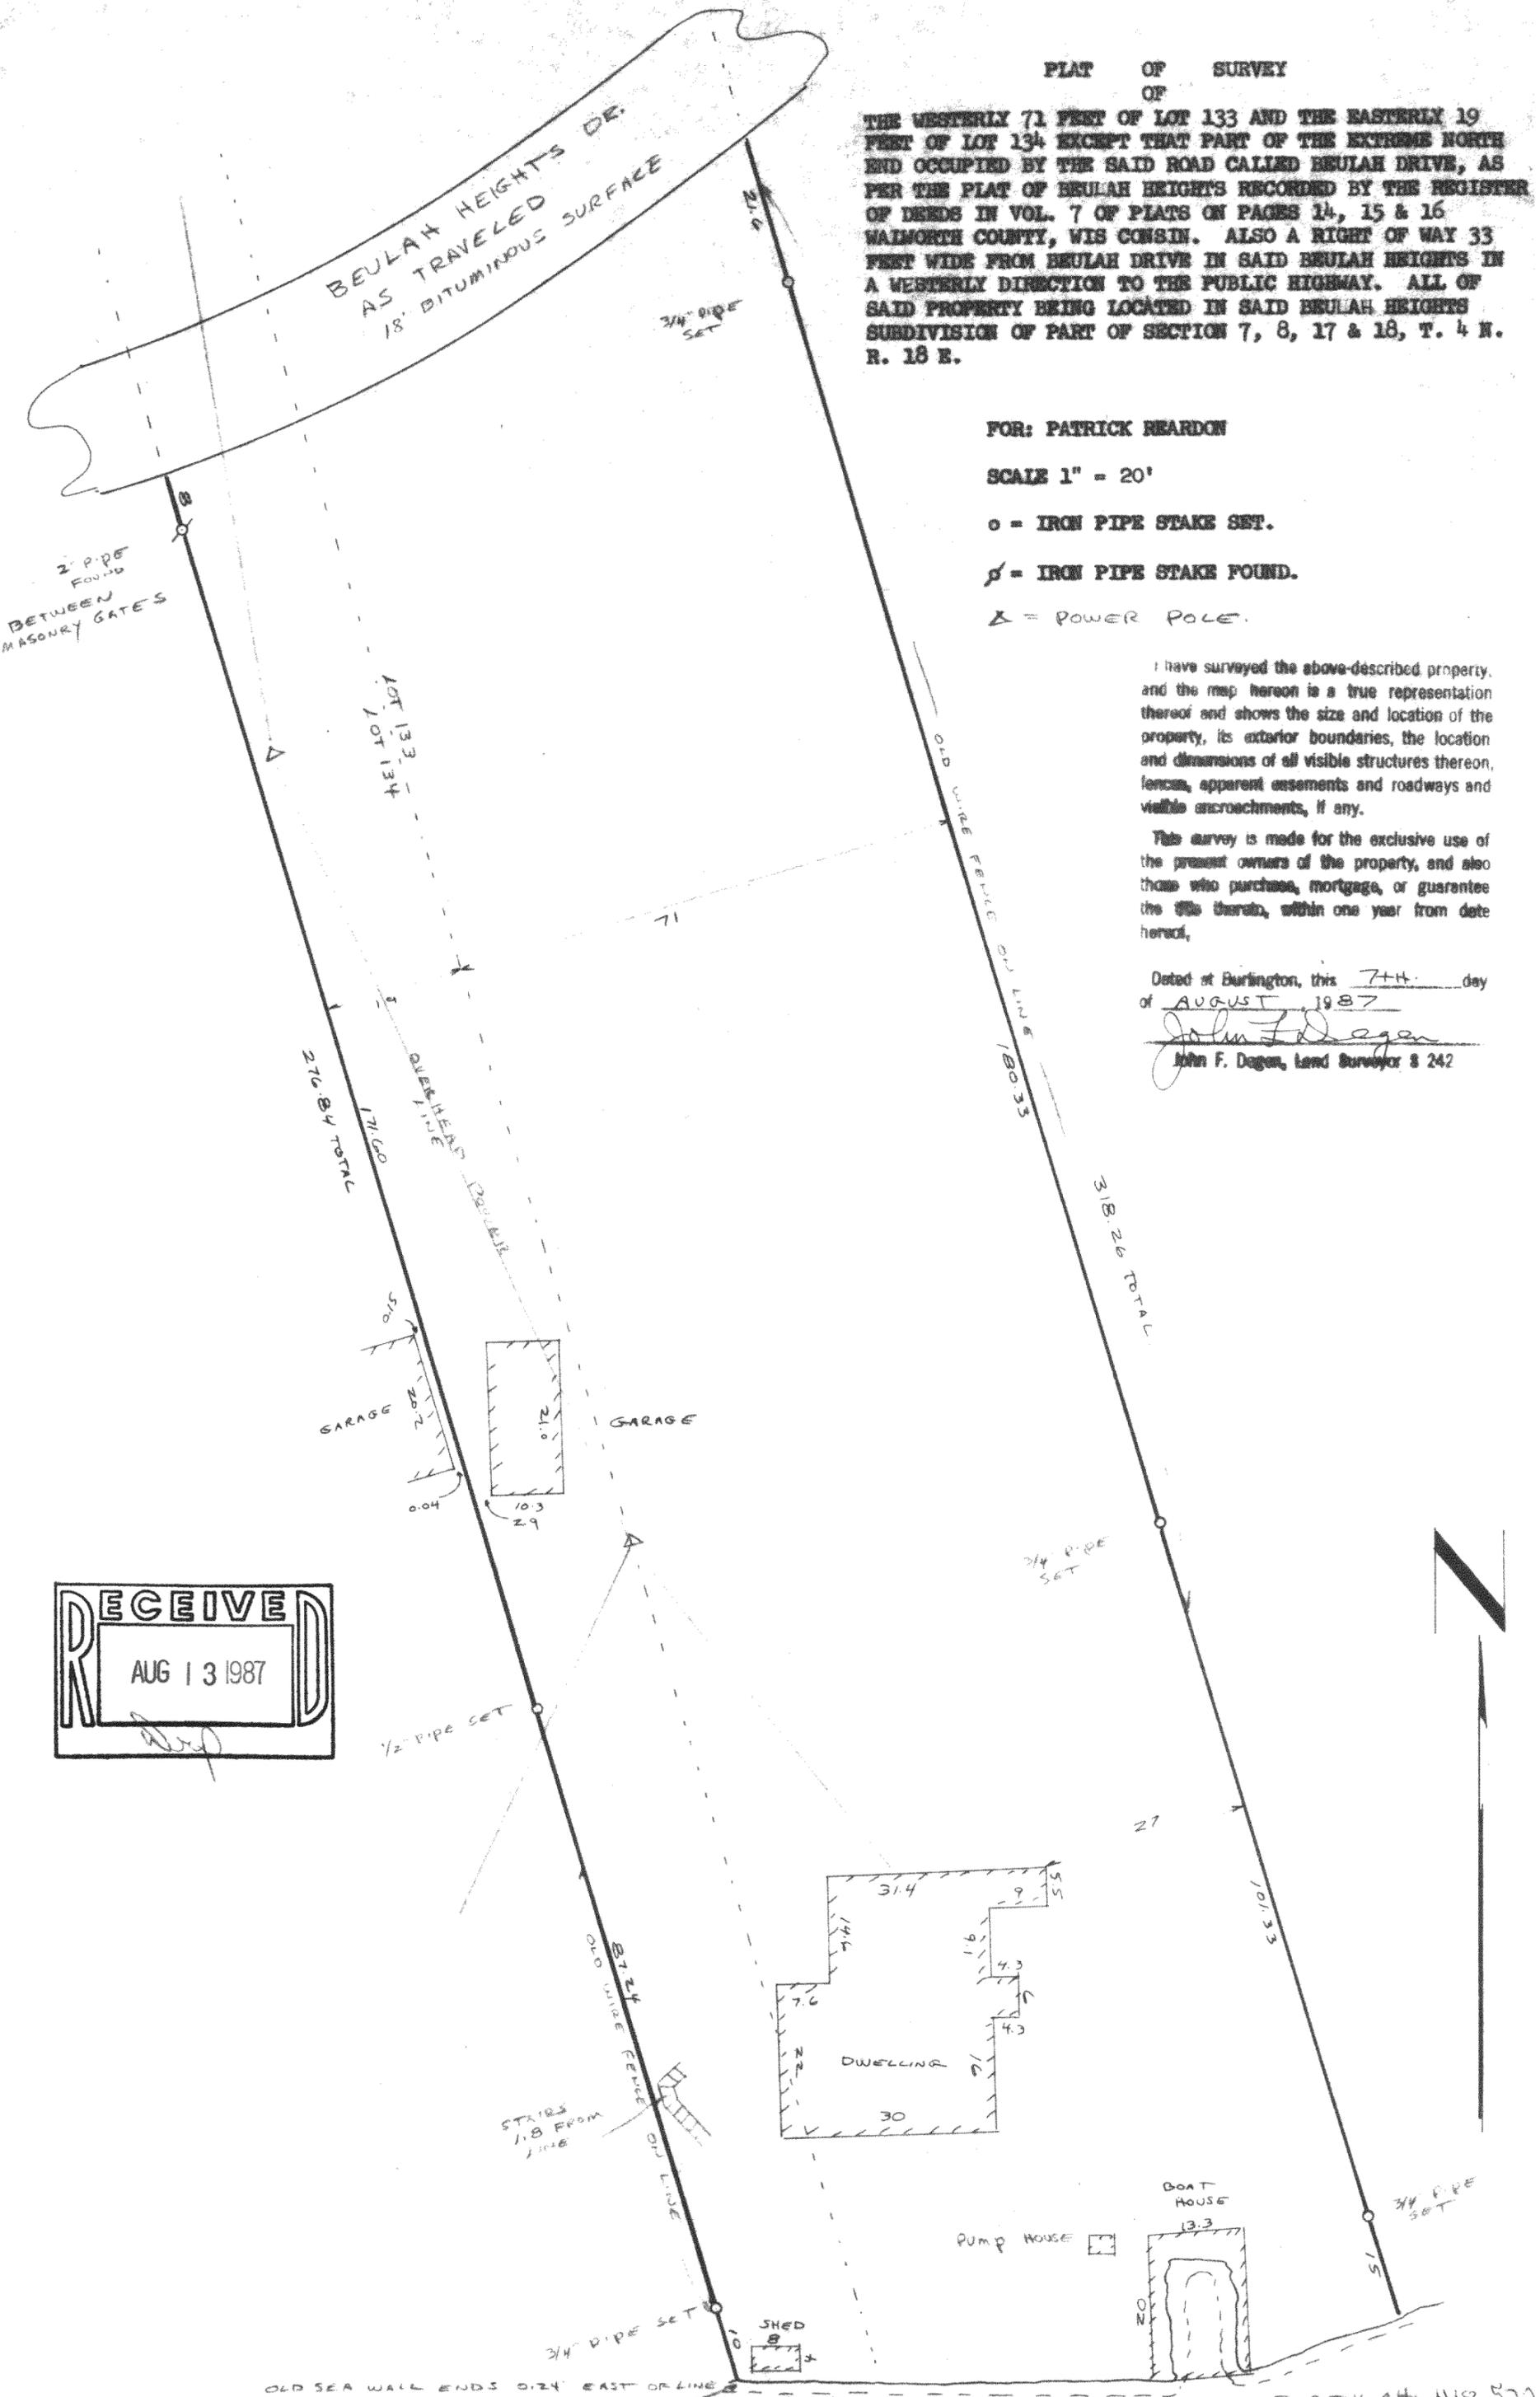

11-1-1  
PBH-17

LAKE BEULAH 418-572