

FARRIS, HANSEN & ASSOCIATES, INC.

7 RIDGEWAY COURT, P.O. BOX 487, ELKHORN, WISCONSIN

TEL. 414-723-2098

LOCATION: PART OF LOT 11 OF BEULAH LAKE PARK SUB.
IN SEC. 4, T.4N., R.18E., WALWORTH CO. WI.

MAP LEGEND

- = IRON PIPE STAKE FOUND
- = IRON PIPE STAKE SET
- = IRON NAIL STAKE FOUND
- = IRON ROD STAKE SET
- = CONCRETE MONUMENT FOUND

(XXXXX) = RECORD DIMENSION FROM PREVIOUS SURVEYS OF THIS PARCEL SEE COUNTY SURVEY REC. 418-30J




WORK ORDERED BY: RODERICK MANN



MAP SCALE IN FEET

LEGAL DESCRIPTION OF LAND SURVEYED:

Part of Lot 11 of Beulah Lake Park Subdivision, described as follows, to wit: Beginning at the Northwest corner of Lot 11, thence Southerly along the Westerly lot line 137 feet; thence S. 25°59' E. 75.15 feet; thence N. 68°48' E. 240.49 feet; thence N. 29° W. to the North line of said Lot 11; thence S. 87°30' W. 207.10 feet to the place of beginning, being in the Town of East Troy, Walworth County, Wisconsin.

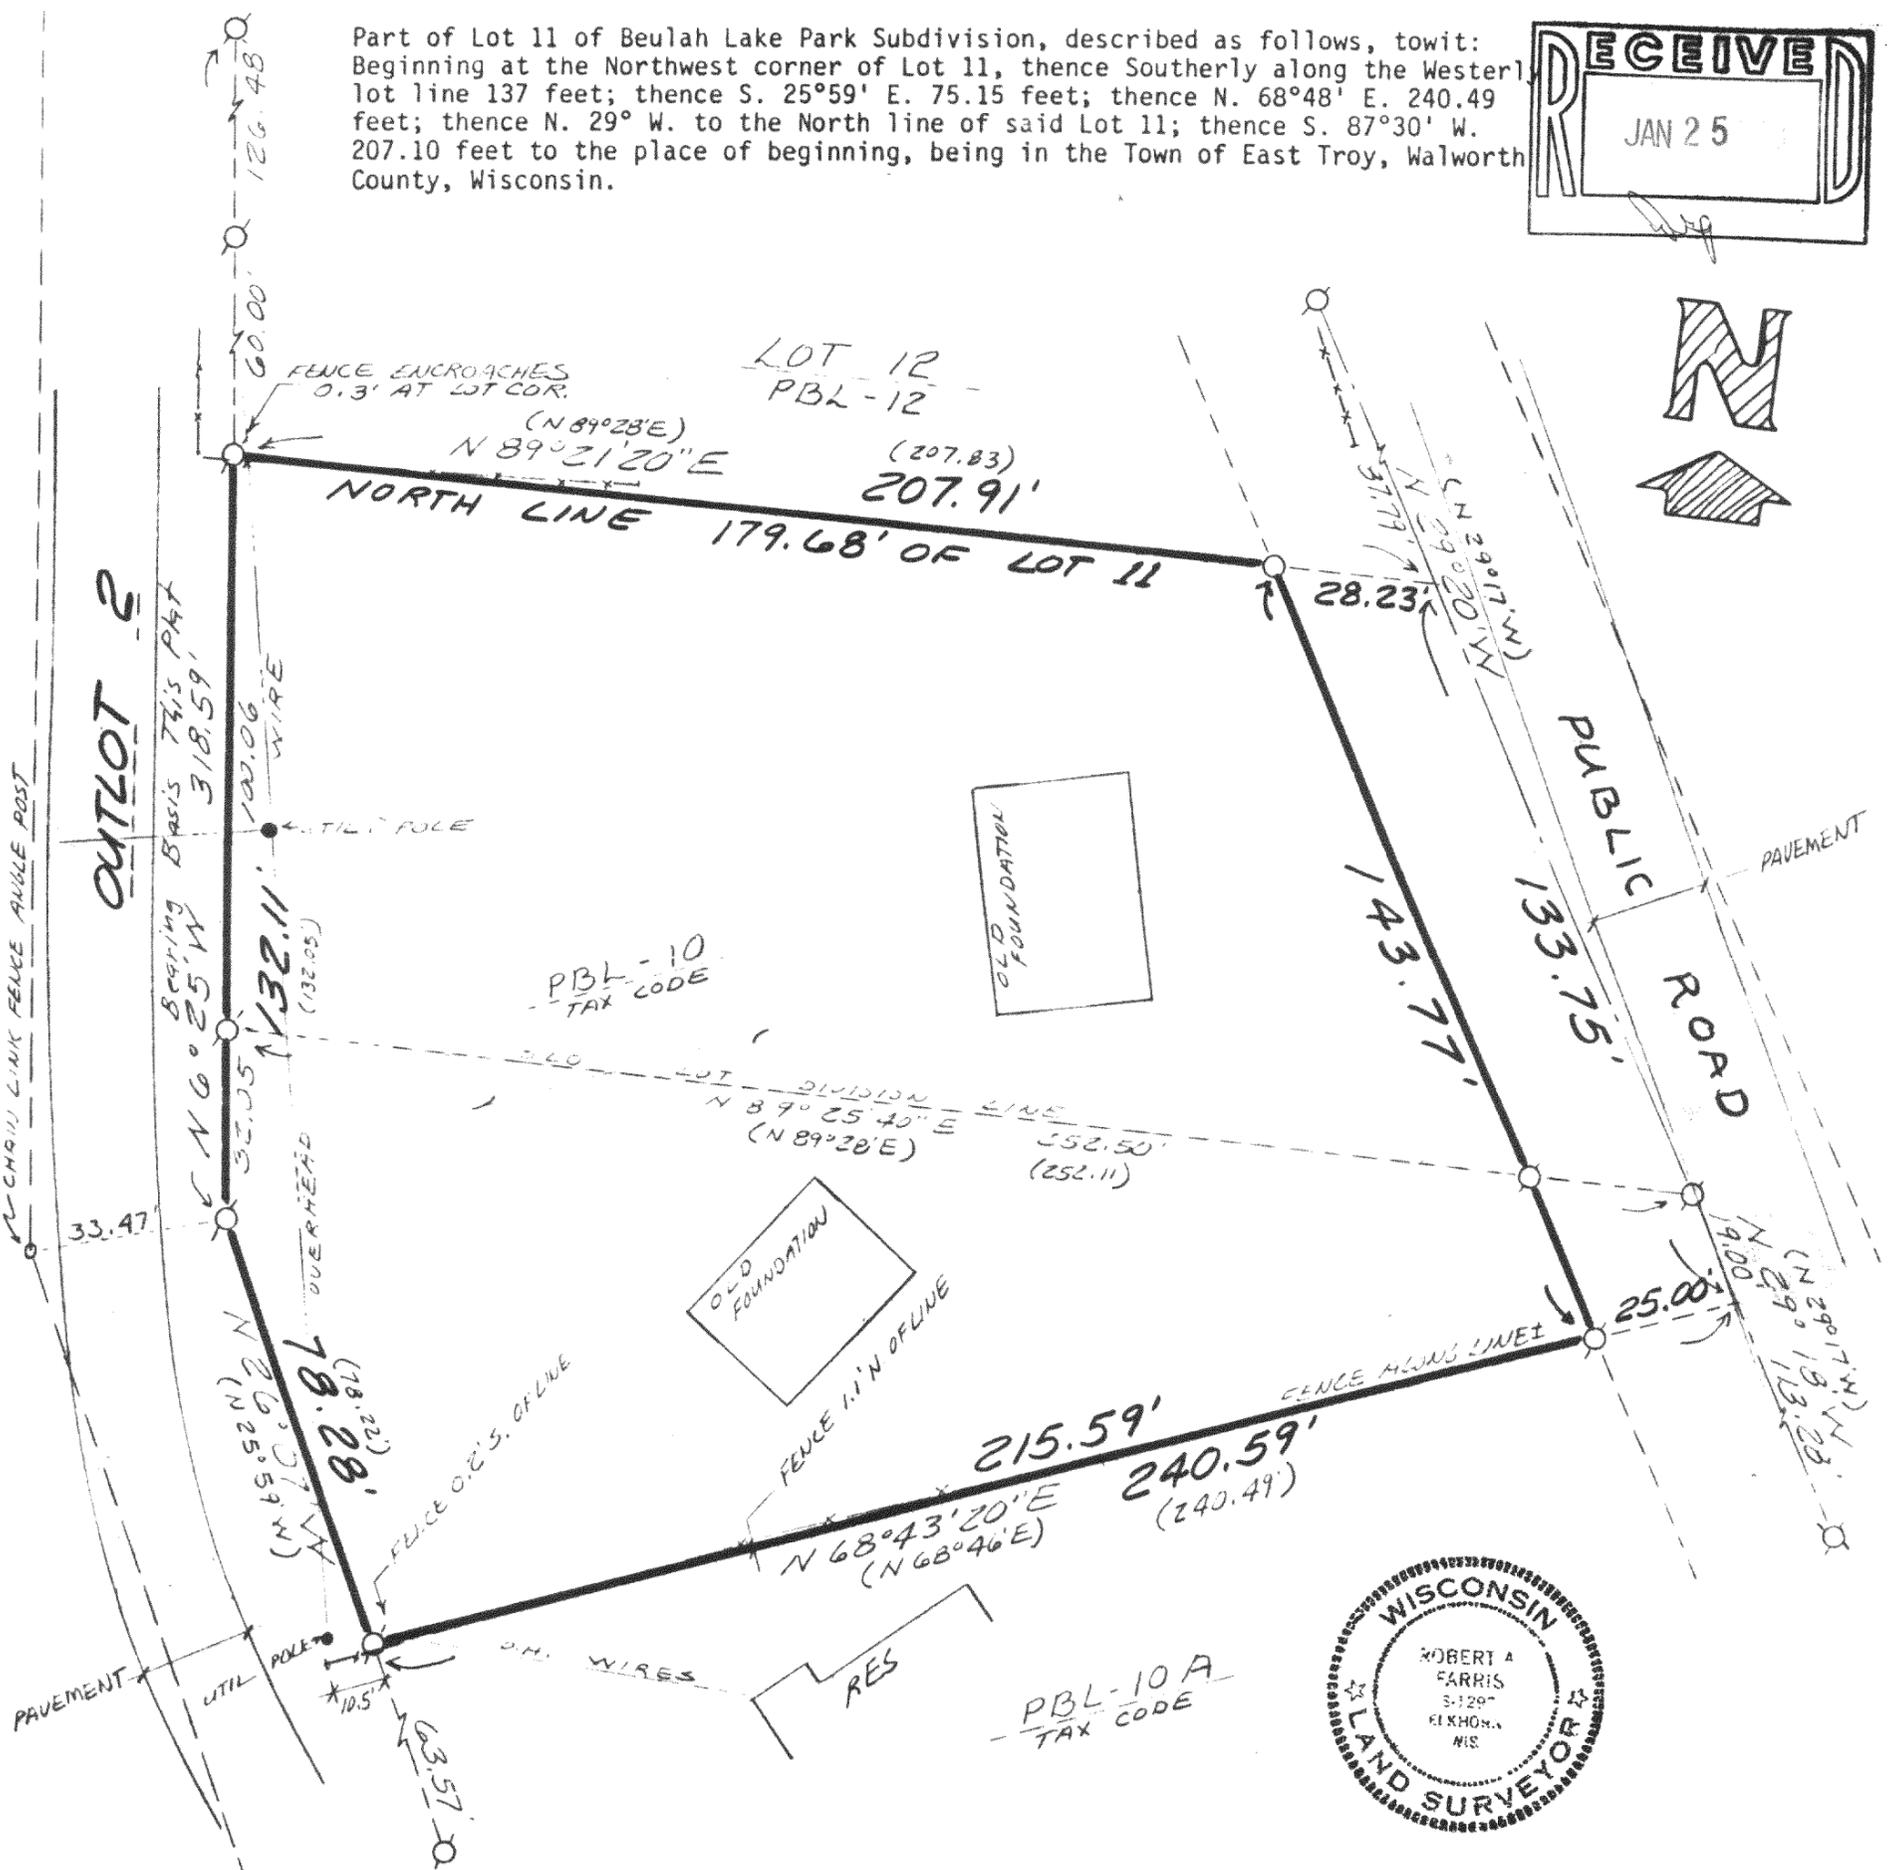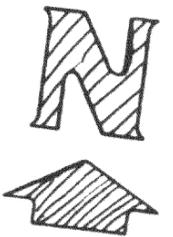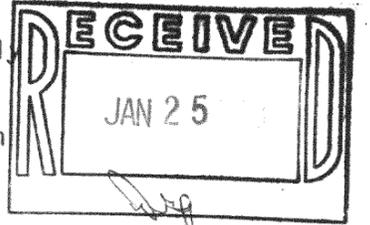

I hereby certify that the above described property has been surveyed under my direction and that the above map is a true representation thereof and shows the size and location of the property, its exterior boundaries, the location of all visible structures and dimensions of all principal buildings thereon, boundary fences, apparent easements, roadways and visible encroachments, if any. This survey is made for the use of the present owners of the property, and also those who purchase, mortgage, or guarantee the title thereto within one year from the date hereof.

DATED: NOV 20, 1987

Robert A. Farris

PROJ. NO. 2770