

LOT 6 AND THE NORTH 1/2 of LOT 7 - BLOCK 16 - MIRAMAR being a subdivision of a part of the East 1/2 of Section 10, and the West 1/2 of Section 11, Town 4 North, Range 18 East, Town of East Troy, Walworth County, Wisconsin.

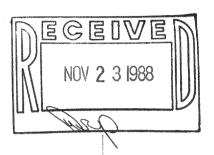

Located at 930 Pine Street

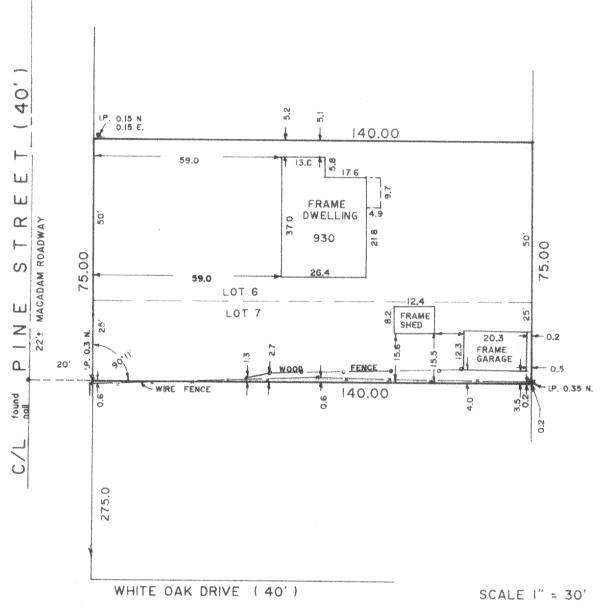

in accordance with Chapter A-E 5.01b a signed agreement is on file waiving the setting of manuments on the property.

Owners: Bruce and Roberta Meyers

- FOUND IRON PIPE

o - SET IRON PIPE

8522 West Lisbon Avenue Milwaukee, Wisconsin 53222

SURVEYED FOR

Lloyd Henry, Attorney P. O. Box 916 East Troy, WI 53120

LANDMARK SURVEYING CO.

I, Richard J. Lammi, surveyed the above described property, and the above map is a true representation thereof and shows the size and location of the property, its exterior boundaries, the location and dimensions of all visible structures thereon, fences, apparent easements, roadways and visible encroachments.

This survey is made for the exclusive use of the present owners of the property; also those who purchase, mortgage or guarantee the title thereto, within one year from date hereof.

RICHARD J.

PHONE

461-3730

REGISTERED LAND SURVEYOR MO. S-777 - STATE OF WISCONSIN

418-631

1881-8N1S