

Job No. 2-4-36621

Located at 2316 Highway J

LANDMARK SURVEYING CO.


This survey is made for the exclusive use of the present owners of the property; also those who purchase, mortgage or guarantee the title thereto, within one year from date hereof.

Edward J. Lane
REGISTERED LAND SURVEYOR NO. 277 - STATE OF WISCONSIN



WISCONSIN
RICHARD J. LAMMI
MILWAUKEE, WIS.
LAND SURVEYOR

RECEIVED
NOV 23 1988

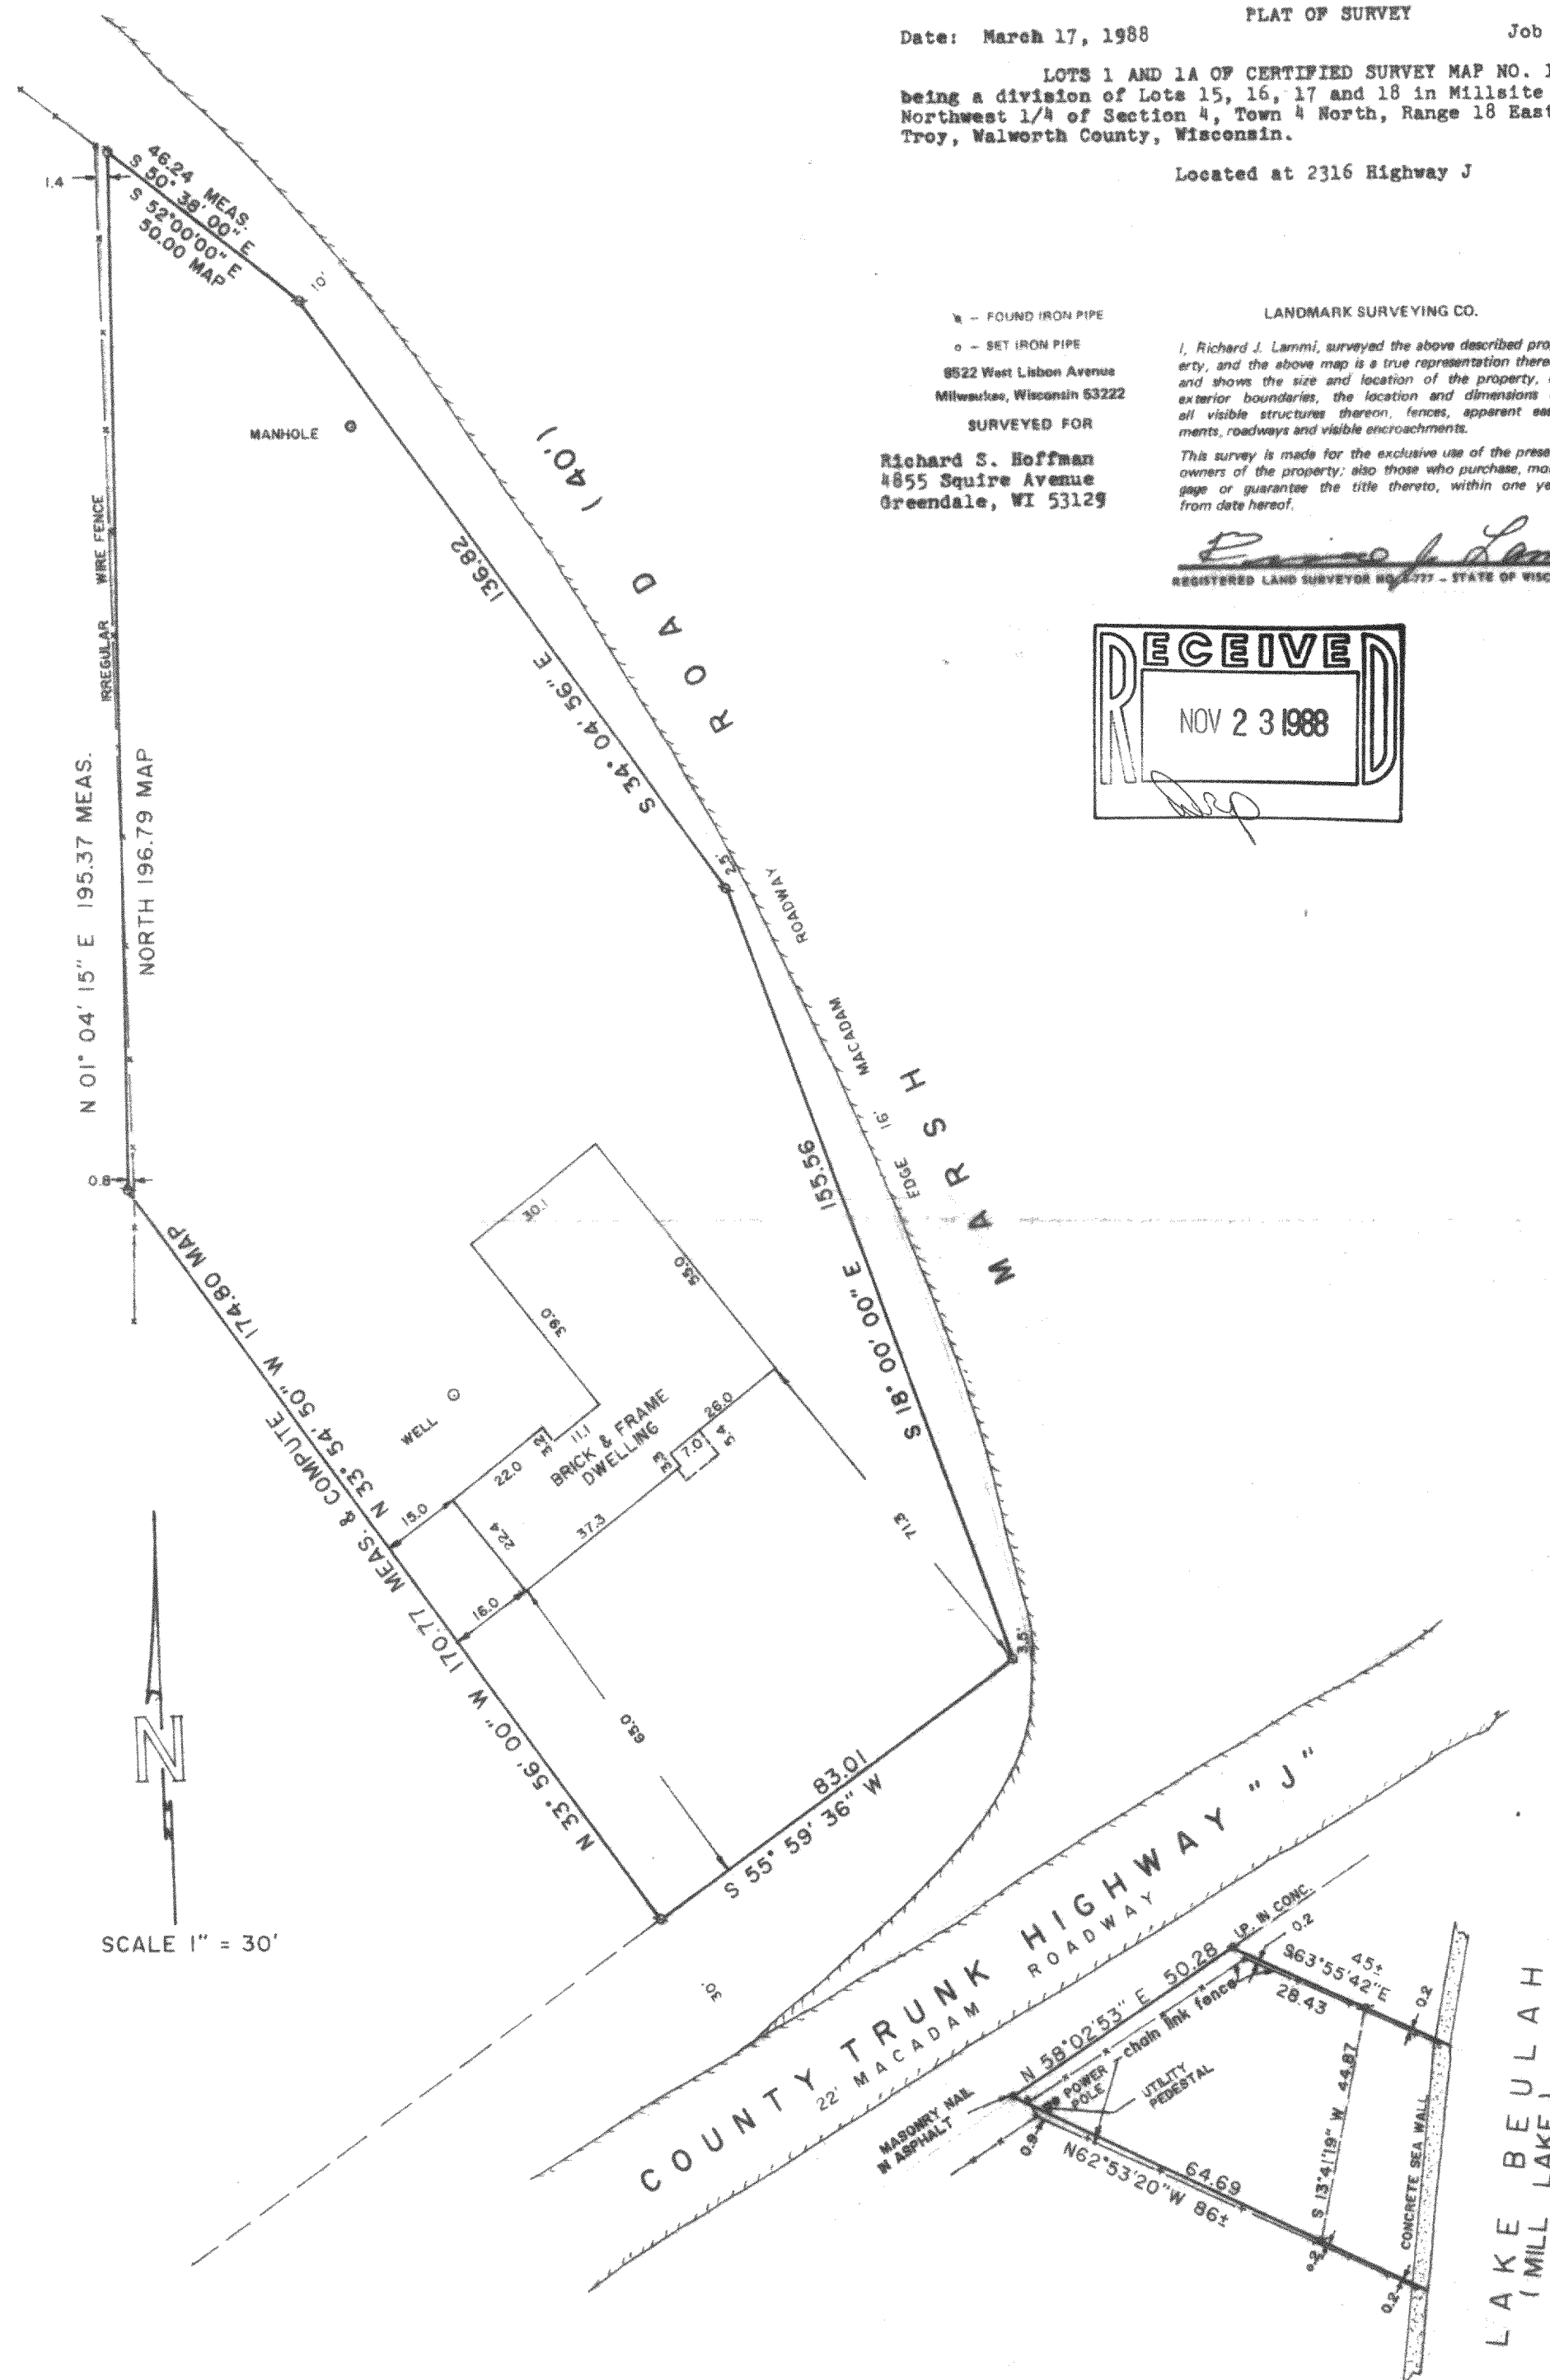

418-637