

ASSOCIATES, INC.


**WAUWATOSA, WISCONSIN 53226** 


FREDERICK W. SHIBILSKI RLS (414) 257-2212

PLAT OF SURVEY -of-

LOTS 10, 11 and 12, BLOCK 10, in PLAT OF MIRAMAR, being a Subdivision located in Section 10 and 11, Township 4 North, Range 18 East, Walworth County, Wisconsin.

Survey location: 939 Ash Street Buyer: Thomas & Yvonne Weis

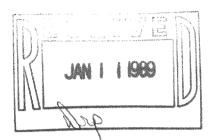

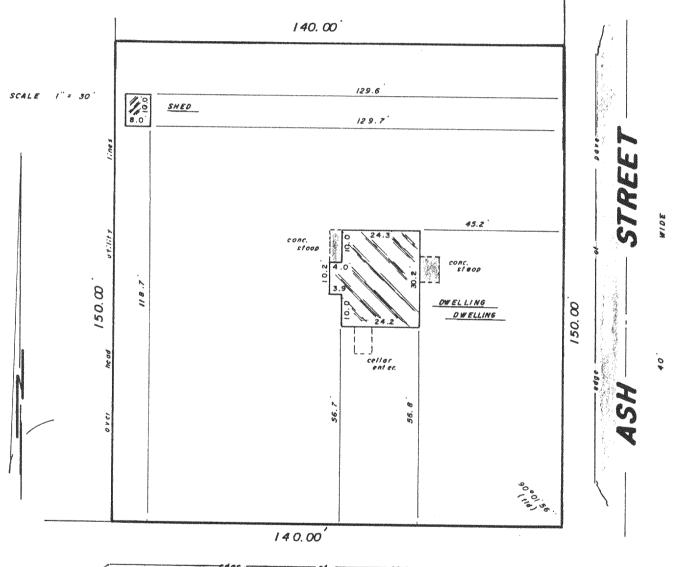

40

Surveyed for: SECURITY MORTGAGE CORP.

"I hereby certify that I have surveyed the above described property and that the above map is a true representation thereof and shows the size and location of the property, its exterior boundaries, the location of all visible structures and dimensions of all principal buildings thereon, boundary fences, apparent easements, roadways and encroachments, if any.

"This survey is made for the use of the present owners of the property, and also those who purchase, mortgage, or guarantee the title thereto within one year from date hereof.

WIDE

MONUMENTATION BY WRITTEN AGREEMENT WITH THE ABOVE NAMED CLIENT (HAS NOW) BEEN WAIVED IN ACCORDANCE WITH A-E 5.01 (1) (b) OF THE WISCONSIN ADMINISTRATIVE CODE



"THIS IS NOT AN ORIGINAL SURVEY UNLESS THIS SEAL IS RED."

418-650

WISCONSIN REGISTERED LAND SURVEYOR

DEC. 19, 1986 DATE

bjk / klk

FIELD WORK BY

mdn DRAWN BY 15268

JOB NUMBER