


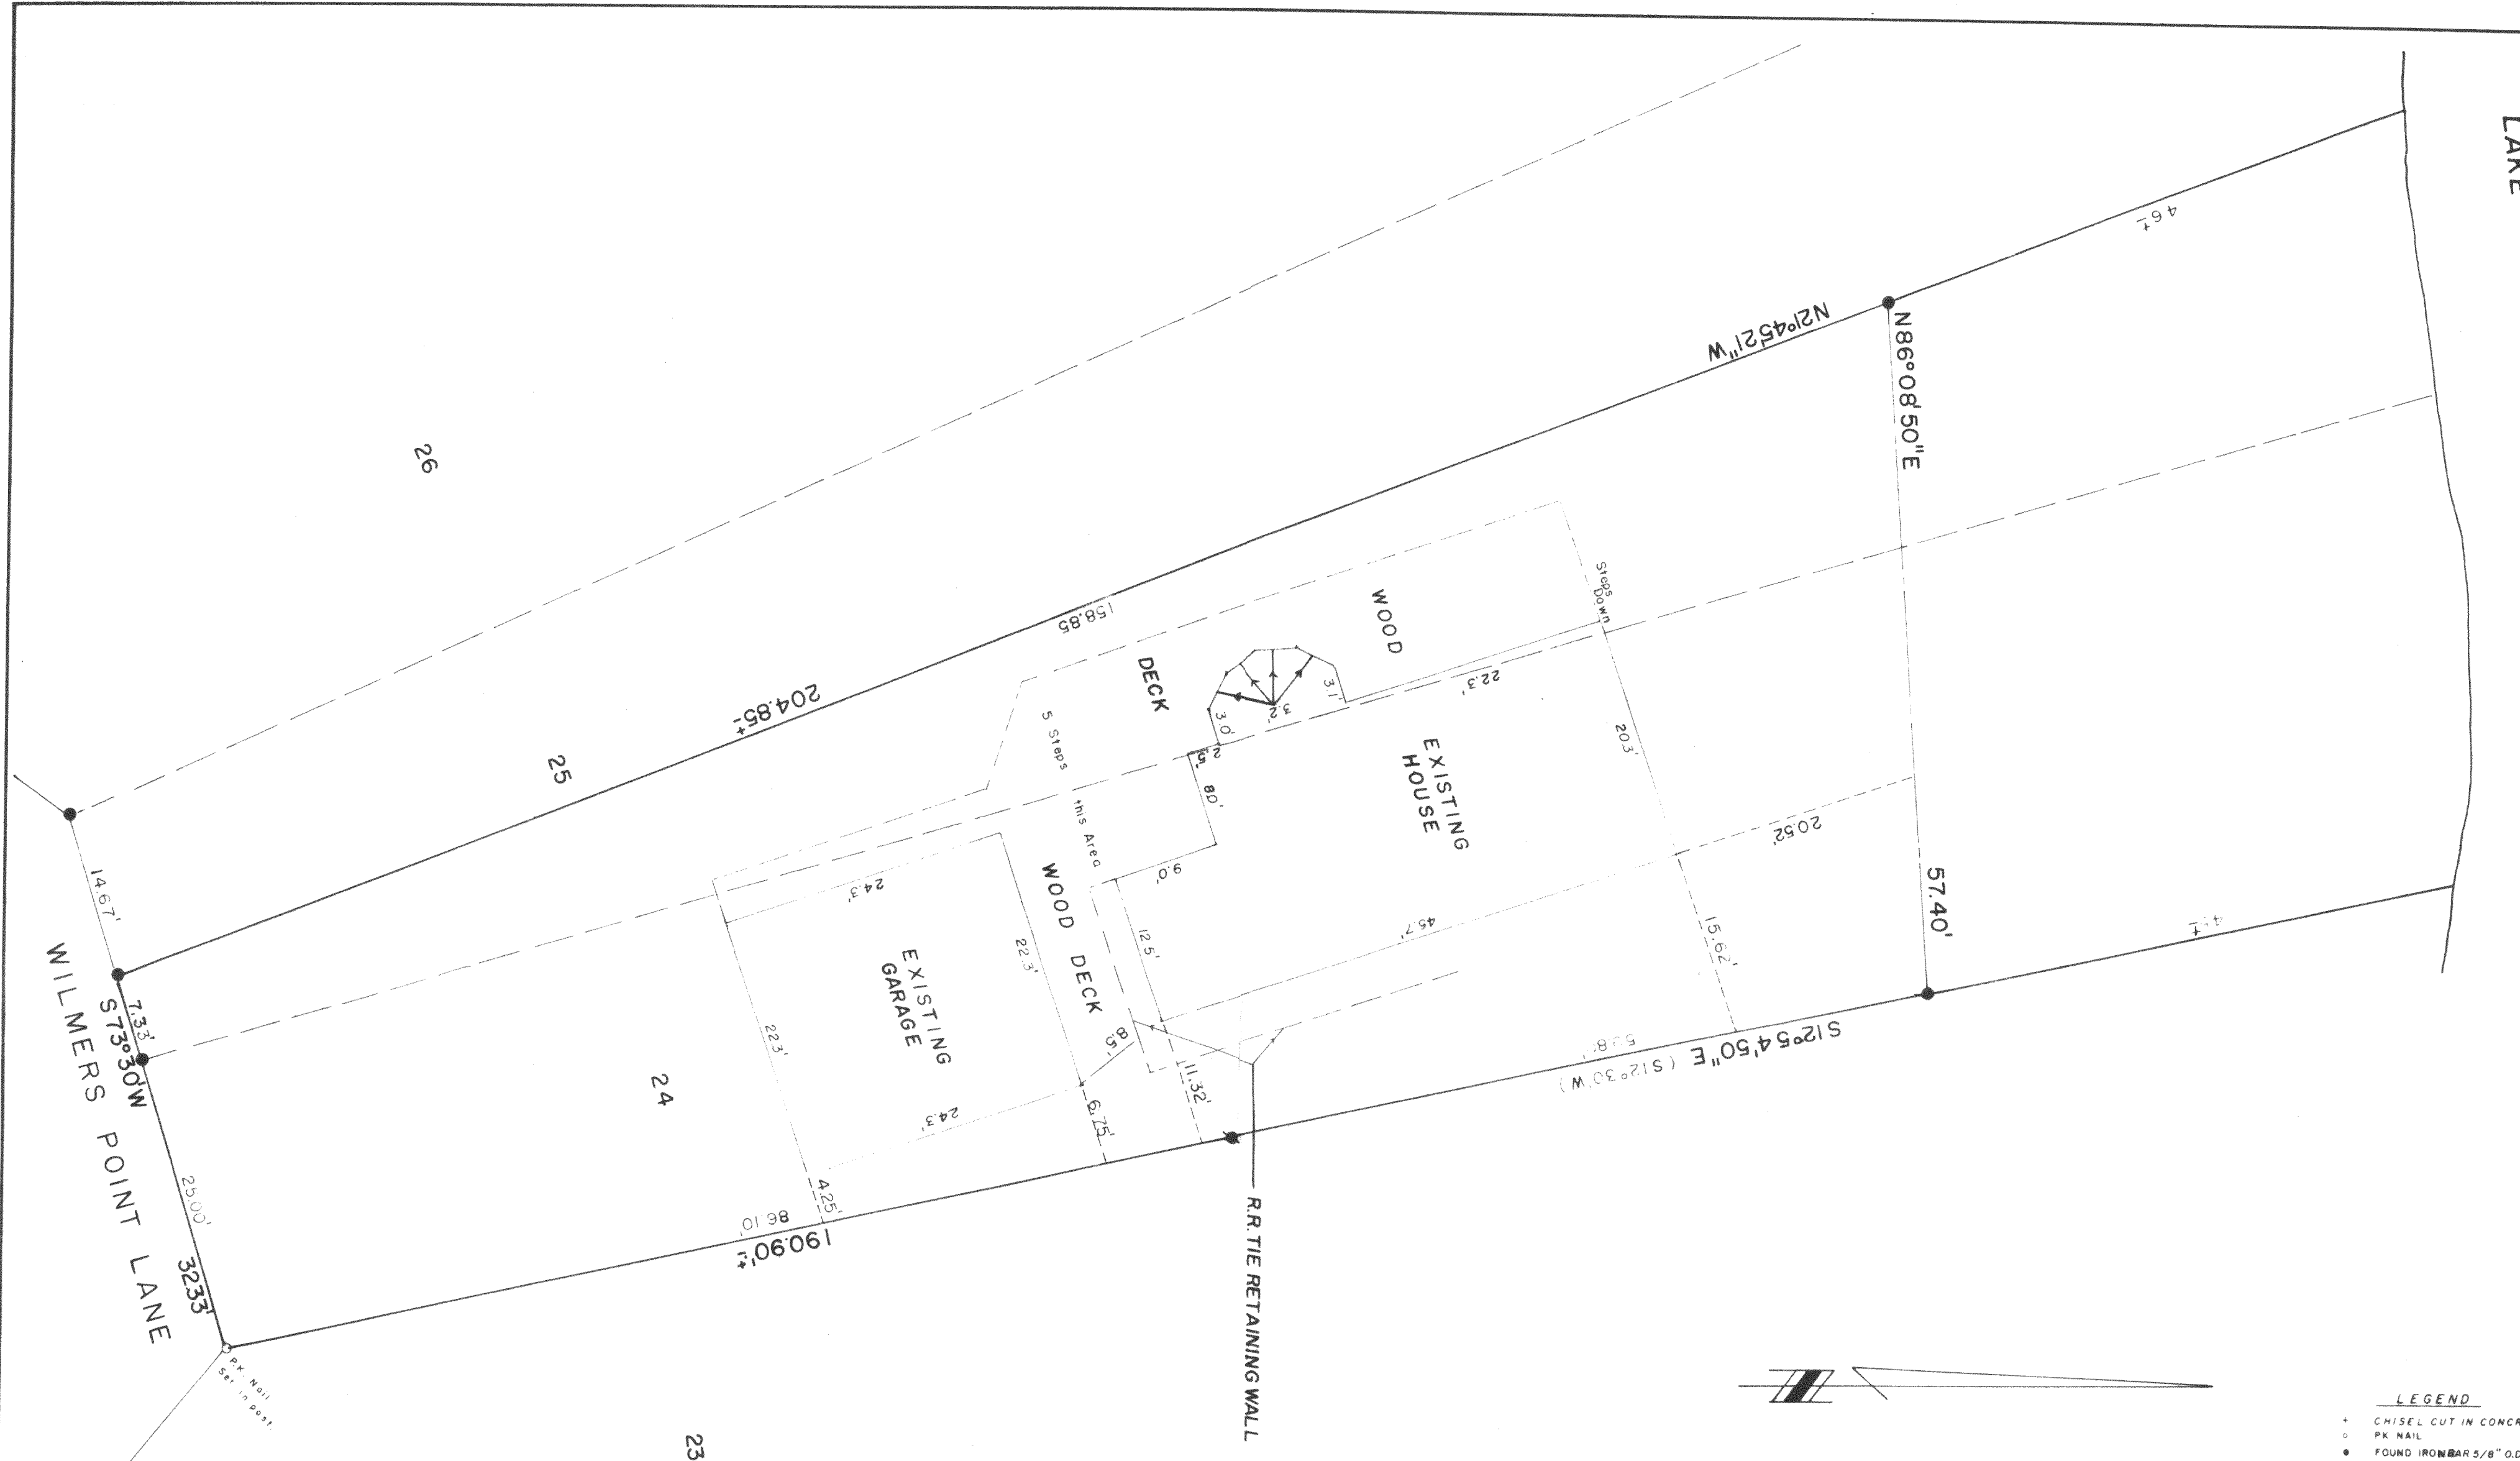


- LEGEND
- + CHISEL CUT IN CONCRETE
 - o PK NAIL
 - FOUND IRON BAR 5/8" O.D.
 - # FOUND IRON PIPE - 1 1/2" X 24"
 - o SET IRON PIPE
 - FOUND BRASS CAPPED MONUMENT
 - ⊕ FOUND CONCRETE MONUMENT
 - FENCE
 - () RECORDED AS
 - EXISTING GROUND ELEVATION

RECEIVED
JUN 18 1990
W.S.

Tax# PWW-19

418-686

THIS IS AN ORIGINAL PRINT ONLY
IF SEAL IS PRINTED IN RED.

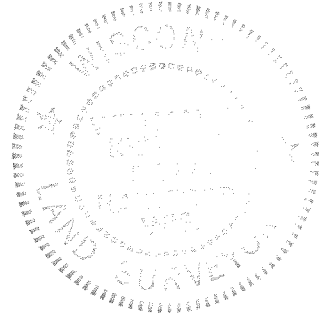

"I hereby certify that I have surveyed the above described property and that the above map is a true representation thereof and shows the size and location of the property, its exterior boundaries, the location of all visible structures and dimensions of all principal buildings thereon, boundary fences, apparent easements, roadways and visible encroachments, if any.

"This survey is made for the use of the present owners of the property, and also those who purchase, mortgage, or guarantee the title thereto within one year from date hereof."

NO MONUMENTATION HAS BEEN WAIVED IN ACCORDANCE WITH A.E.S. 011(b) OF THE WISCONSIN ADMINISTRATIVE CODE

William J. Kuegel
WISCONSIN REGISTERED LAND SURVEYOR

PLAT OF SURVEY FOR DEBRA BOEHLKE Lot 24 and the Easterly 1/3 of Lot 25, Block 1, Wilmars Grove Subdivision, Town of East Troy, County of Walworth, State of Wisconsin.		
DATE 6/8/90	Baxter & Woodman of Wisconsin 326 NORTH PINE STREET / BURLINGTON, WI 53105 414/763-7834 FAX: 414/763-2509	JOB NO. 90128
SCALE 1" = 10'		CHECKED
DRAWN RSJ		SHEET 1 OF 1
REVISED		