

PREPARED BY:

ABERNATHY AND ASSOCIATES

POINT	ELEVATION
12	108.20
13	116.20
14	112.30
15	110.40
16	107.70
17	107.40
18	105.50
19	104.50
20	100.50
21	100.60
22	102.00
23	101.80
24	102.30
25	98.70
26	97.70
27	100.30
28	100.40
29	107.20

WINDY WAY

LOT 8 OF LAKE BEULAH ESTATES

PROPOSED RESIDENCE LOCATION

ORDERED BY: DAN FINKE CONSTRUCTION

OWNER: PAT NELSON

SE COR. CONC. PAD
ASSUMED ELEV. = 100'

LOT 8

SCALE 1"=40 FEET

NOTES

- 1) SE CORNER CONC. ELEC. PAD: ELEV.=100.00' BENCHMARK ASSUMED
- 2) PROPOSED RES. STAKED AS DIRECTED BY CONTRACTOR AND OWNER 9/7/89.
- 3) WOOD REDTOP STAKES SET AT BUILDING CORNERS.
- 4) ELEVATIONS AS SHOWN REFER TO GROUND ELEV. TAKEN NEAR CORNER STAKES.
- 5) ONLY THE NORTH LINE OF PROPERTY HAS BEEN VERIFIED FOR THIS STAKEOUT.


Kenneth B. Abernathy Jr.
 KENNETH B. ABERNATHY JR. S-1594.

I hereby certify that I have surveyed the above building location and that the location and grades shown hereon are correct to the best of my professional knowledge and belief.

dated this 13 day of November 1989.



LAKE BEULAH
 ELEV= 51.43'
 10/5/89

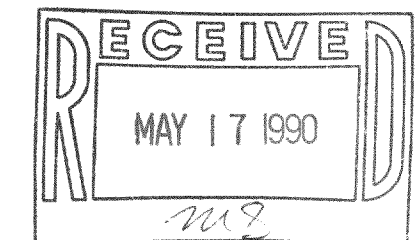

PROJECT NO. 1989.1105

418-691
 TAX# PLBE-8


NO SPOIL IN THIS AREA

DETAIL OF NELSON RESIDENCE

SCALE 1"=10 FEET

NOTES

- 1) BUILDING WAS STAKED FOR EXCAVATION 11/8/89 FROM AN IRON ROD CONTROL PT. ON THE NORTH LINE APPROX. 4.5' EAST OF ELEC. TRANSFORMER PAD.
- 2) VISIBILITY OF ALL BLDG. CORNERS FROM THE CONTROL POINT IS NECESSARY TO RESTAKE BLDG. CORNERS SUBSEQUENT TO EXCAVATION THEREFORE NO SPOIL ON NORTH END.


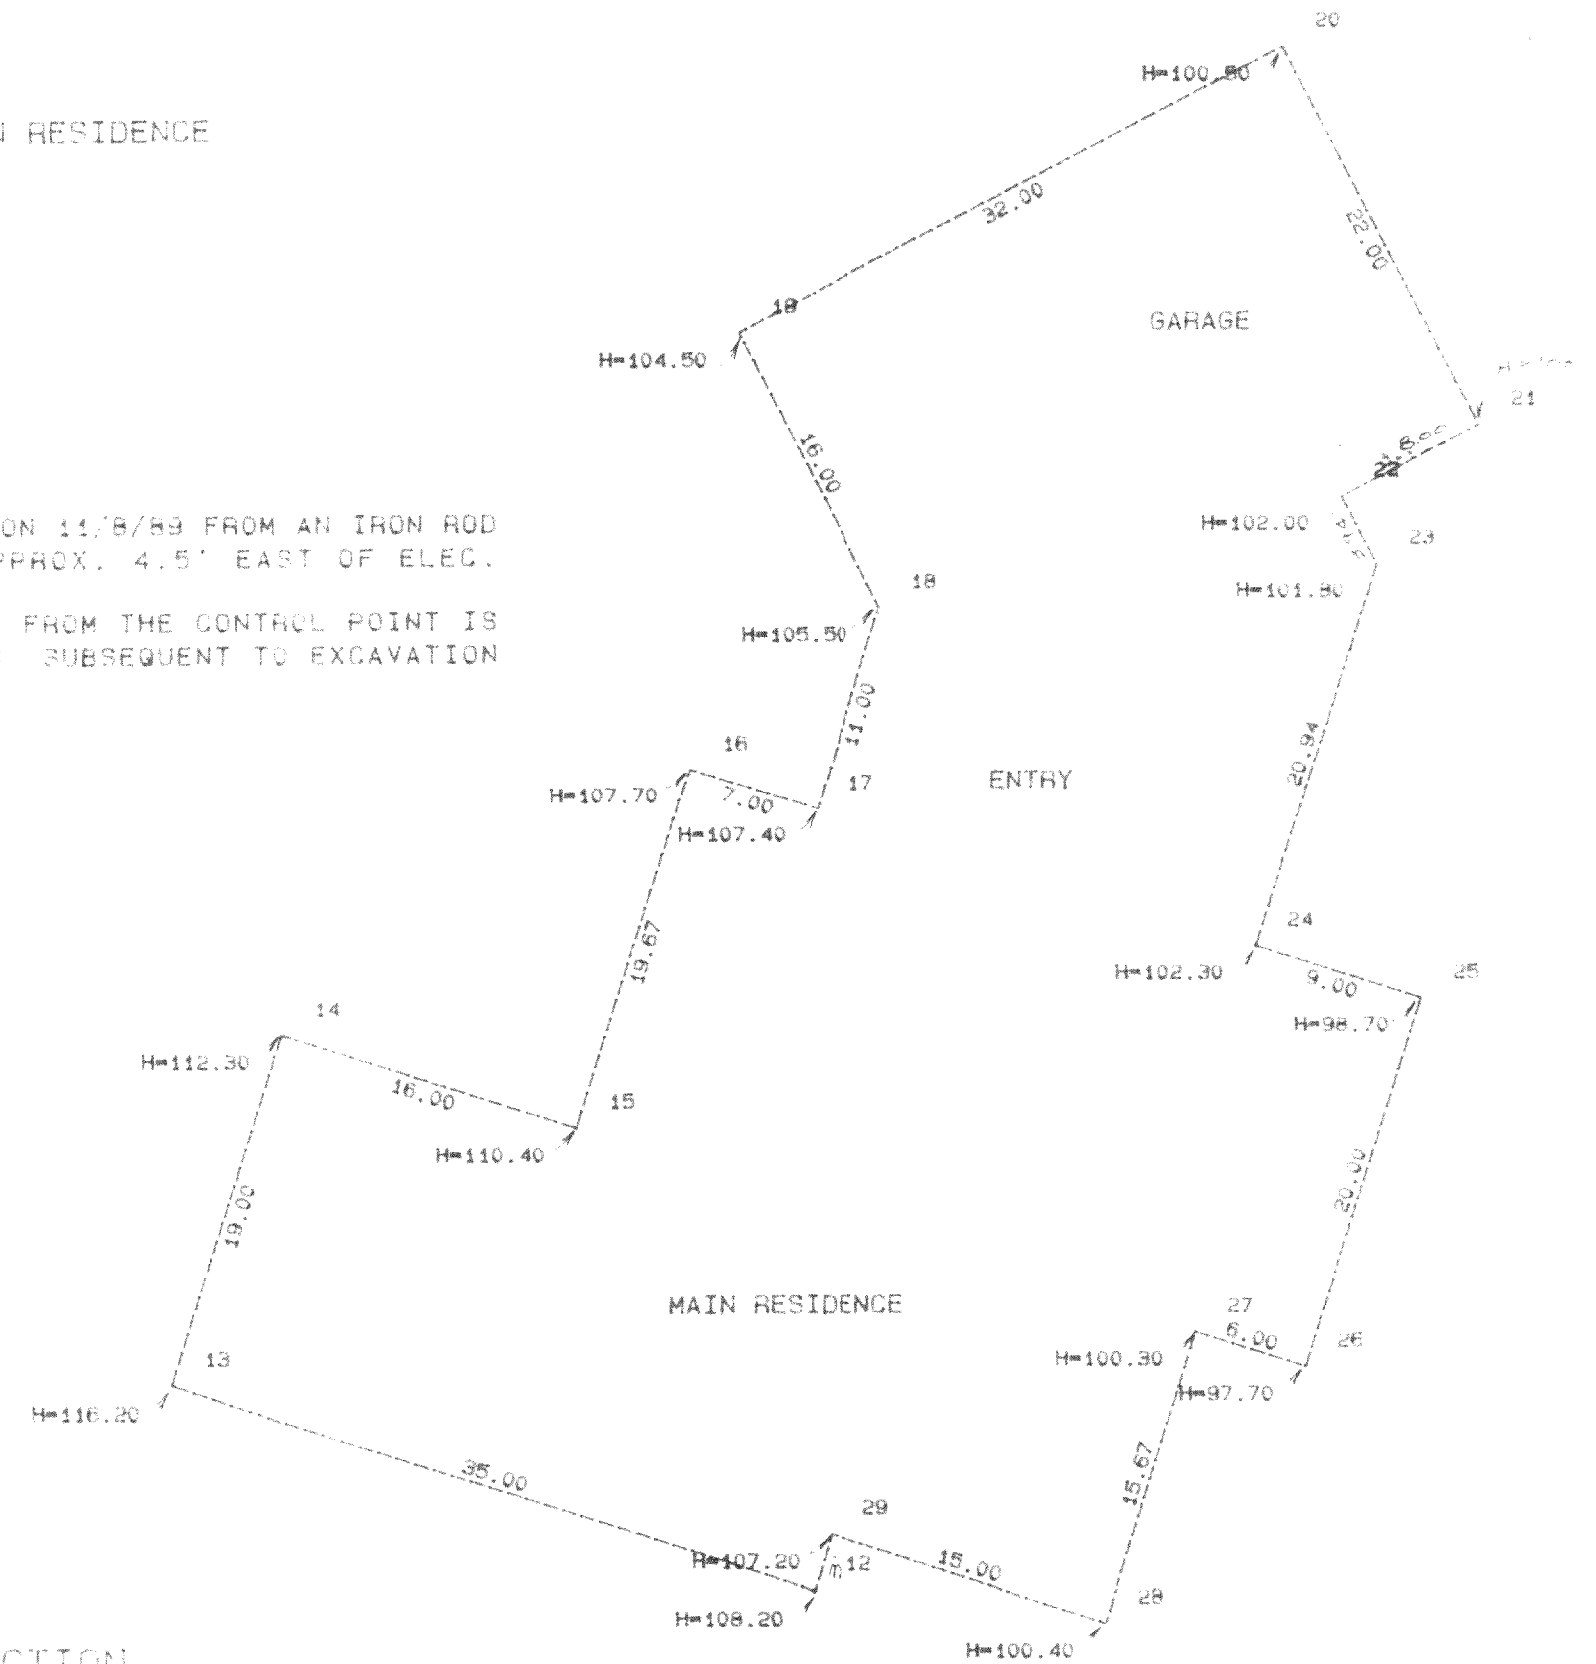


SCALE 1"=10'

ORDERED BY: FINKE CONSTRUCTION

PROJECT NO. 19891105

SHEET 2 OF 2 SHEETS

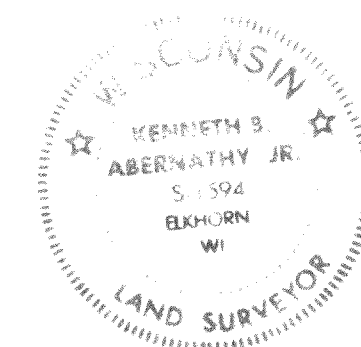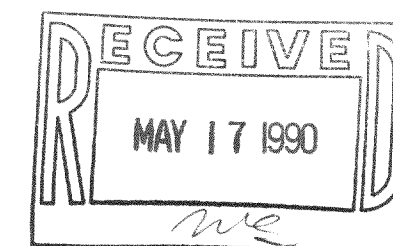

Tax # PLBE-8 418-691