

PLAT OF SURVEY
OF

THE SOUTH HALF OF LOT 4 AND ALL OF LOTS 5, 6 & 7, BLOCK 5, WILMER GROVE BEACH, LOCATED IN
THE EAST HALF OF SECTION 18, T. 4 N., R. 18 E. OF THE 4TH P.M., TOWNSHIP OF EAST TROY,
COUNTY OF WALWORTH, STATE OF WISCONSIN.

I HEREBY CERTIFY THAT I HAVE SURVEYED THE LAND DESCRIBED ABOVE AND THAT THE PLAT
DRAWN HEREON IS A CORRECT REPRESENTATION OF SAID SURVEY.



RE-SURVEYED 10-19-90

5-7-73

JOHN F. DEGEN, LAND SURVEYOR #242
589 N. PINE ST., BURLINGTON, WISCONSIN.

SCALE 1" = 30'

o denotes iron pipe stake

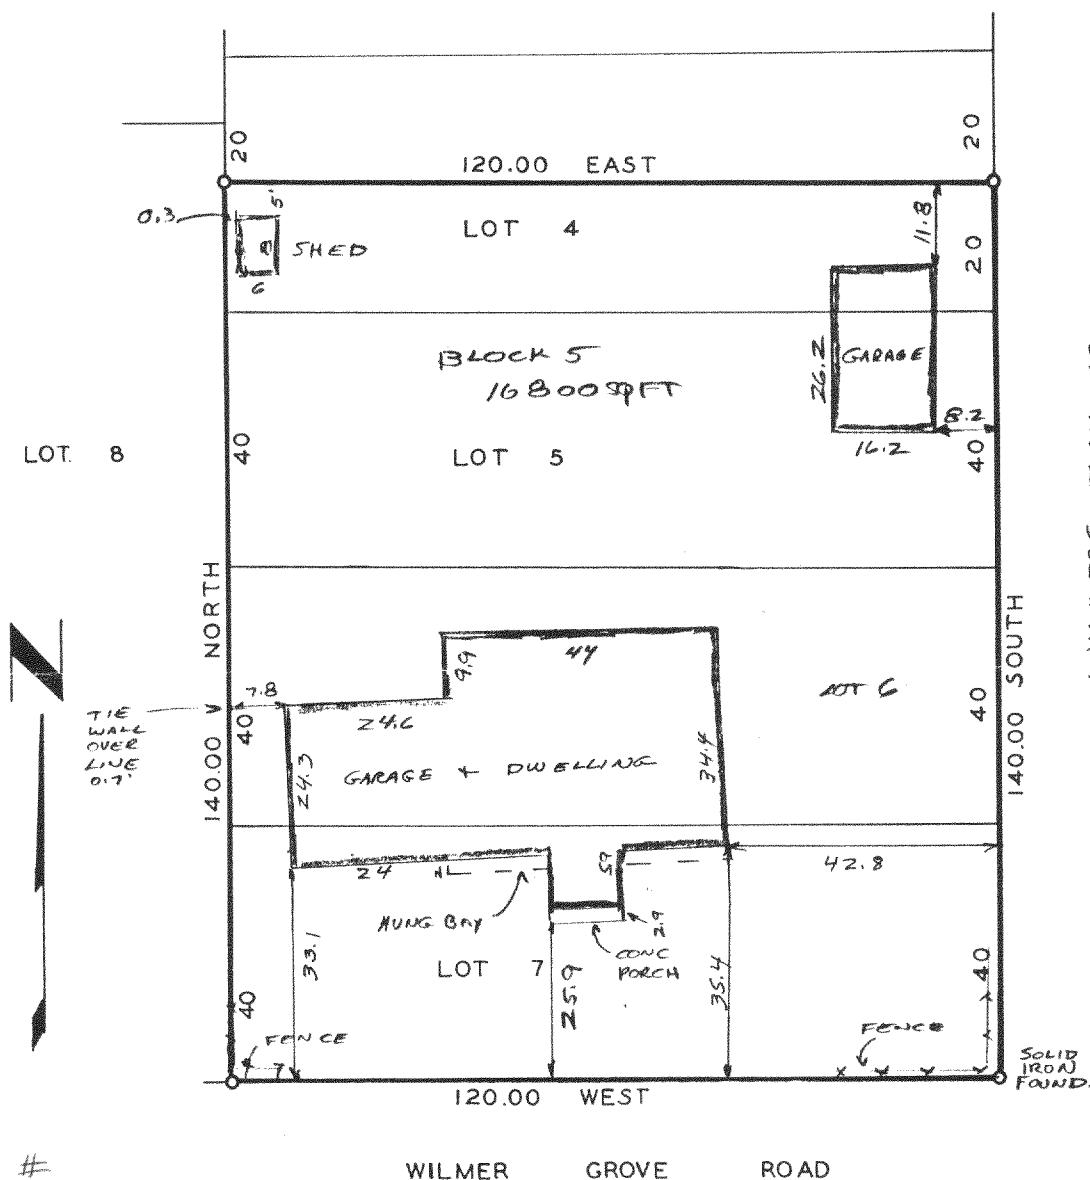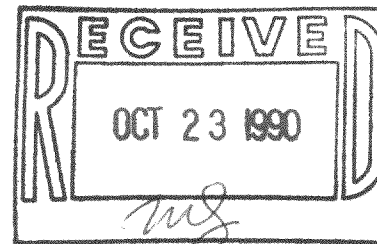

TAX KEY #

FWW 00043

REVISED 1-30-76 TO SHOW BLDG.

5-7-73 DRAWER 1-C-4

418-701

25