
## Plat of Survey

THE WEST 1/2 OF LOT 2 OF THE WHITE SUBDIVISION LOCATED IN THE W 1/2 OF SECTION 17. T 4 N. R 18 E. WALWORTH COUNTY, WISCONSIN

Surveyed for: WILLIAM McGUIRE 2848 KINGS LANE

EAST TROY, WI 53120

SW 1y LINE OF LOT 2 ASSIGNED THE

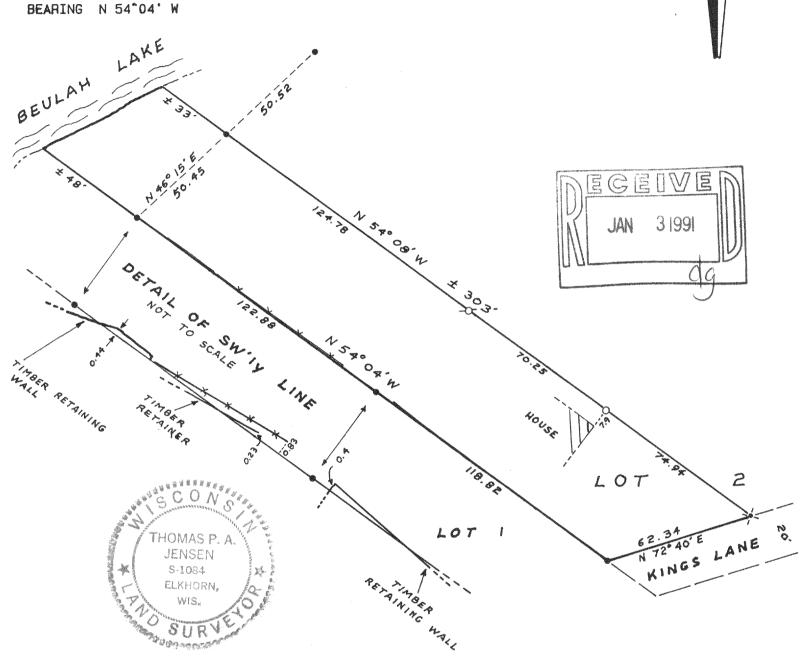

I, Thomas P. A. Jensen, Wisconsin Registered Land Surveyor, hereby certify that this survey was performed by me, or under my direction, in full compliance with the owner's/agent's instructions, and that this map is an accurate representation thereof to the best of my knowledge and belief.

Thomas P. A. Jensen, R.L.S.-1084

JENSEN SURVEYING & MAPPING, S.C.

Copyright (c) 1990 by Jensen Surveying & Mapping S.C. All rights reserved. No part of this survey plat may be reproduced or transmitted in any form by any means - graphic, electronic, or mechanical, including photocopying, tracing, or information storage and rerieval systems - without permission in writing from Thomas P.A. Jensen.

## Legend

- Found iron pipe, i' die.
- Found iron rod, 3/4' dia.
- Set iron pipe, i' dia.
- Set P.K. neil

Wood rail fence

418-723

## Jensen Surveying & Mapping S.C.

45 South Wisconsin Street P.O. Box 322 Elkhorn, Wisconsin. 53121. (414) 723-3434

		Scale:	1	(83)	40 '	•	
0	20	40			8	0	120

Mapping date: APRIL 30, 1990 Revisions:

Sheet 1 of 1 Sheets

Job reference number:

1989.150 tw4 000003