
## Plat of Survey

is located in Section 4, T 4 N R 18 E of Walworth County, Wisconsin, described as follows, to-wit: Beginning at the Southeast corner of lot 4 of said Subdivision: thence South 89° 15' West along the South line of said Lot 4. 288.90 feet to the shore of Beulah Lake; thence Northeasterly along the shore 81 feet; thence South 87° 26' East 211.96 feet; thence North 0° 34' West 19.45 feet; thence North 89° 20' East 40.00 feet to the East line of Lot 3 of said Subdivision; thence South 0° 34° East along the East line of said Lots 3 and 4. 80.34 feet to the place of beginning.

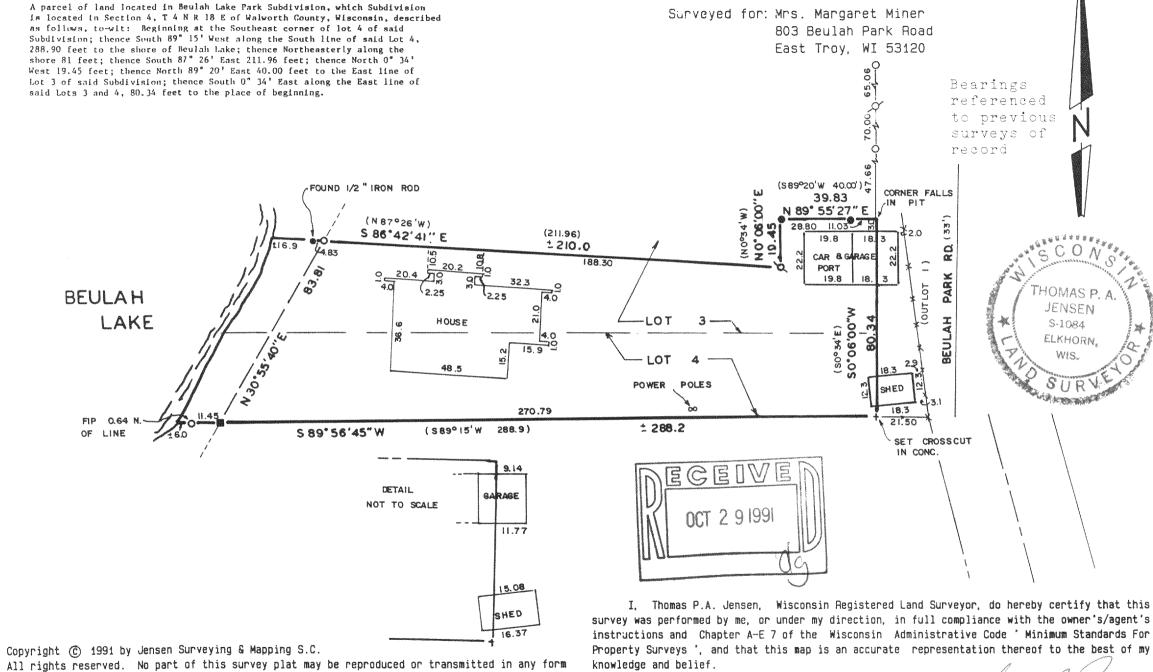

All rights reserved. No part of this survey plat may be reproduced or transmitted in any form by any means - graphic, electronic, or mechanical, including photocopying, tracing, or information storage and retrieval systems - without permission in writing from Thomas P.A. Jensen.

Note: This survey plat is not certified unless signed and sealed in red ink.

Thomas P.A. Jensen R.L.S.

Surveying lensen

8/22/91.

Mapping date:

P.O. 45

i South Wisconsin Street Elkhorn, Wisconsin. (414) 723-3434

Sheets

o f

991 54

Contract.