





# PLAT OF SURVEY

**LOCATION:** 1534 Wilmer Grove Road, East Troy, Wisconsin

**LEGAL DESCRIPTION:** The North 5 feet of the South 1/2 of Lot 2 in Block 1 in WILMER GROVE, a subdivision located in Walworth County, Wisconsin; it being understood that the length of said lot, so to be conveyed shall be 261.60 feet. The North 1/2 of Lot 2, Block 1, in Wilmer Grove Beach, a subdivision located in Walworth County, Wisconsin. Lot 3 in Block 1 in Wilmer Grove Beach, lying and being in the East 1/2 of Section 18, in Township 4 North, Range 18 East, in the Town of East Troy, Walworth County, Wisconsin.

April 28, 1992

Survey No. 358-M

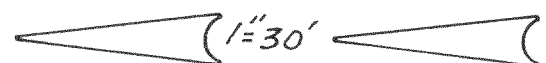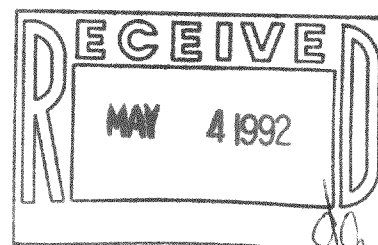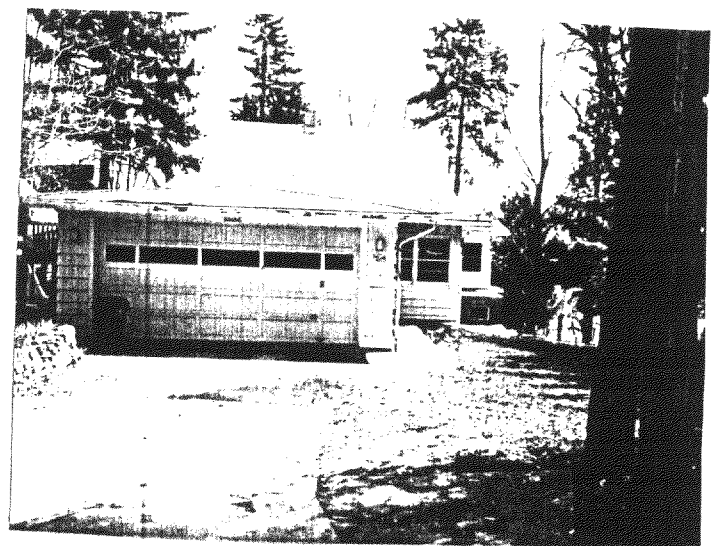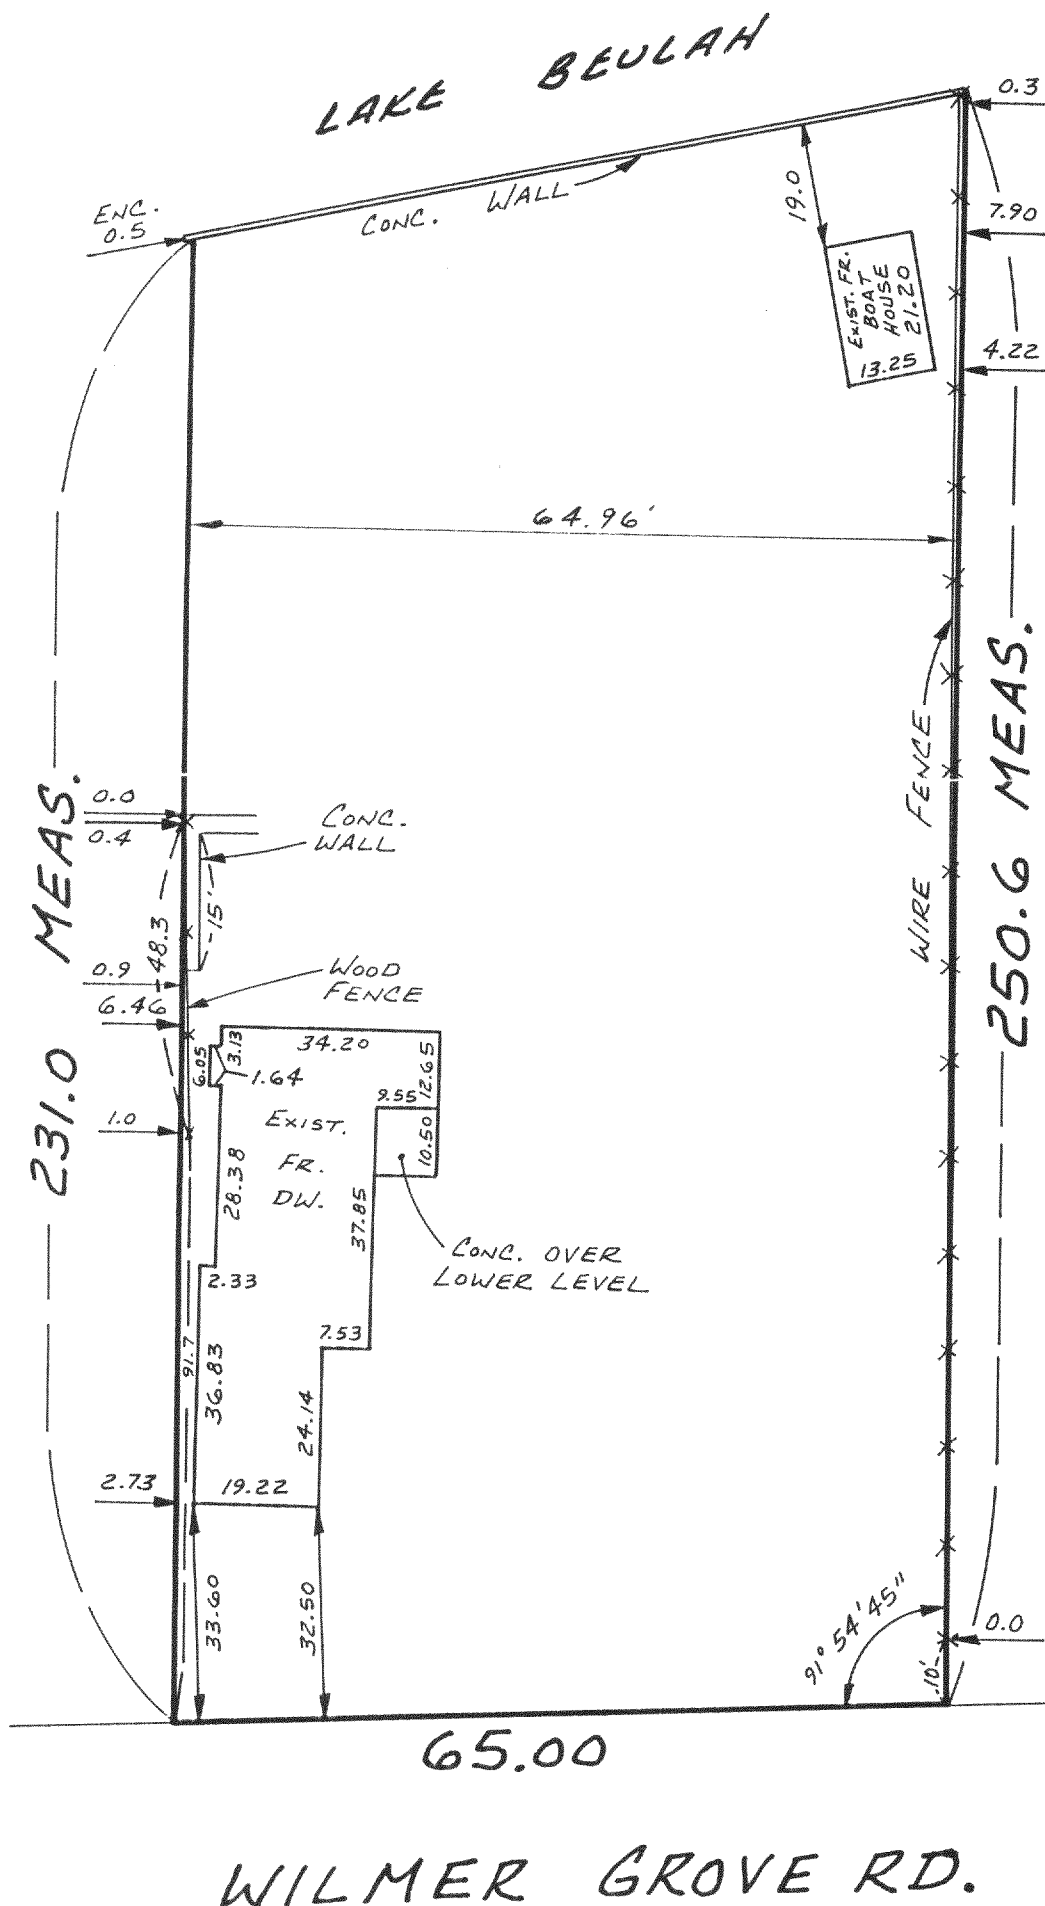

I HEREBY CERTIFY THAT I HAVE SURVEYED THE ABOVE DESCRIBED PROPERTY AND THAT THE ABOVE MAP IS A TRUE REPRESENTATION THEREOF AND SHOWS THE SIZE AND LOCATION OF THE PROPERTY, ITS EXTERIOR BOUNDARIES, THE LOCATION OF ALL VISIBLE STRUCTURES AND DIMENSIONS OF ALL PRINCIPAL BUILDINGS THEREON, BOUNDARY FENCES, APPARENT EASEMENTS AND ROADWAYS AND VISIBLE ENCROACHMENTS, IF ANY.

THIS SURVEY IS MADE FOR THE EXCLUSIVE USE OF THE PRESENT OWNERS OF THE PROPERTY, AND ALSO THOSE WHO PURCHASE, MORTGAGE, OR GUARANTEE THE TITLE THERETO WITHIN ONE (1) YEAR FROM DATE HEREOF.

SIGNED Wayne D. Mickelson

Wayne D. Mickelson  
Registered Land Surveyor S-1349

**METROPOLITAN ENTERPRISES, INC.**

REGISTERED LAND SURVEYORS

9415 W. FOREST HOME AVE., SUITE 202, HALES CORNERS, WI 53130

PH. 529-5380 FAX 529-9787

**Mortgage Inspection**

Monumentation has been waived in accordance with A-5 5.01 (b) of the Wisconsin Administrative Code.

418-806

PWJ-3