
PLAT OF SURVEY

LOCATION: 1522 Wilmers Grove Drive, East Troy, Wisconsin

LEGAL DESCRIPTION: Lots 5 & 6 in Block 1 in WILMER GROVE BEACH, being a part of the East 1/2 of Section 18, Town 4 North, Range 18 East, in the Town of East Troy, Walworth County, Wisconsin.

November 10, 1992

Survey No. 647-B

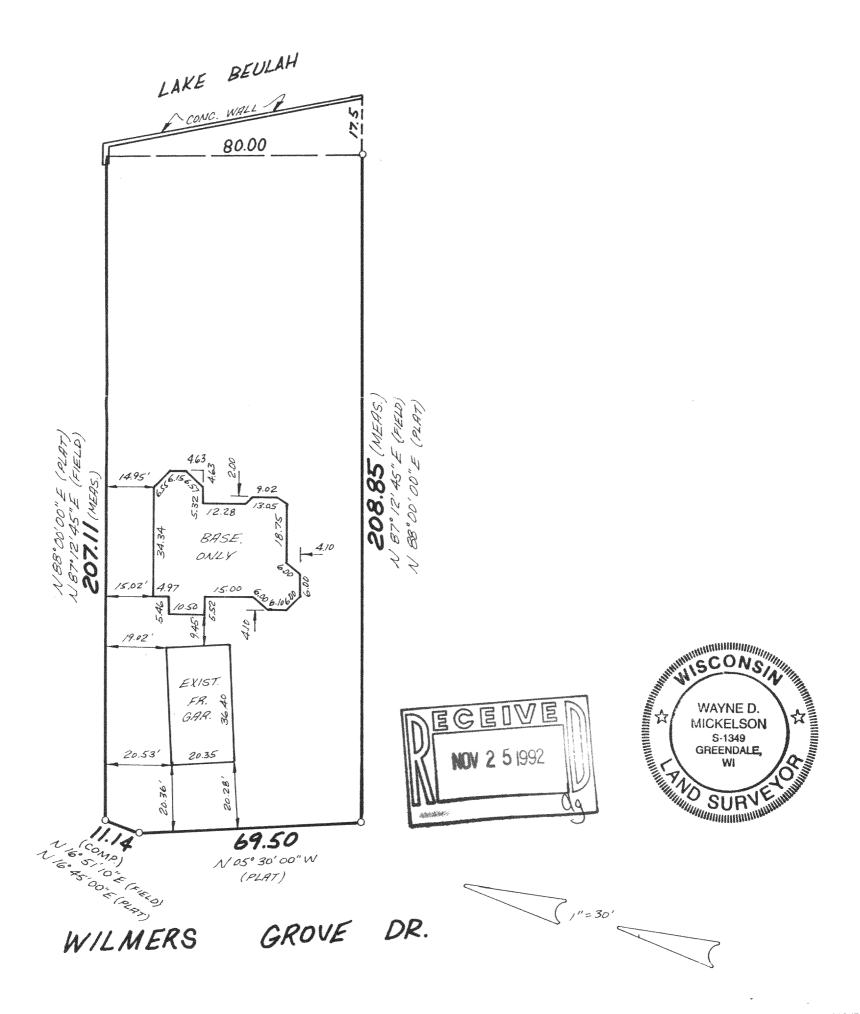

METROPOLITAN ENTERPRISES, INC. REGISTERED LAND SURVEYORS 1415 W. FOREST HOME AVE., SUITE 202, HALES CORNERS, WI. 53

9415 W. FOREST HOME AVE., SUITE 202, HALES CORNERS, WI 53130 PH. 529-5380 FAX 529-9787 I HEREBY CERTIFY THAT I HAVE SURVEYED THE ABOVE DESCRIBED PROPERTY AND THAT THE ABOVE MAP IS A TRUE REPRESENTATION THEREOF AND SHOWS THE SIZE AND LOCATION OF THE PROPERTY. ITS EXTERIOR BOUNDARIES, THE LOCATION OF ALL VISIBLE STRUCTURES AND DIMENSIONS OF ALL PRINCIPAL BUILDINGS THEREON, BOUNDARY FENCES, APPARENT EASEMENTS AND ROADWAYS AND VISIBLE ENCROACHMENTS, IF ANY.

THIS SURVEY IS MADE FOR THE EXCLUSIVE USE OF THE PRESENT OWNERS OF THE PROPERTY, AND ALSO THOSE WHO PURCHASE, MORTGAGE, OR GUARANTEE THE TITLE THERETO WITHIN ONE (1) YEAR FROM DATE HEREOF.

SIGNED BYREAL D. MICHELESSE

Wayne D. Mickelson Registered Land Surveyor S-1349

PWW-5