
29 - 72.

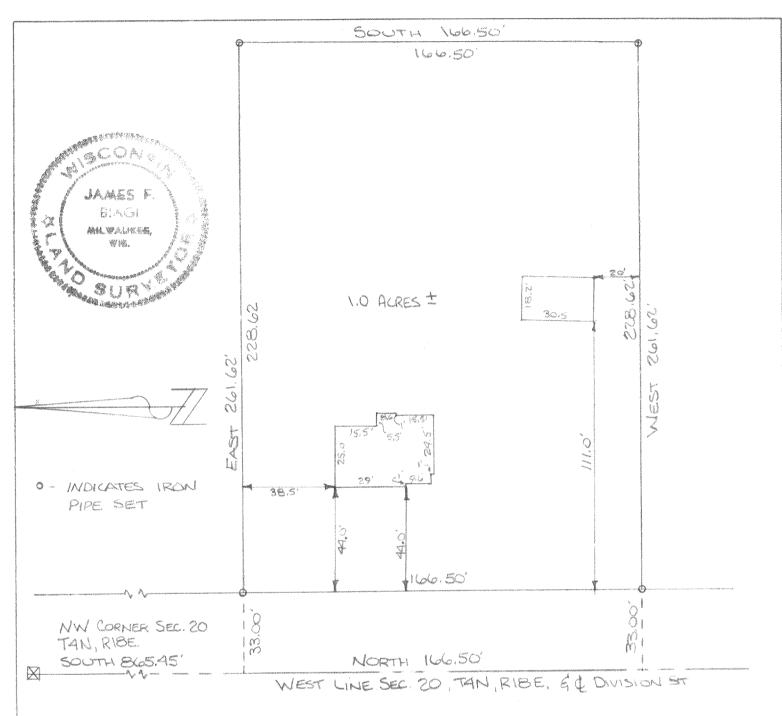

DESCRIPTION: Commencing at the NW Corner of Section 20, T4N,R18E, Walworth County, Wisconsin; Thence South along the West line of said Sec. 20, 865.45 feet to the place of beginning of the lands hereinafter described to-wit; thence East 261.62 feet, thence South 166.50 feet, thence West 261.62 feet, to said West line Sec. 20, thence North along said West line Sec. 20, 166.50 feet to the place of beginning. Containing 1.0 Acres of land, more or less.

CERTIFICATE: I, James F. Biagi, surveyor, do hereby certify that I have surveyed the lands hereon described.

DATE: May 22, 1972

James F. Biagi R.L.S.

418-4013