
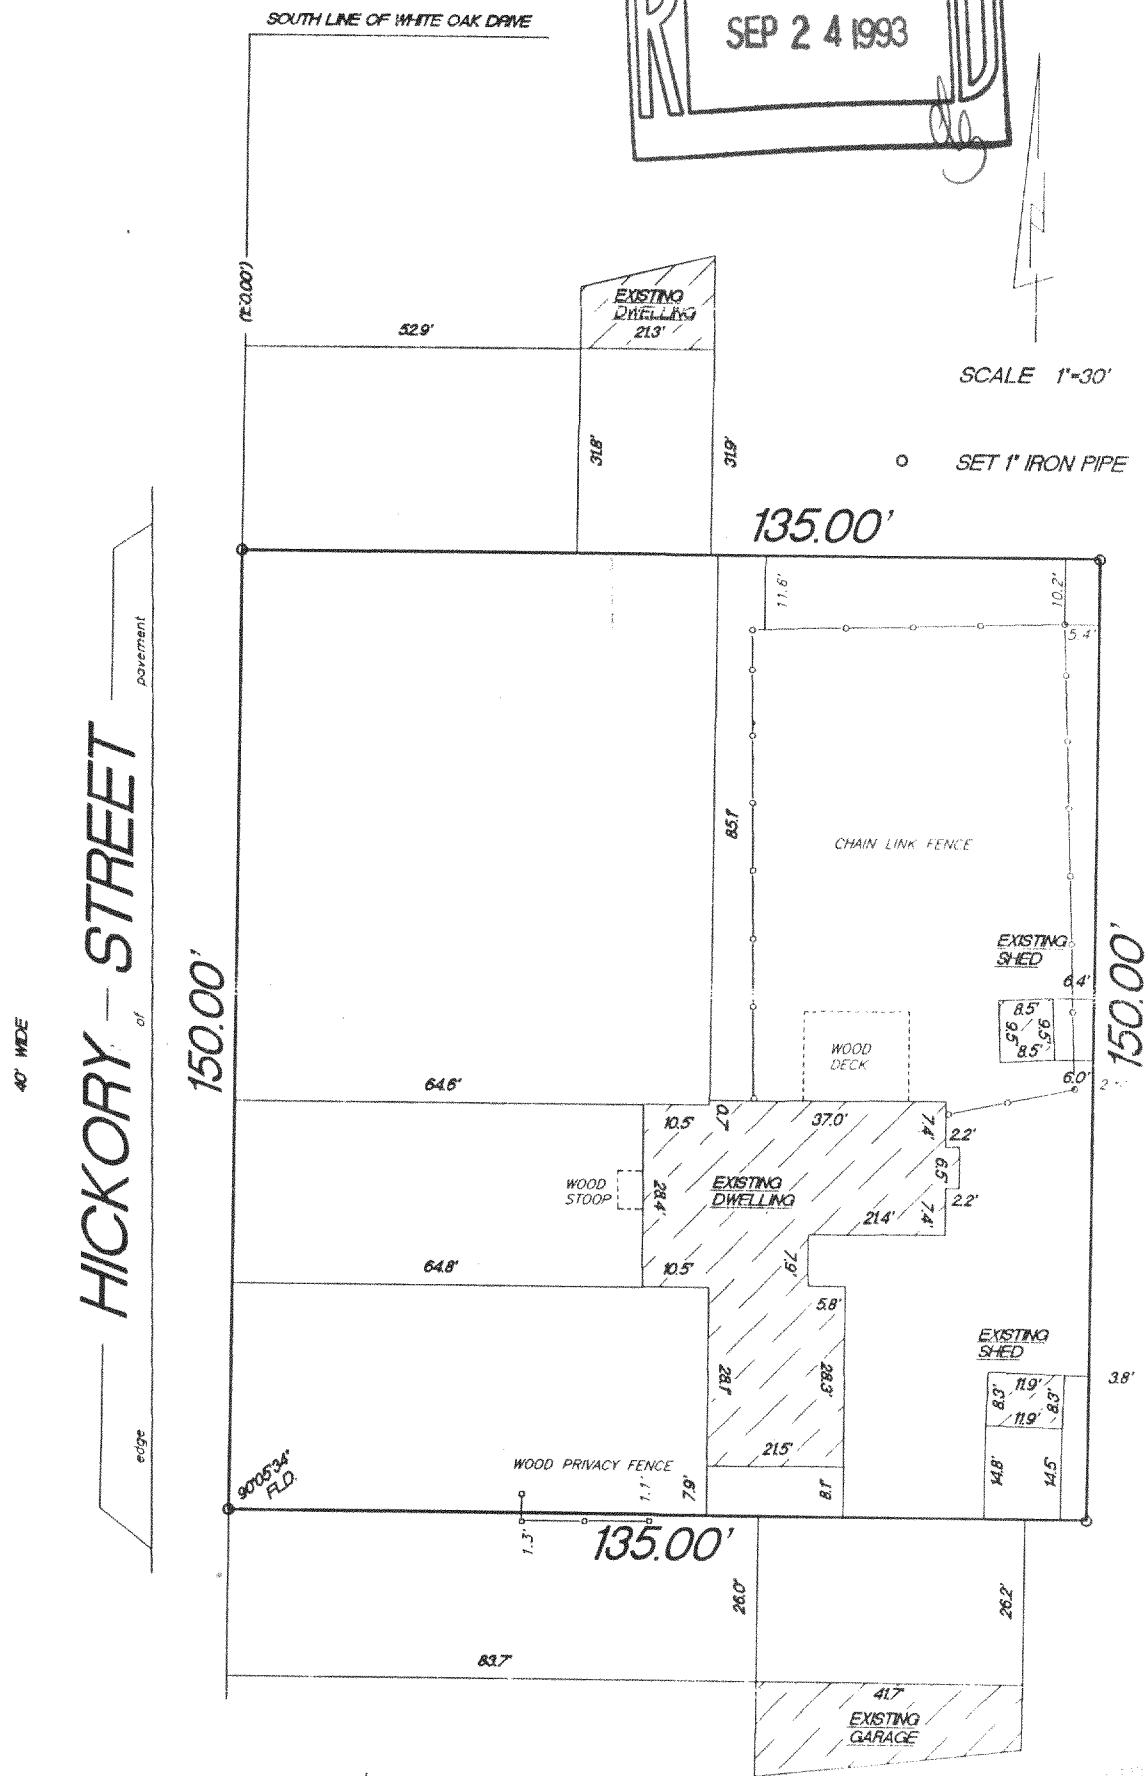


PLAT
LOTS 4, 5 AND 6 IN BLOCK 6 OF MIRAMAR, L. subdivision located in Sections 10 and 11,
Town 4 North, Range 18 East, Walworth County, Wisconsin.

Survey address: N9132 Hickory Street
Surveyed for: Thomas & Cindi Goode

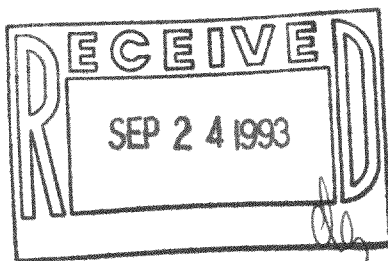

"I hereby certify that I have surveyed the above described property and that the above map is a true representation thereof and shows the size and location of the property, its exterior boundaries, the location of all visible structures and dimension of all principal buildings thereon, boundary fences, apparent easements, roadways and encroachments if any."

"This survey is made for the use of the present owners of the property, and also those who purchase, mortgage or guarantee the title thereto within one year from date hereof."

KETTLE MORaine SURVEYING
W362 S10227 Lewin Lane
Eagle Wisconsin 53119
(414) 594-3484

Terrance E. Pisarek R.L.S.

THIS IS NOT AN ORIGINAL SURVEY UNLESS THE SEAL IS RED.

8/30/93

DATE

TEP/CKS

FIELD WORK BY

TEP

DRAWN BY

93047

JOB NUMBER

PMR-73

418-9116