
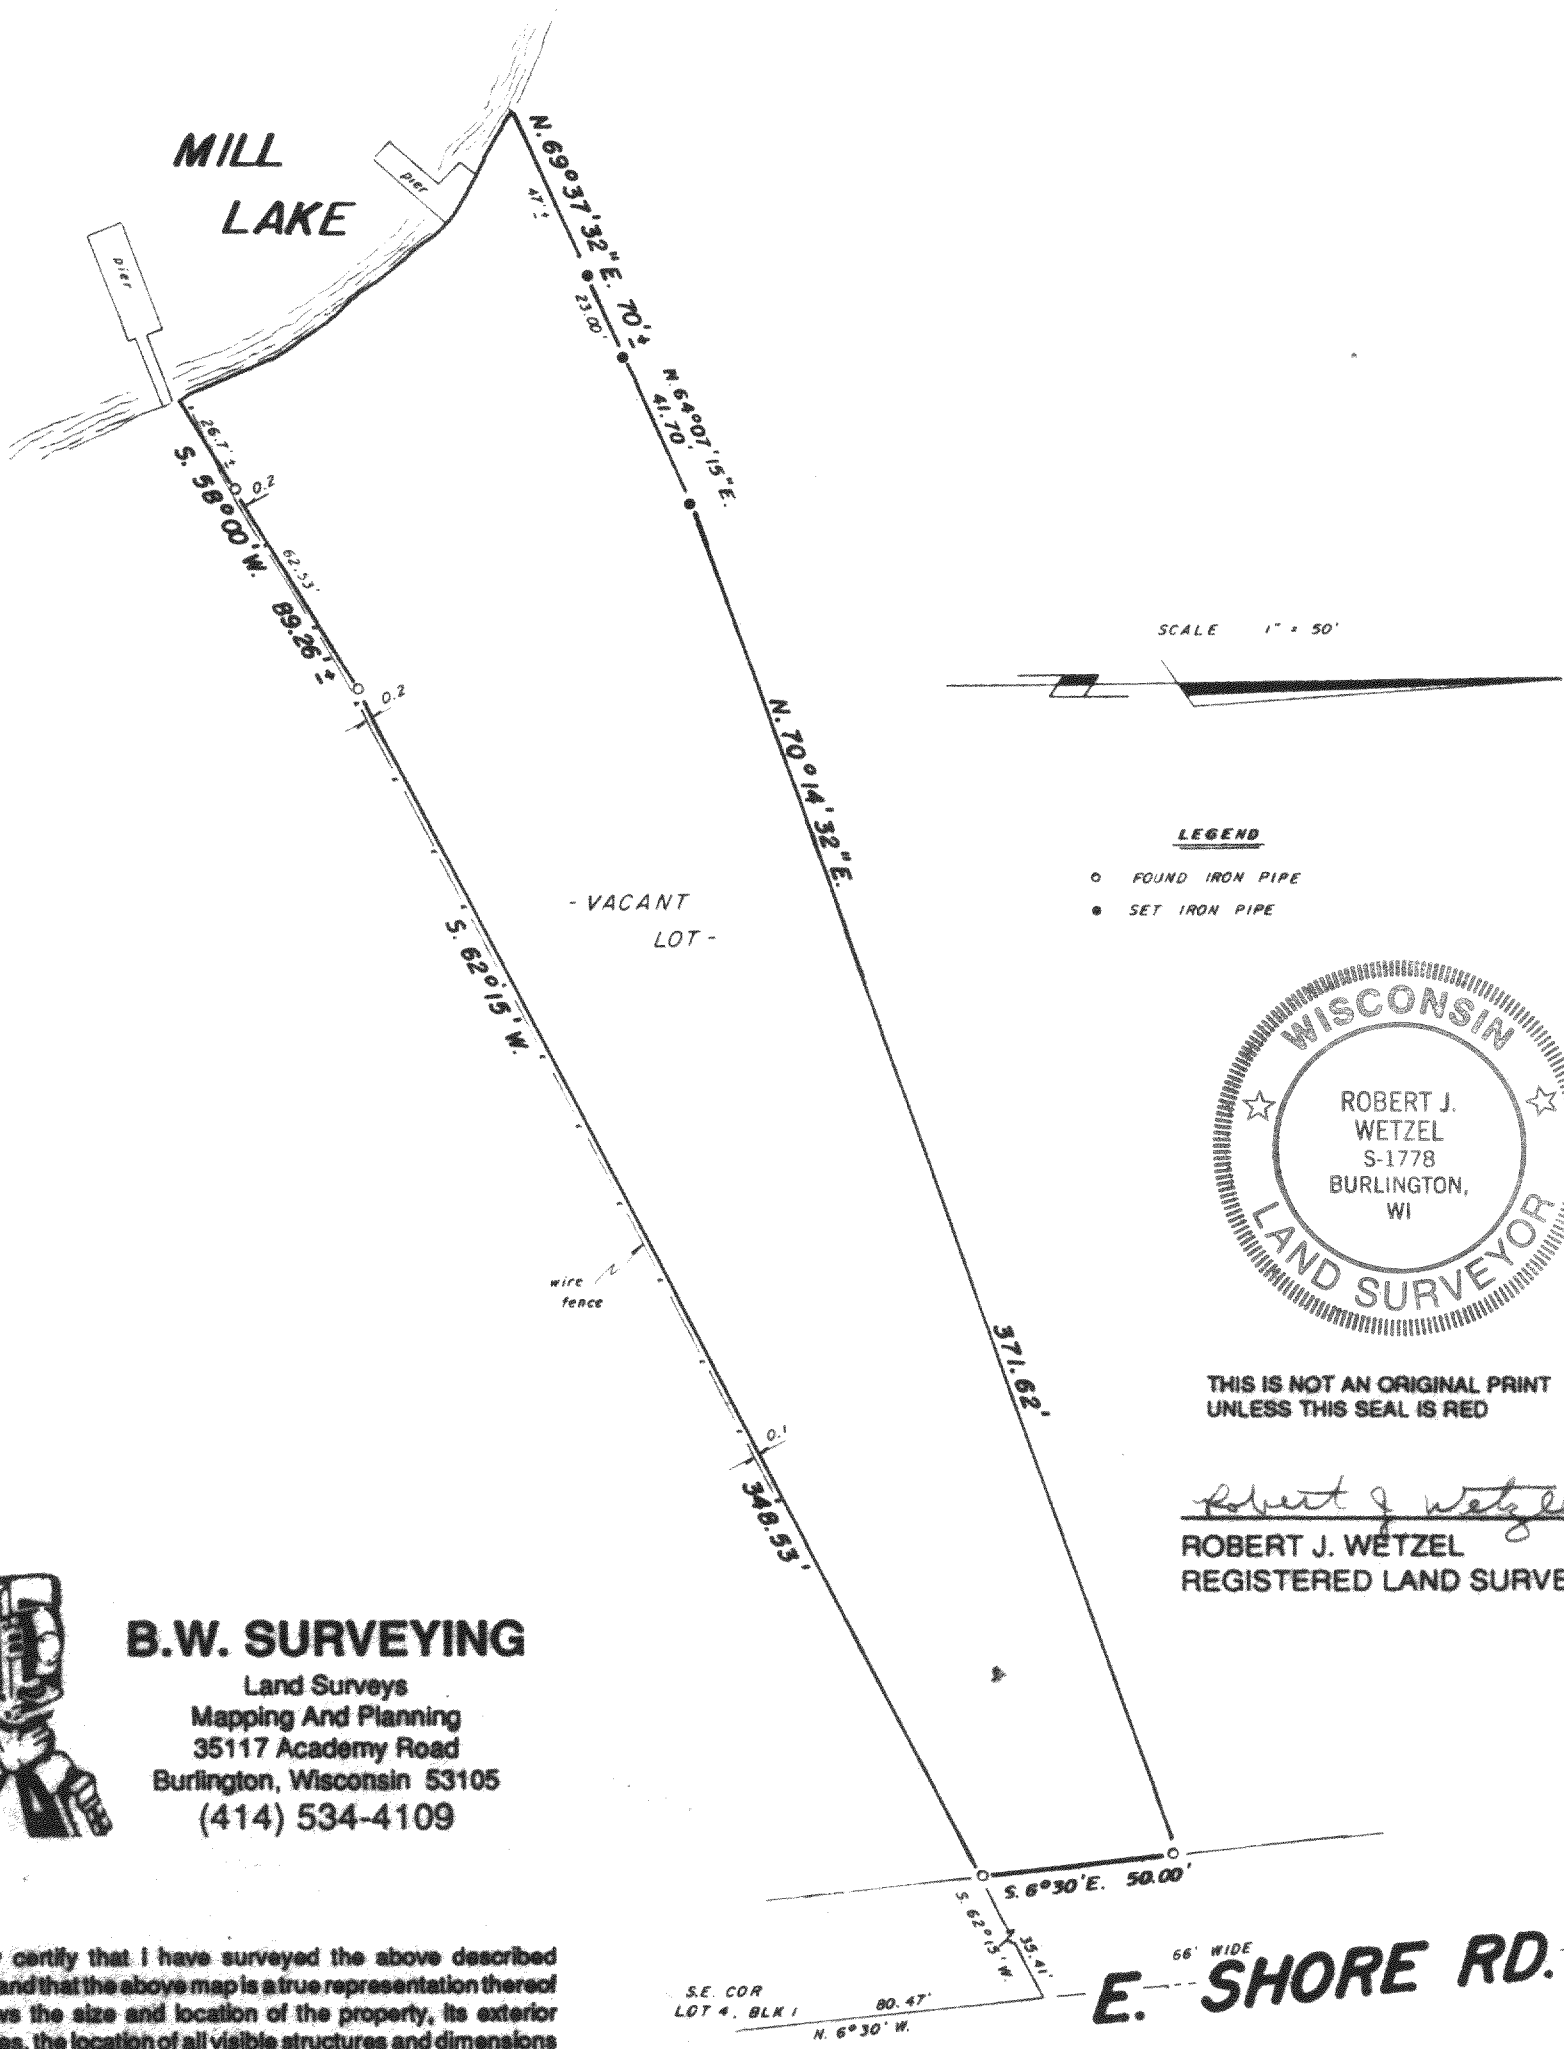


PLAT OF SURVEY
-OF-

LOT 1, CERTIFIED SURVEY MAP No. 1050, being a part of Block 1, Frees Park Sub-division, located in the South 1/2 of Section 4, Township 4 North, Range 18 East in the Town of East Troy, County of Walworth and State of Wisconsin.


Survey For: Pat Kline

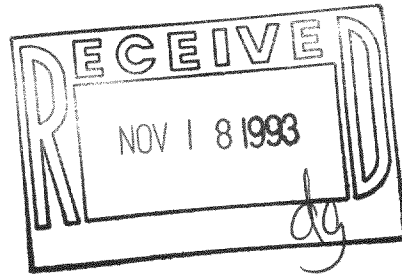

SCALE 1" = 50'


LEGEND

- FOUND IRON PIPE
- SET IRON PIPE

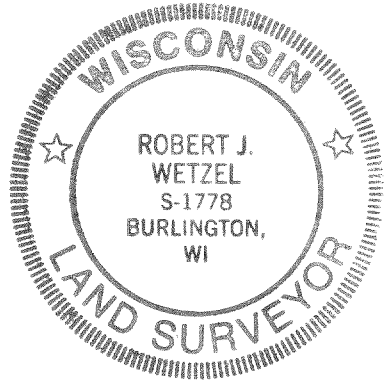

THIS IS NOT AN ORIGINAL PRINT
UNLESS THIS SEAL IS RED

Robert J. Wetzel
ROBERT J. WETZEL
REGISTERED LAND SURVEYOR - 1778

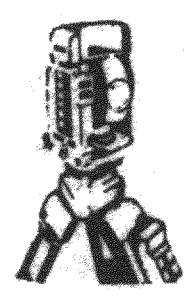

B.W. SURVEYING
Land Surveys
Mapping And Planning
35117 Academy Road
Burlington, Wisconsin 53105
(414) 534-4109

"I hereby certify that I have surveyed the above described property and that the above map is a true representation thereof and shows the size and location of the property, its exterior boundaries, the location of all visible structures and dimensions of all principal buildings thereon, boundary fences, apparent easements, roadways and encroachments, if any."

"This survey is made for the use of the present owners of the property, and those who purchase, mortgage, or guarantee the title thereto within one year from date hereof."

12/26/93
DATE

1404
JOB NUMBER

PA-1050-1

418-927