


Plat of Survey

of
Lot 1 of Certified Survey Map No. 27, located in the Northeast 1/4 of
Section 9, Town 4 North, Range 18 East, Town of East Troy, Walworth
County, Wisconsin.

Surveyed for: Urban Herriges & Sons Inc.
S107 W28580 Maple Avenue
Mukwonago, Wisconsin. 53149

Bearings referenced to C.S.M. 27.

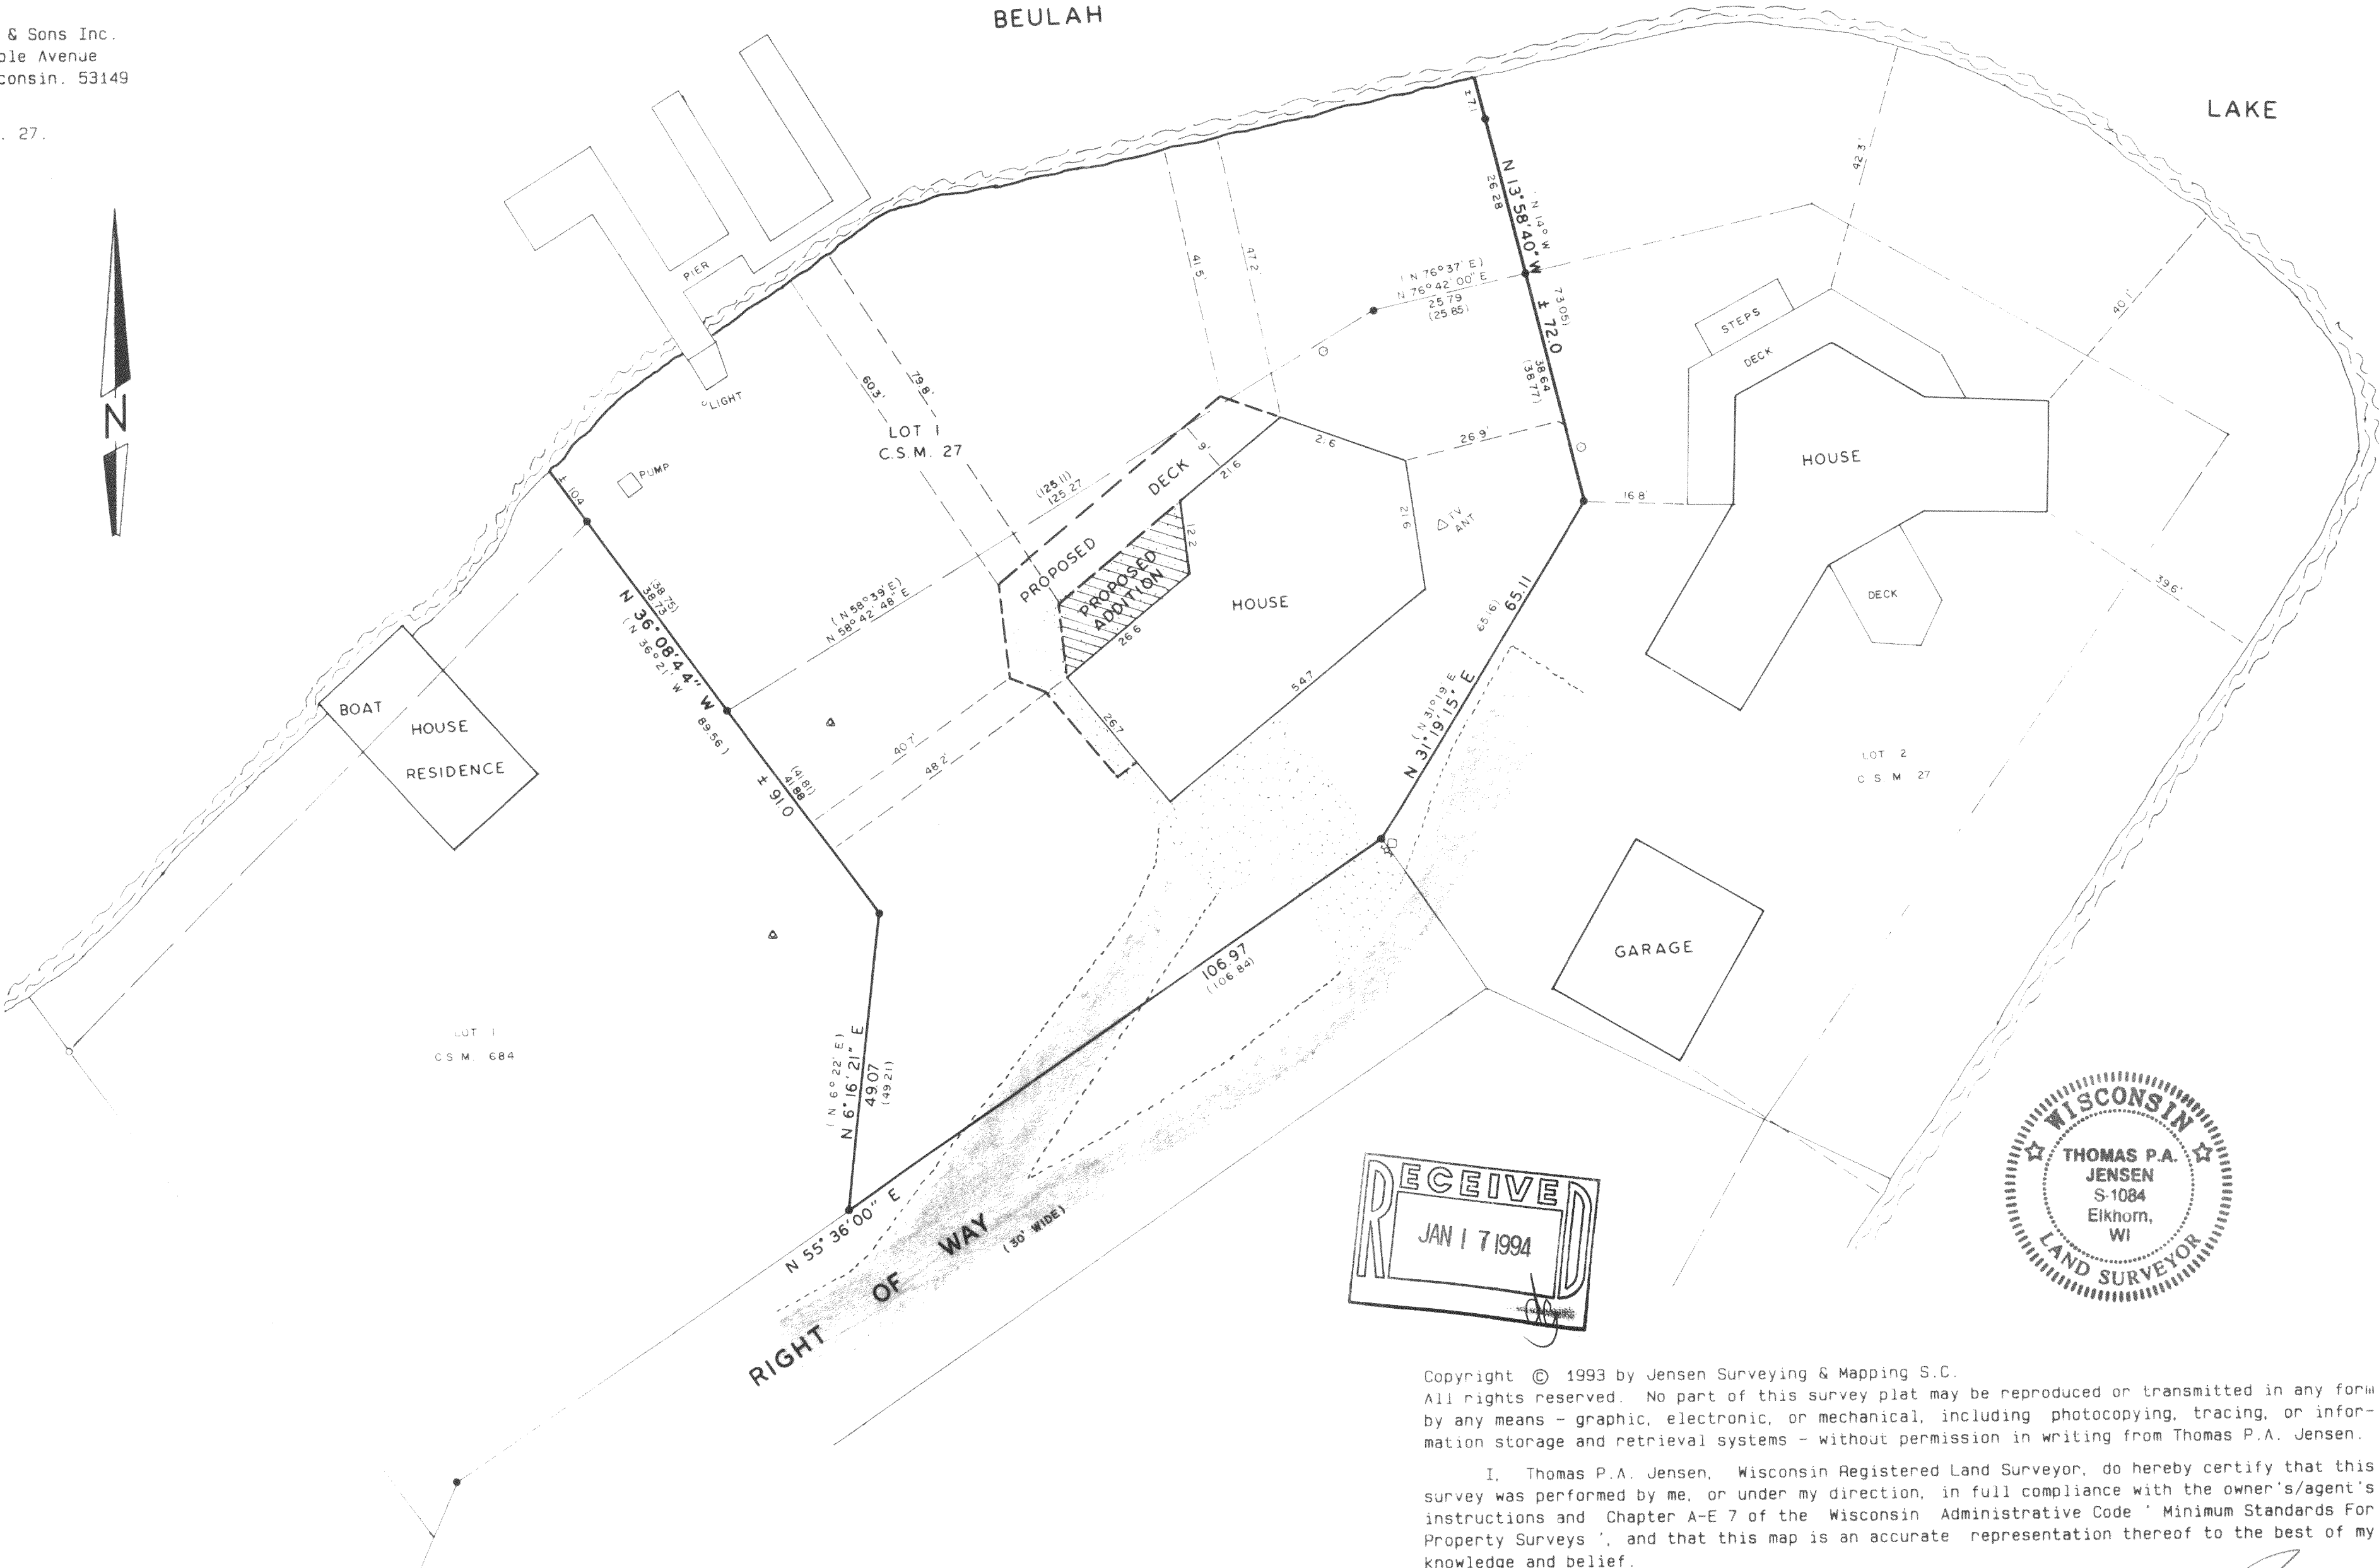

Copyright © 1993 by Jensen Surveying & Mapping S.C.
All rights reserved. No part of this survey plat may be reproduced or transmitted in any form
by any means - graphic, electronic, or mechanical, including photocopying, tracing, or infor-
mation storage and retrieval systems - without permission in writing from Thomas P.A. Jensen.

I, Thomas P.A. Jensen, Wisconsin Registered Land Surveyor, do hereby certify that this
survey was performed by me, or under my direction, in full compliance with the owner's/agent's
instructions and Chapter A-E 7 of the Wisconsin Administrative Code ' Minimum Standards For
Property Surveys ', and that this map is an accurate representation thereof to the best of my
knowledge and belief.

Note: This survey plat is not
certified unless signed
and sealed in red ink.


Thomas P.A. Jensen
Thomas P.A. Jensen R.L.S. 1084

Legend

- Found iron rod
- Found iron pipe
- () Recorded as dimension
- ⊙ Well
- ▲ Septic vent
- ▨ Concrete surface
- ▩ Blacktop surface

Jensen Surveying & Mapping S.C.

45 South Wisconsin Street P.O. Box 322
Elkhorn, Wisconsin. 53121.
(414) 723-3434

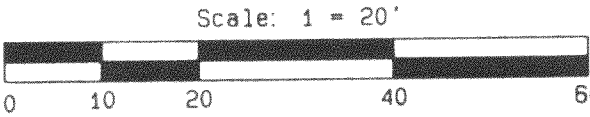

Mapping date: August 16, 1993.

Revisions: _____

Sheet 1 of 1 Sheets

Job reference number:
1993.085

PA27-1

418-938