

2554 N. 100TH STREET P.O. BOX 26596 **WAUWATOSA, WISCONSIN 53226** (414) 257-2212 FAX: (414) 257-2443


PLAT OF SURVEY

William J. Karpen RLS Terrance E. Pisarek RLS Frederick W. Shibilski RLS

LOTS 54 and 55, BLOCK 1, WILIMERS GROVE BEACH, lying and being in the East 1/2 of Section 18, Town 4 North, Range 18 East, according to the recorded plat thereof, Town of East Troy, Walworth County, Wisconsin.

Survey location: W2206 Wilmers Grove Road

Buyer: John & Diana Davis

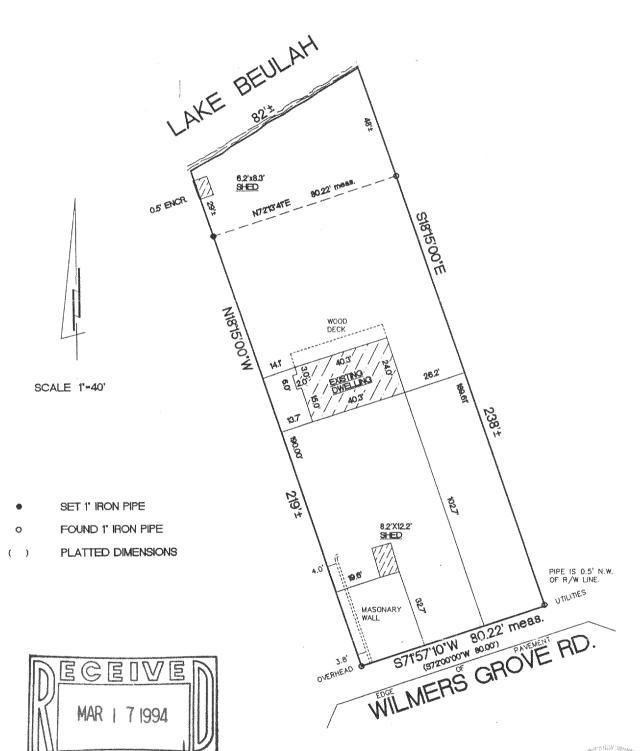

Surveyed for:

SECURITY MORTRGAGE CORP.

"I hereby certify that I have surveyed the above described property and that the above map is a true representation thereof and shows the size and location of the property, its exterior boundaries, the location of all visible structures and dimensions of all principal buildings thereon, boundary fences, apparent easements, roadways and encroachments, if any.

"This survey is made for the use of the present owners of the property, and also those who purchase, mortgage, or guarantee the title thereto within one year from date hereof."

MONUMENTATION BY AGREEMENT WITH THE ABOVE NAMED CLIENT HAS NOT BEEN WAIVED IN ACCORDANCE WITH A-E 7.01(2) OF THE WISCONSIN ADMINISTRATIVE CODE.



NOTE: THIS IS NOT AN ORIGINAL SURVEY UNLESS THIS SEAL IS RED.

4/5/93

TEP/DRG

TEP

24855 JOB NUMBER

WISCONSIN REGISTERED LAND SURVEYOR

DATE

FIELD WORK BY DRAWN BY