
PLAT OF SURVEY

LOCATION: 8749 Grand View Drive, East Troy, Wisconsin

LEGAL DESCRIPTION: Unit 3 of HIGHLAND VIEW ESTATES CONDOMINIUM, located in Section 17, Town 4 North, Range 18 East, Town of East Troy, Walworth County, Wisconsin.

May 28, 1994

Survey No. 1522-B

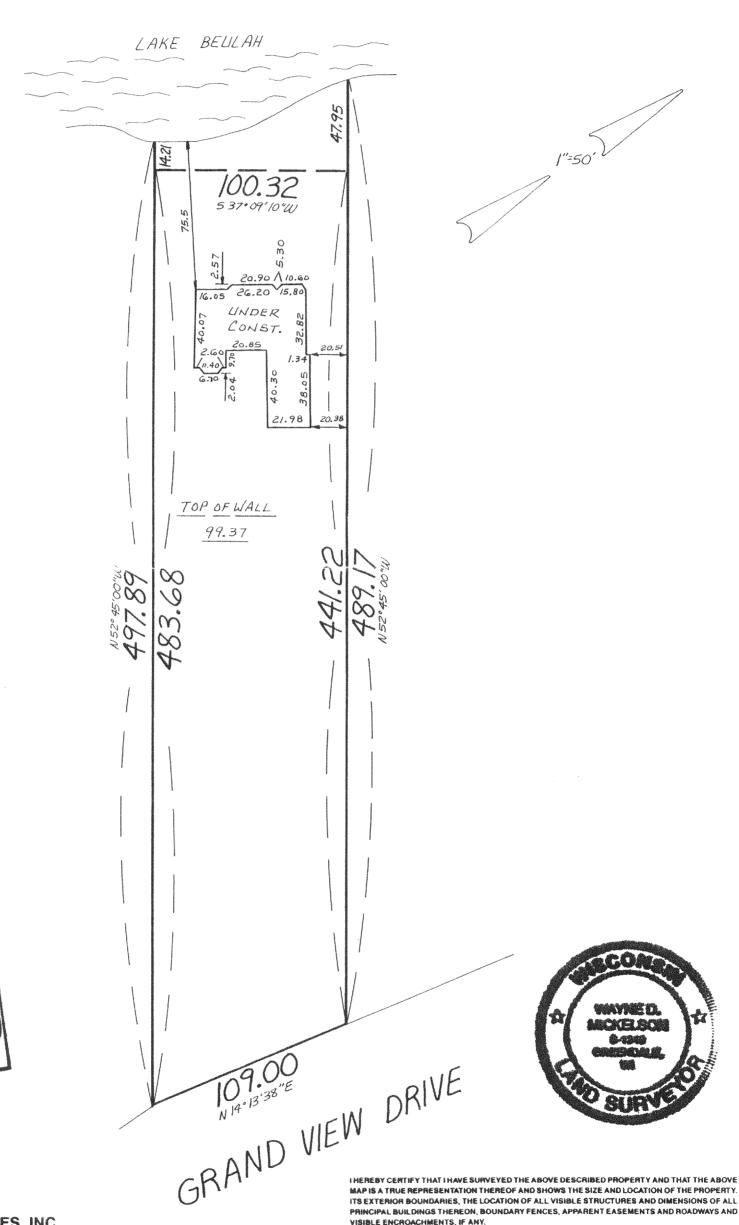

METROPOLITAN ENTERPRISES, INC.

JUN 1 4 1994

REGISTERED LAND SURVEYORS 9415 W. FOREST HOME AVE., SUITE 202, HALES CORNERS, WI 53130 FAX 529-9787 PH. 529-5380

THIS SURVEY IS MADE FOR THE EXCLUSIVE USE OF THE PRESENT OWNERS OF THE PROPERTY, AND ALSO THOSE WHO PURCHASE, MORTGAGE, OR QUARANTEE THE TITLE THERETO WITHIN ONE (1) YEAR

VISIBLE ENCROACHMENTS, IF ANY.

SIGNED THAT D. MICHELLAND

Wayne D. Mickelson

PAV-3