## FARRIS, HANSEN & ASSOCIATES, INC.

7 RIDGEWAY COURT, P.O. BOX 437 ELKHORN, WISCONSIN 53121

PHONE:

723-2098 (414)723-5886 (414)

LOCATION: LOTS 8+9 BLOCK I MIRAMAR SUBDIVISION

SECT. 10-4-18

WALWORTH COUNTY, WISCONSIN

ROBERT FOSCATO

MAP LEGEND

FAX:

O = IRON PIPE STAKE FOUND

= IRON PIPE STAKE SET

Y = IRON ROD STAKE FOUND

= IRON ROD STAKE SET


= CONCRETE MONUMENT FOUND

(XXXXXX)

= RECORD DIMENSION PREVIOUS PLAT


XXXXX

ORIGINAL SUBDIVISION PLAT RECORD

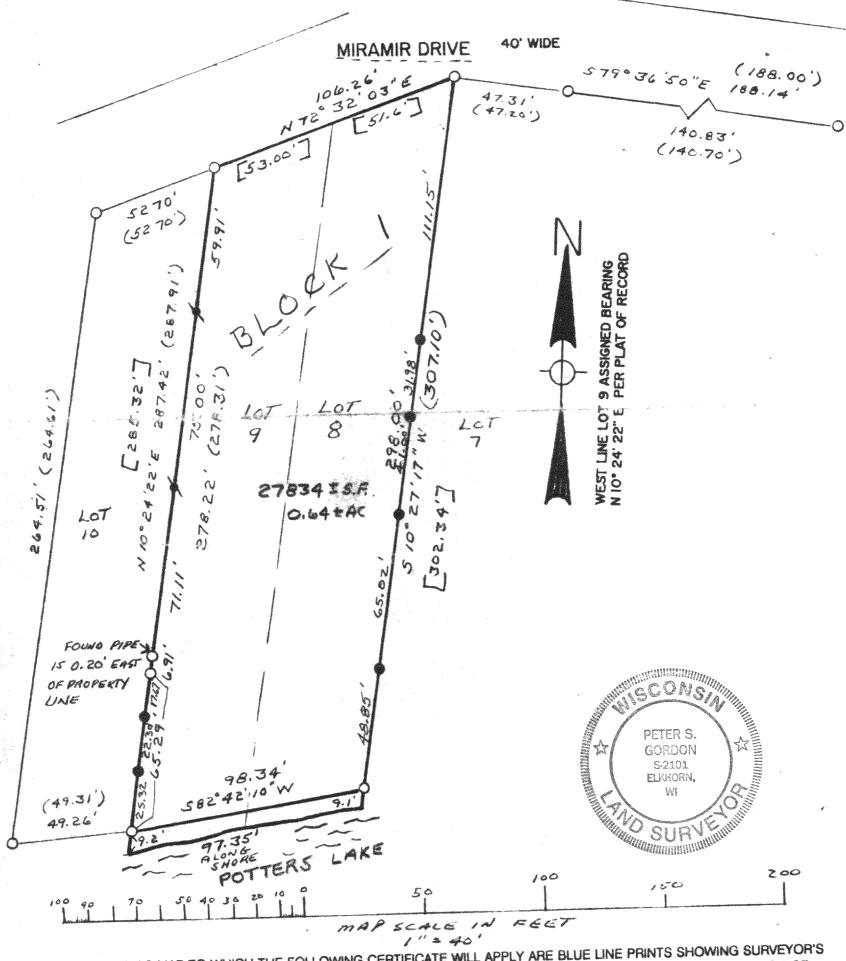

COPIES OF THIS MAP TO WHICH THE FOLLOWING CERTIFICATE WILL APPLY ARE BLUE LINE PRINTS SHOWING SURVEYOR'S ORIGINAL SEAL AND SIGNATURE IN BLACK INK. COPIES BY ANY OTHER MEANS MAY HAVE ALTERATIONS WHICH DO NOT NOTE: REPRESENT THE SURVEYOR'S WORK PRODUCT.

I HEREBY CERTIFY THAT THE ABOVE DESCRIBED PROPERTY HAS BEEN SURVEYED UNDER MY DIRECTION AND THAT THE ABOVE MAP IS A TRUE REPRESENTATION THEREOF AND SHOWS THE SIZE AND LOCATION OF THE PROPERTY AND ITS EXTERIOR BOUNDARIES. THIS SURVEY IS MADE FOR THE USE OF THE PRESENT OWNERS OF THE PROPERTY, AND ALSO THOSE WHO PURCHASE, MORTGAGE, OR GUARANTEE THE TITLE THERETO WITHIN ONE YEAR FROM THE DATE HEREOF.

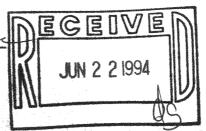

PROJECT NO. 3582