
## OF SURVEY

Sundberg, Carlson and Associates, Inc. chitects \* Engineers \* Land Surveyors \* Planners VIEW ROAD, MUKWONAGO, WISCONSIN 53148 (414) 363-2004

OWNER: JAMES L. SCHNEIDER

DATE: 1/19/94

DESCRIPTION: LOT 14 OF WILLIAMS PARK SUBDIVISION LOCATED IN SECTION 4, TOWNSHIP 4 NORTH, RANGE 18 EAST, TOWN OF EAST TROY, WALWORTH COUNTY, WISCONSIN, DESCRIBED AS FOLLOWS: BEGINNING AT THE INTERSECTION OF THE NORTH RIGHT OF WAY OF HORSESHOE LANE (33' R/W) AND THE WEST RIGHT OF WAY OF EAST SHORE ROAD (66' R/W); THENCE WITH THE NORTH RIGHT OF WAY OF HORSESHOE LANE \$87'59'00"W, A DISTANCE OF 214.23' TO A POINT; THENCE NO6'18'00"W, A DISTANCE OF 147.37' TO A POINT; THENCE N89'16'59"E, A DISTANCE OF 214.14' TO A POINT ON THE WEST RIGHT OF WAY OF EAST SHORE ROAD; THENCE \$06'30'21"E, ALONG SAID WEST RIGHT OF WAY OF EAST SHORE ROAD DISTANCE OF 142.54' TO THE POINT OF BEGINNING.

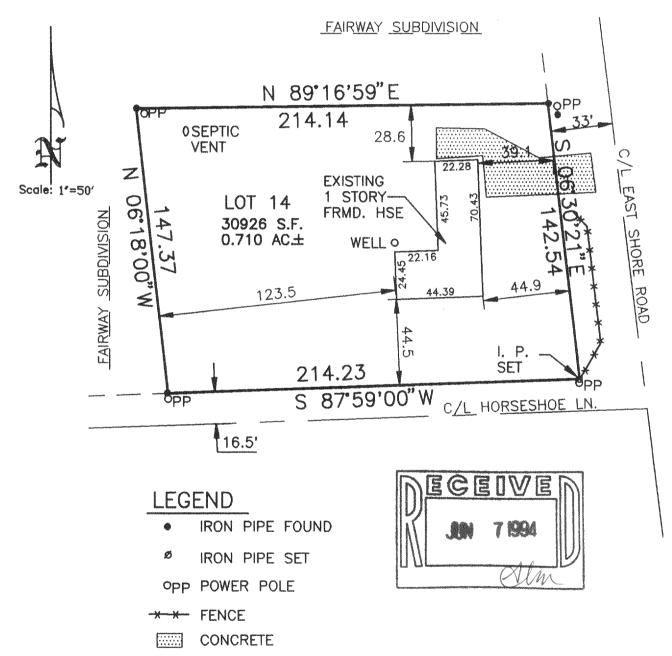

The above map is a true representation thereof and shows the size and location of all the property, exterior boundaries, the location of all visible boundary fences, apparent easements, roadways and visible encroachments, if any.

This survey is made for the use of the present owners of the property, and also those who purchase, mortgage or guarantee title thereto within one (1) year from date hereof.

THIS IS ORIGINAL PRINT ONLY IF SEAL IS IMPRINTED

IN RED

Bradford L. Spencer, R.L.S. 2069

#94022 PWP-15A1 SURVE IN

SCOVS

BRADFORD

SPENCER S-2069

MUKWONAGO

WIS.