

DESCRIPTION


Record of Survey.

OF SECTION, QUARTER SECTION AND QUARTER QUARTER SECTION CORNERS

No 348

LYONS


Township _____, North of Range 10-2-18 of 4 Principal Meridian
as presented by the courses and distances on the following plat, and annexed field-notes of survey:
Established the center of the section at the point of intersection of STRAIGHT corner lines.
Established all quarter-quarter corners upon the section boundary at proportional distances between known section and quarter section corners, according to the original field-notes of the Government survey.
Established all lost corners at proportionate distances between known corners, according to the original field notes of the Government survey.

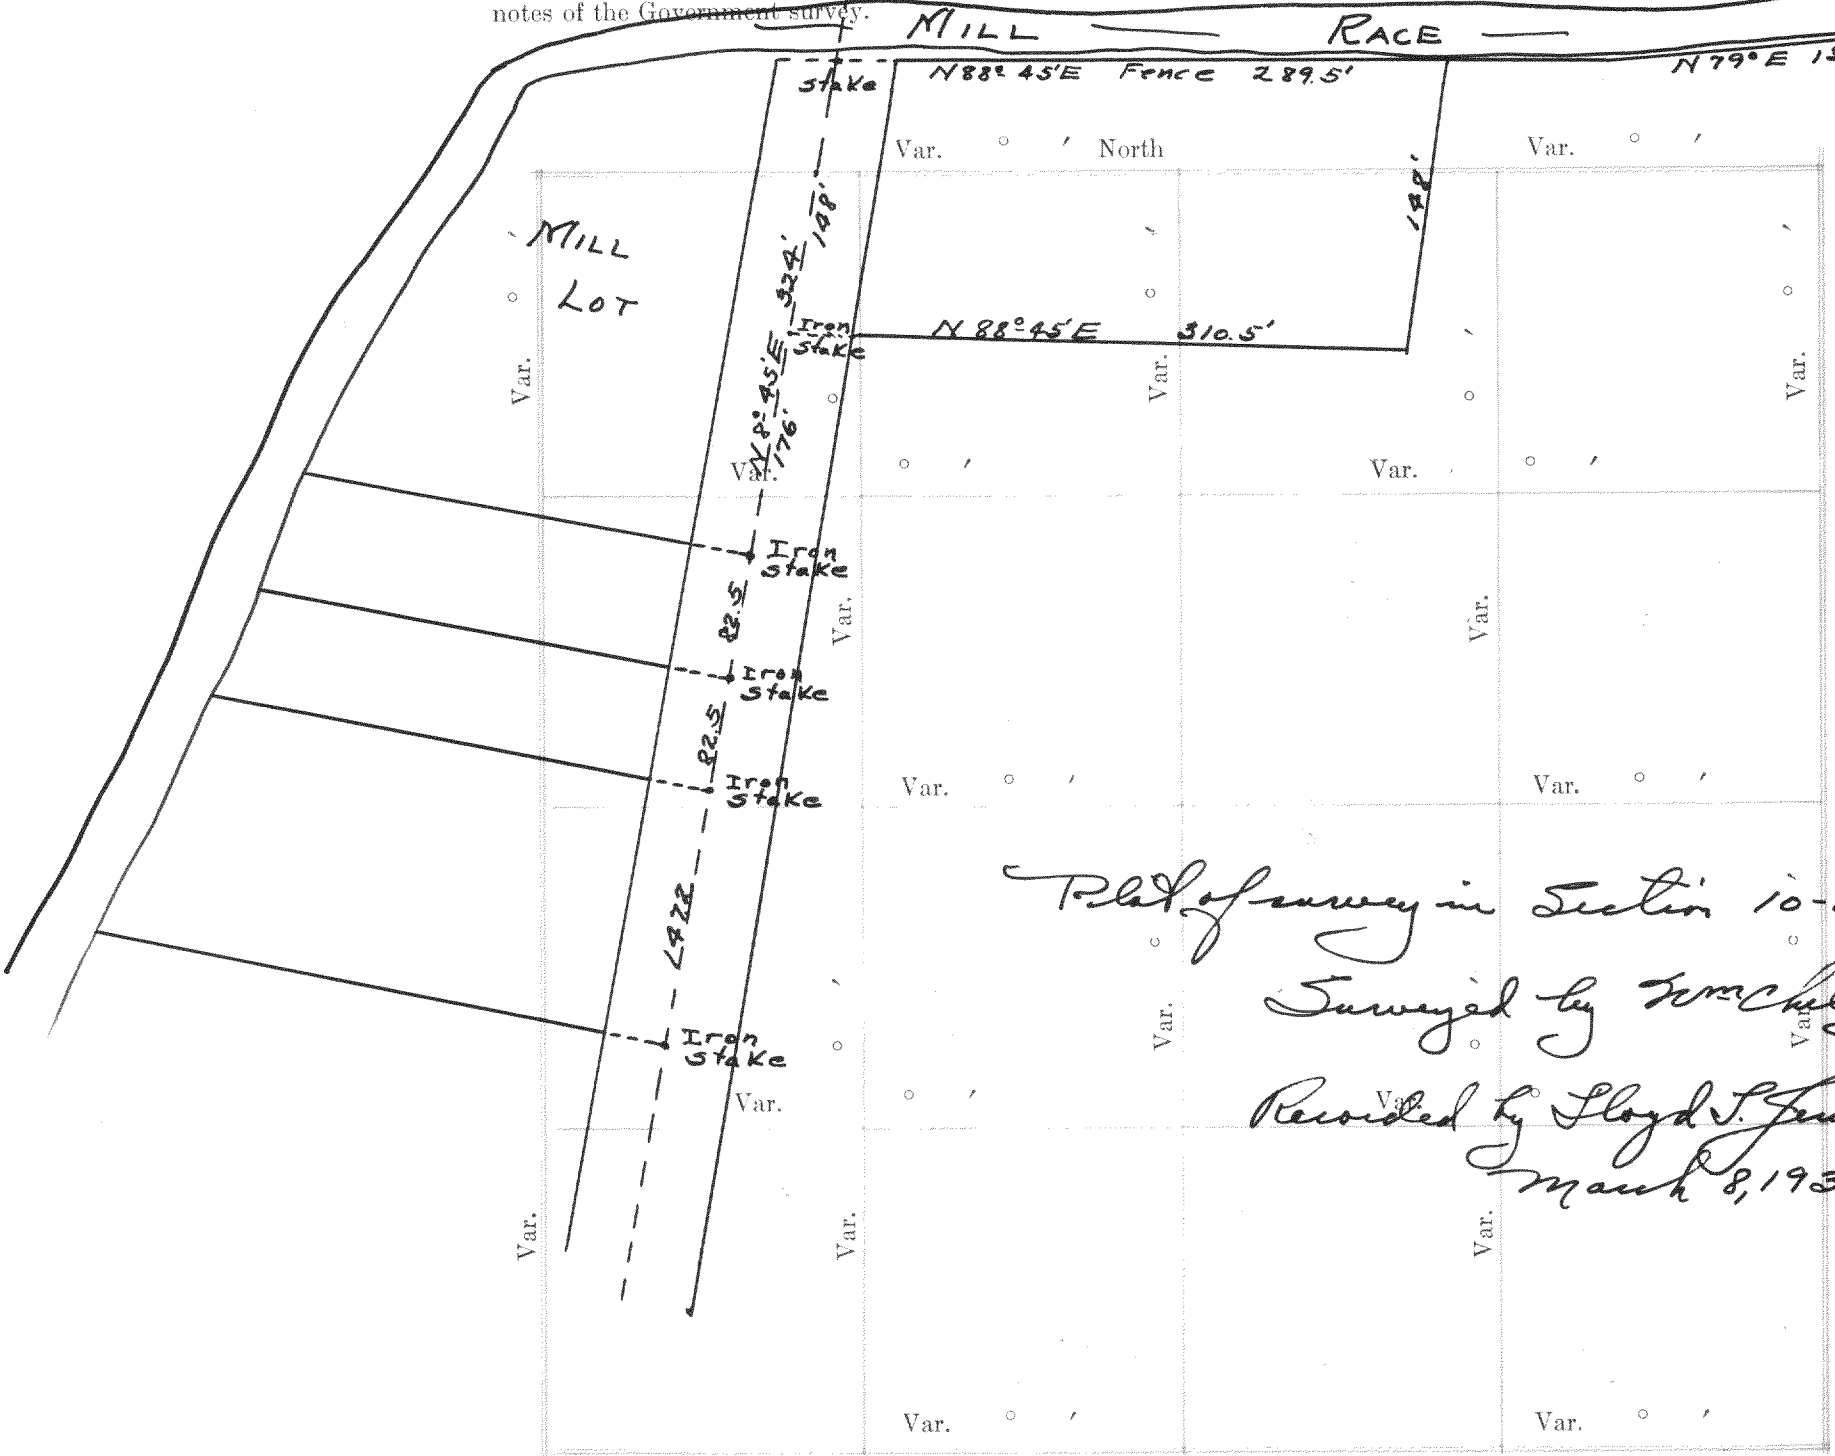

- GOVERNMENT CORNERS
- 1. N. W. Sec. Cor. identified,
 - 2. N. E. Sec. Cor. identified,
 - 3. S. E. Sec. Cor. identified,
 - 4. S. W. Sec. Cor. identified,
 - 5. N. 1/4 Sec. Cor. identified,
 - 6. E. 1/4 Sec. Cor. identified,
 - 7. S. 1/4 Sec. Cor. identified,
 - 8. W. 1/4 Sec. Cor. identified,

- Subdivision Corners
- 1. Center 1/4 Sec. Cor.
 - 2. North 1/4-1/4s N. W. qr.,
 - 3. East 1/4-1/4s N. W. qr.,
 - 4. South 1/4-1/4s N. W. qr.,
 - 5. West 1/4-1/4s N. W. qr.,
 - 6. Center 1/4-1/4s N. W. qr.,
 - 7. North 1/4-1/4s N. E. qr.,
 - 8. East 1/4-1/4s N. E. qr.,
 - 9. South 1/4-1/4s N. E. qr.,
 - 10. Center 1/4-1/4s N. E. qr.,
 - 11. East 1/4-1/4s S. E. qr.,
 - 12. South 1/4-1/4s S. E. qr.,
 - 13. West 1/4-1/4s S. E. qr.,
 - 14. Center 1/4-1/4s S. E. qr.,
 - 15. South 1/4-1/4s S. W. qr.,
 - 16. West 1/4-1/4s S. W. qr.,
 - 17. Center 1/4-1/4s S. W. qr.,

Bearing	In.	Courses	Links	Bearing	In.	Courses	Links	Bearing	In.	Courses	Links	Bearing	In.	Courses	Links
Trees	Dia.	they bear	Distant	Trees	Dia.	they bear	Distant	Trees	Dia.	they bear	Distant	Trees	Dia.	they bear	Distant

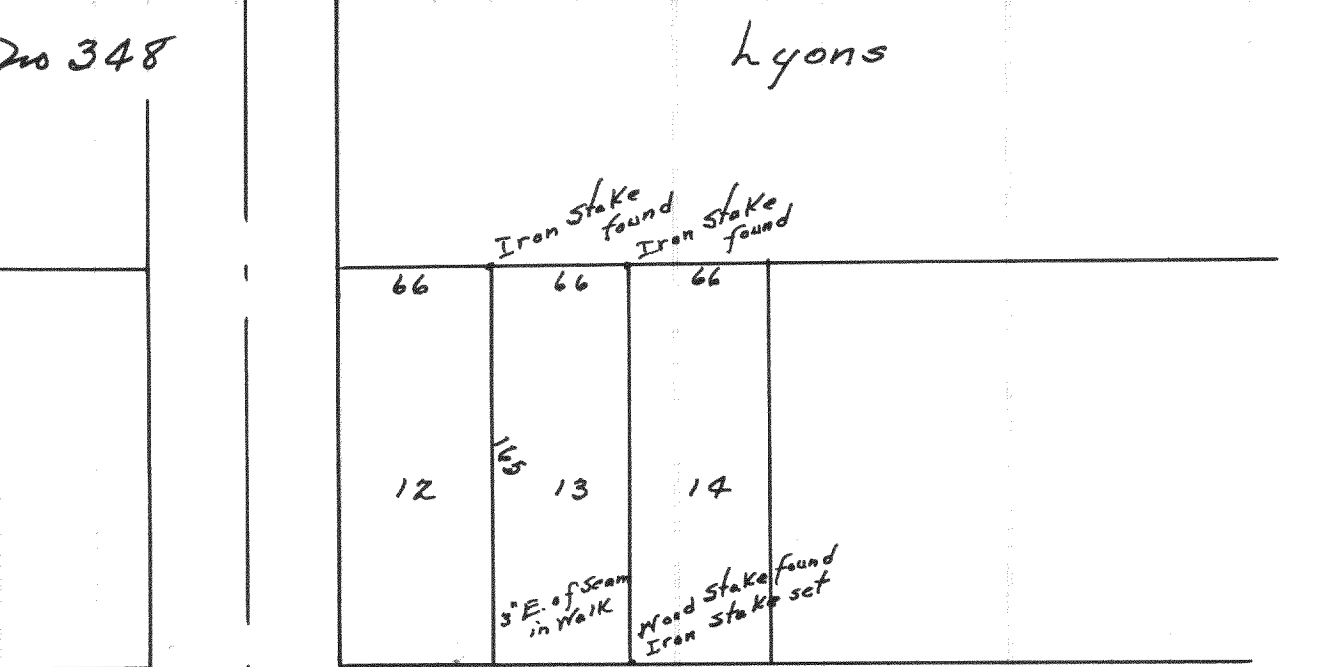

Plat of survey in Section 10-2-18.
add. to the village of Lyons.

Surveyed by Marshall CS.

Recorded by Lloyd J. Jensen CS.
March 8, 1934

Plat of Section _____, Township _____, North, Range _____ of 4 Principal Meridian Scale
80 chains to 6 inches. The figures in red ink are the lengths of the lines as stated in the field-notes of the
Government survey.

Declination of the Magnetic Meridian from the True Meridian _____
Surveyed and sub-divided _____ A. D. 1 _____, in accordance
with the State Laws and Instructions of the Commissioner of the General Land office, and recorded on pages
_____ of Register in the County Clerk's office.

Witness my hand this _____ day of _____ A. D. 1 _____

SURVEYOR.

NAMES OF SWORN ASSISTANTS

CHAINMEN FLAGMEN AXMEN

no. 349

1-1-16

Ben. Hodge

Found old stake at SW corner of block 5 of Wm Bay, also stakes and stake holes of lots on West line of block, and as angle stake in road is gone, I set stake at 65 + 38.35 north from iron stake found at corner of lot. Produced the west line of block South 70 feet and find stake hole and set iron stake from this stake, west on line to point on $\frac{1}{8}$ line 247.5 feet = 3.75 chains north of $\frac{1}{8}$ post 66 feet and set monument for corner of plot. Then west 237.6 feet to $\frac{1}{8}$ line and set monument north on $\frac{1}{8}$ line 70 and set iron stake for northwest corner of lot 4 and Southwest of lot 3. Then 263.5 feet more to center of road 11.6 feet northeast at Red cedar stake at angle at road. Set monument northeast 118.5 feet being point 102.1 from monument at Right angle to $\frac{1}{8}$ post.

Surveyed by Wm Child
CS.

Recorded by Lloyd S. Jensen
CS.
March 8, 1934

no. 350

Wm Bay

Judge Lym

West end $3 \times 94 + 12 = 294 - 24.7 = 269.3 \frac{1}{4}$
line, from $\frac{1}{4}$ line to fence 269.3, $\frac{1}{8}$ line
East to corner of piece 722. North from
fence 267 post 291.7 quarter line, West
716.3 to $\frac{1}{8}$ corner.

Surveyed by Wm Child
CS.

Recorded by Lloyd S. Jensen
CS.
March 8, 1934