

no 376

Record of Survey.


FONTANA

Township....., North of Range..... of 4 Principal Meridian
as presented by the courses and distances on the following plat, and annexed field-notes of survey:

Established the center of the section at the point of intersection of STRAIGHT quarter lines.

Established all quarter-quarter corners upon the section boundary at proportional distances between known section and quarter section corners, according to the original field-notes of the Government survey.

Established all lost corners at proportionate distances between known corners, according to the original field notes of the Government survey.

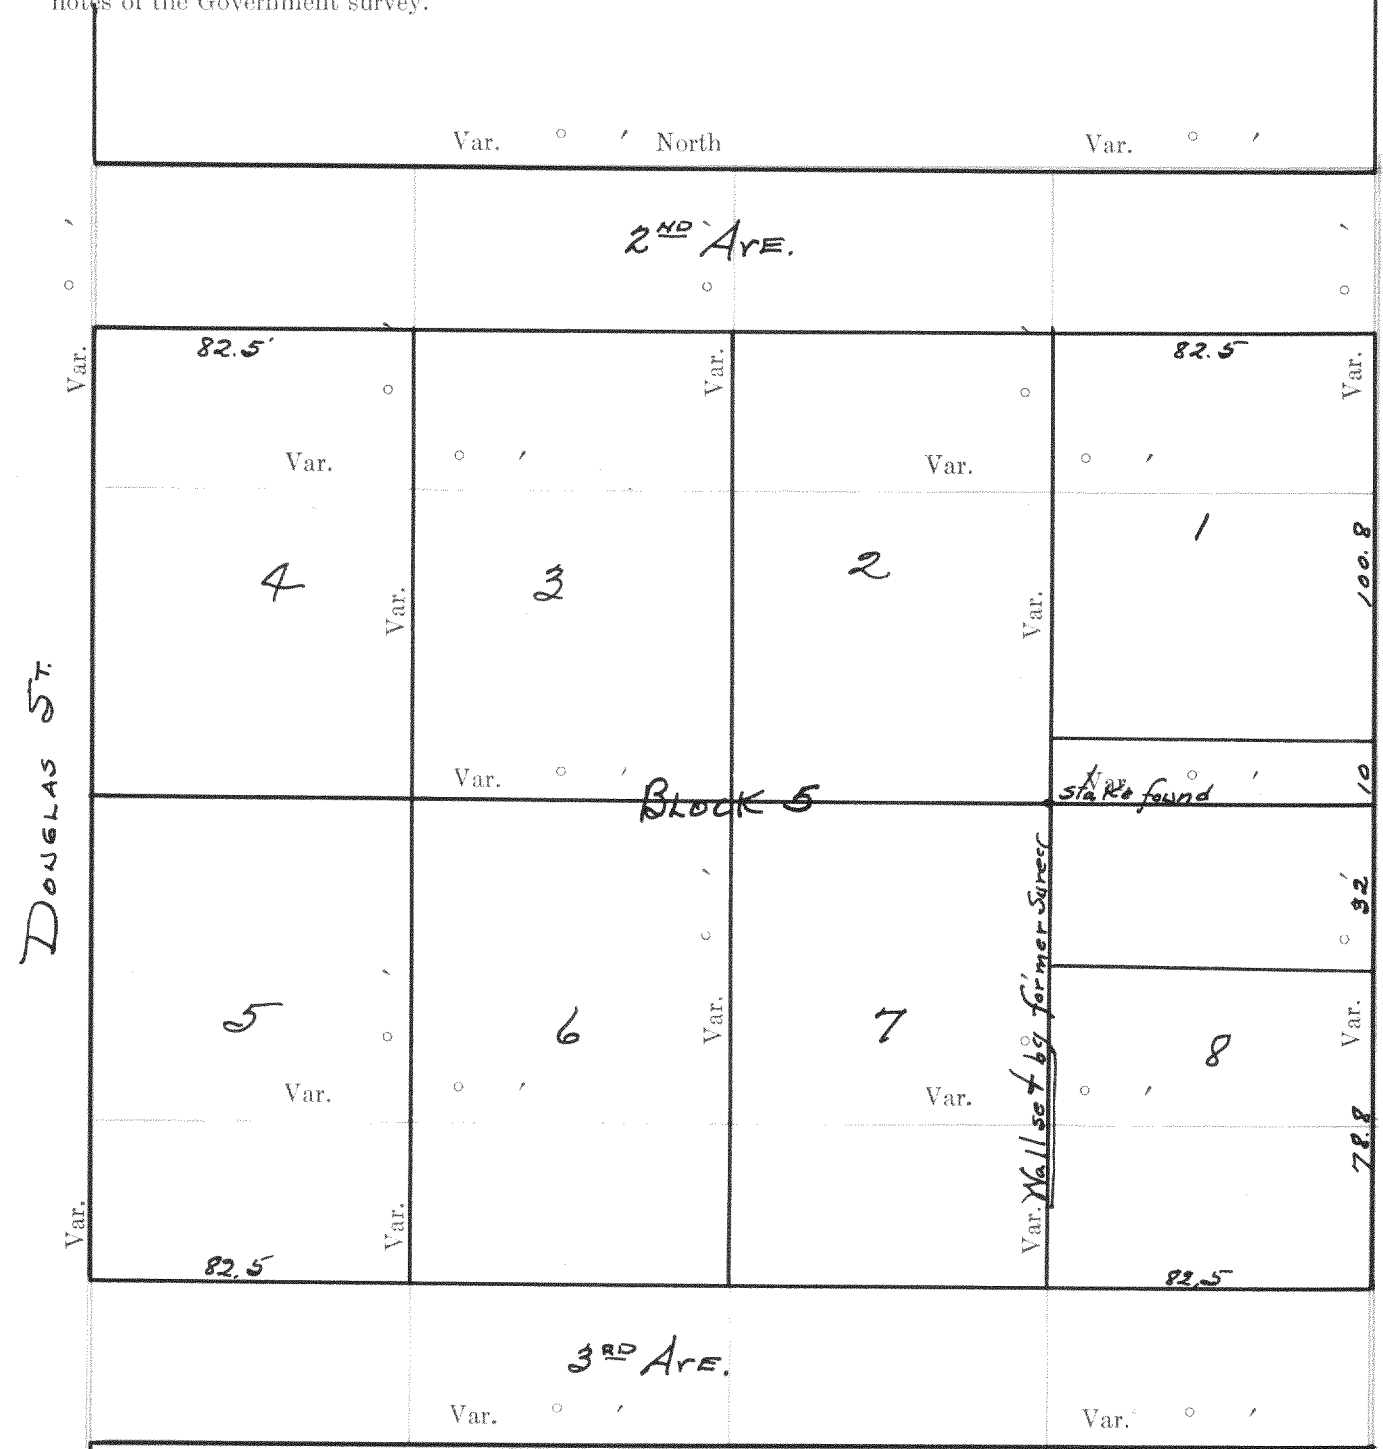

Plat of Section....., Township..... North, Range..... of 4 Principal Meridian Scale
80 chains to 6 inches. The figures in red ink are the lengths of the lines as stated in the field-notes of the
Government survey.

Declination of the Magnetic Meridian from the True Meridian.....

Surveyed and sub-divided..... in accordance with the State Laws and Instructions of the Commissioner of the General Land office, and recorded on pages.....

..... of Register in the County Clerk's office.

Witness my hand this..... day of..... A. D. 1

Recorded by Lloyd S. Jensen
March 14, 1934

SURVEYOR.

DESCRIPTION


OF SECTION, QUARTER SECTION AND QUARTER QUARTER SECTION CORNERS

GOVERNMENT CORNERS				H. C. MILLER CO., MFG. STATIONERS, MILWAUKEE WISCONSIN												
	Bearing	In.	Courses	Links	Bearing	In.	Courses	Links	Bearing	In.	Courses	Links	Bearing	In.	Courses	Links
	Trees	Dia.	they bear	Distant	Trees	Dia.	they bear	Distant	Trees	Dia.	they bear	Distant	Trees	Dia.	they bear	Distant

- No.
1. N. W. Sec. Cor. identified,
 2. N. E. Sec. Cor. identified,
 3. S. E. Sec. Cor. identified,
 4. S. W. Sec. Cor. identified,
 5. N. 1/4 Sec. Cor. identified,
 6. E. 1/4 Sec. Cor. identified,
 7. S. 1/4 Sec. Cor. identified,
 8. W. 1/4 Sec. Cor. identified,

Subdivision Corners

- No.
1. Center 1/4 Sec. Cor.
 2. North 1/4-1/4s N. W. qr.,
 3. East 1/4-1/4s N. W. qr.,
 4. South 1/4-1/4s N. W. qr.,
 5. West 1/4-1/4s N. W. qr.,
 6. Center 1/4-1/4s N. W. qr.,
 7. North 1/4-1/4s N. E. qr.,
 8. East 1/4-1/4s N. E. qr.,
 9. South 1/4-1/4s N. E. qr.,
 10. Center 1/4-1/4s N. E. qr.,
 11. East 1/4-1/4s S. E. qr.,
 12. South 1/4-1/4s S. E. qr.,
 13. West 1/4-1/4s S. E. qr.,
 14. Center 1/4-1/4s S. E. qr.,
 15. South 1/4-1/4s S. W. qr.,
 16. West 1/4-1/4s S. W. qr.,
 17. Center 1/4-1/4s S. W. qr.

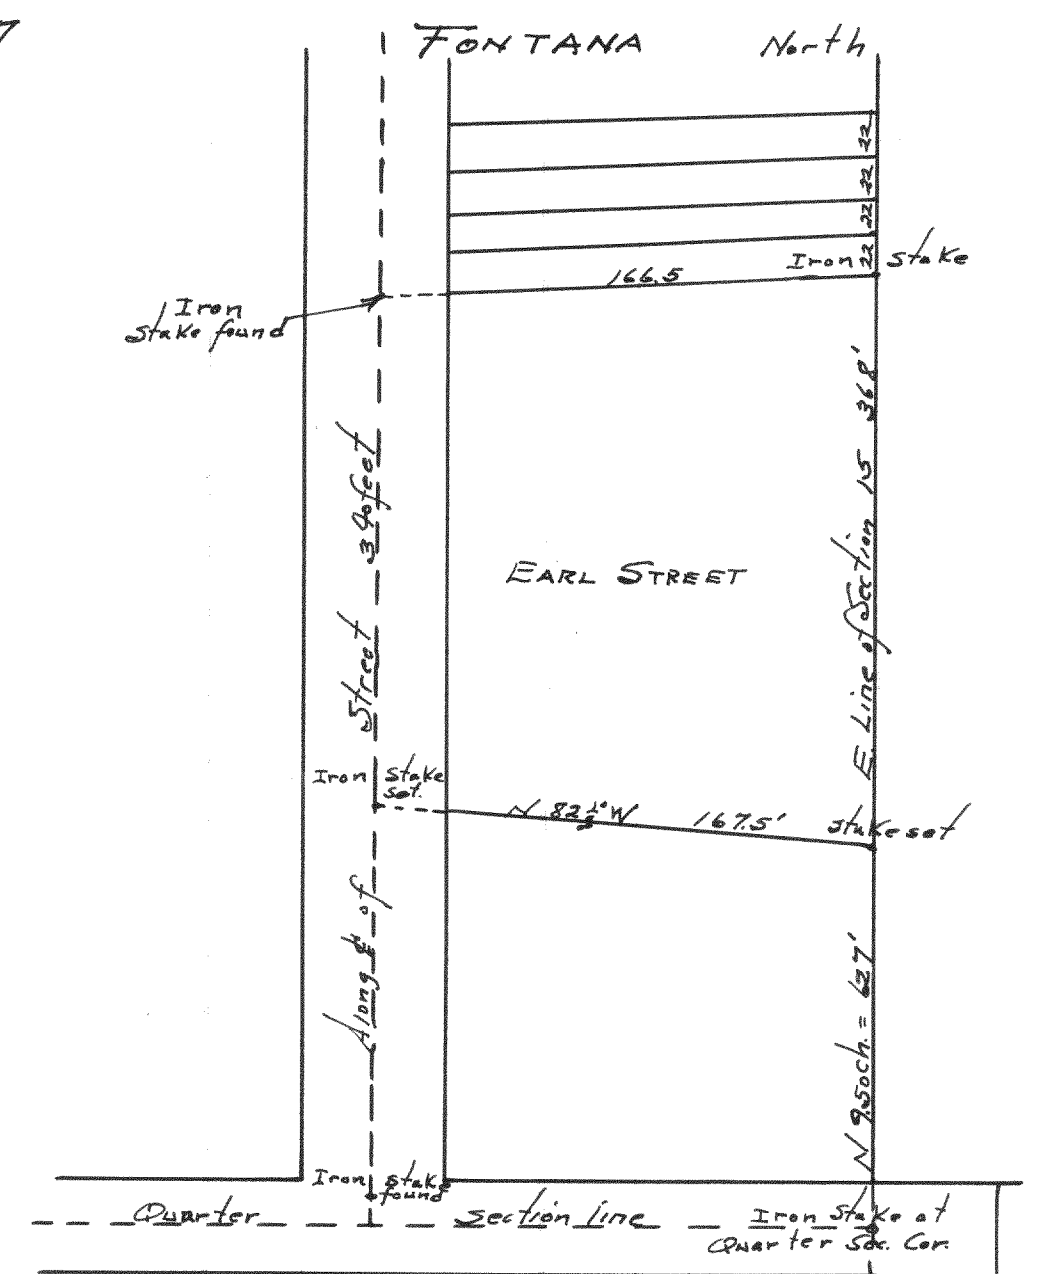

Plot of survey made for Earl Street on
The NE 1/4 of section 15, T1N, R16E, being
The Township of Walworth, Walworth Co.,
Wisconsin, and being also at the
Village of Fontana


Attest March 13th, 1922
Wm. Child

Recorded by Lloyd S. Jensen
March 14, 1934

NAMES OF SWORN ASSISTANTS
FLAGMEN
AXMEN

125

no 378

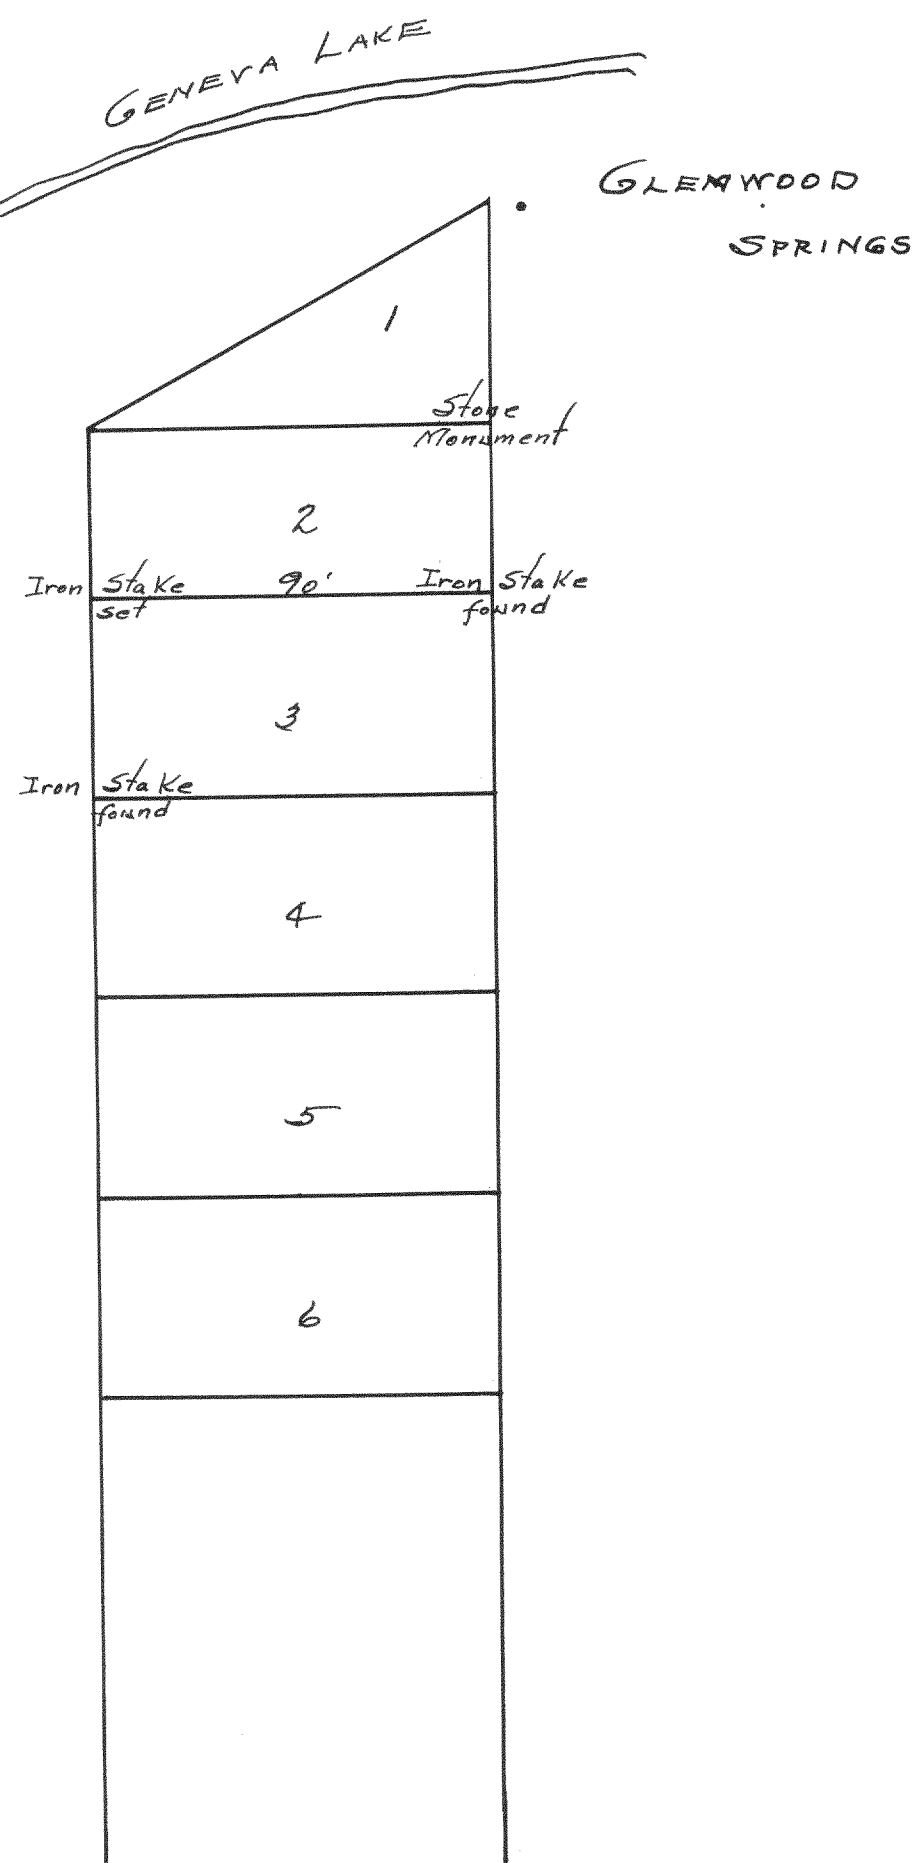


Plot of a survey made for A.C. Turner of Chicago to relocate the corners of lots in block no 1 of the Plot of Glenwood Springs located on Geneva Lake

Surveyed by Wm Child^{CS}

Recorded by Lloyd S. Jensen^{CS}
March 14, 1934

no 379

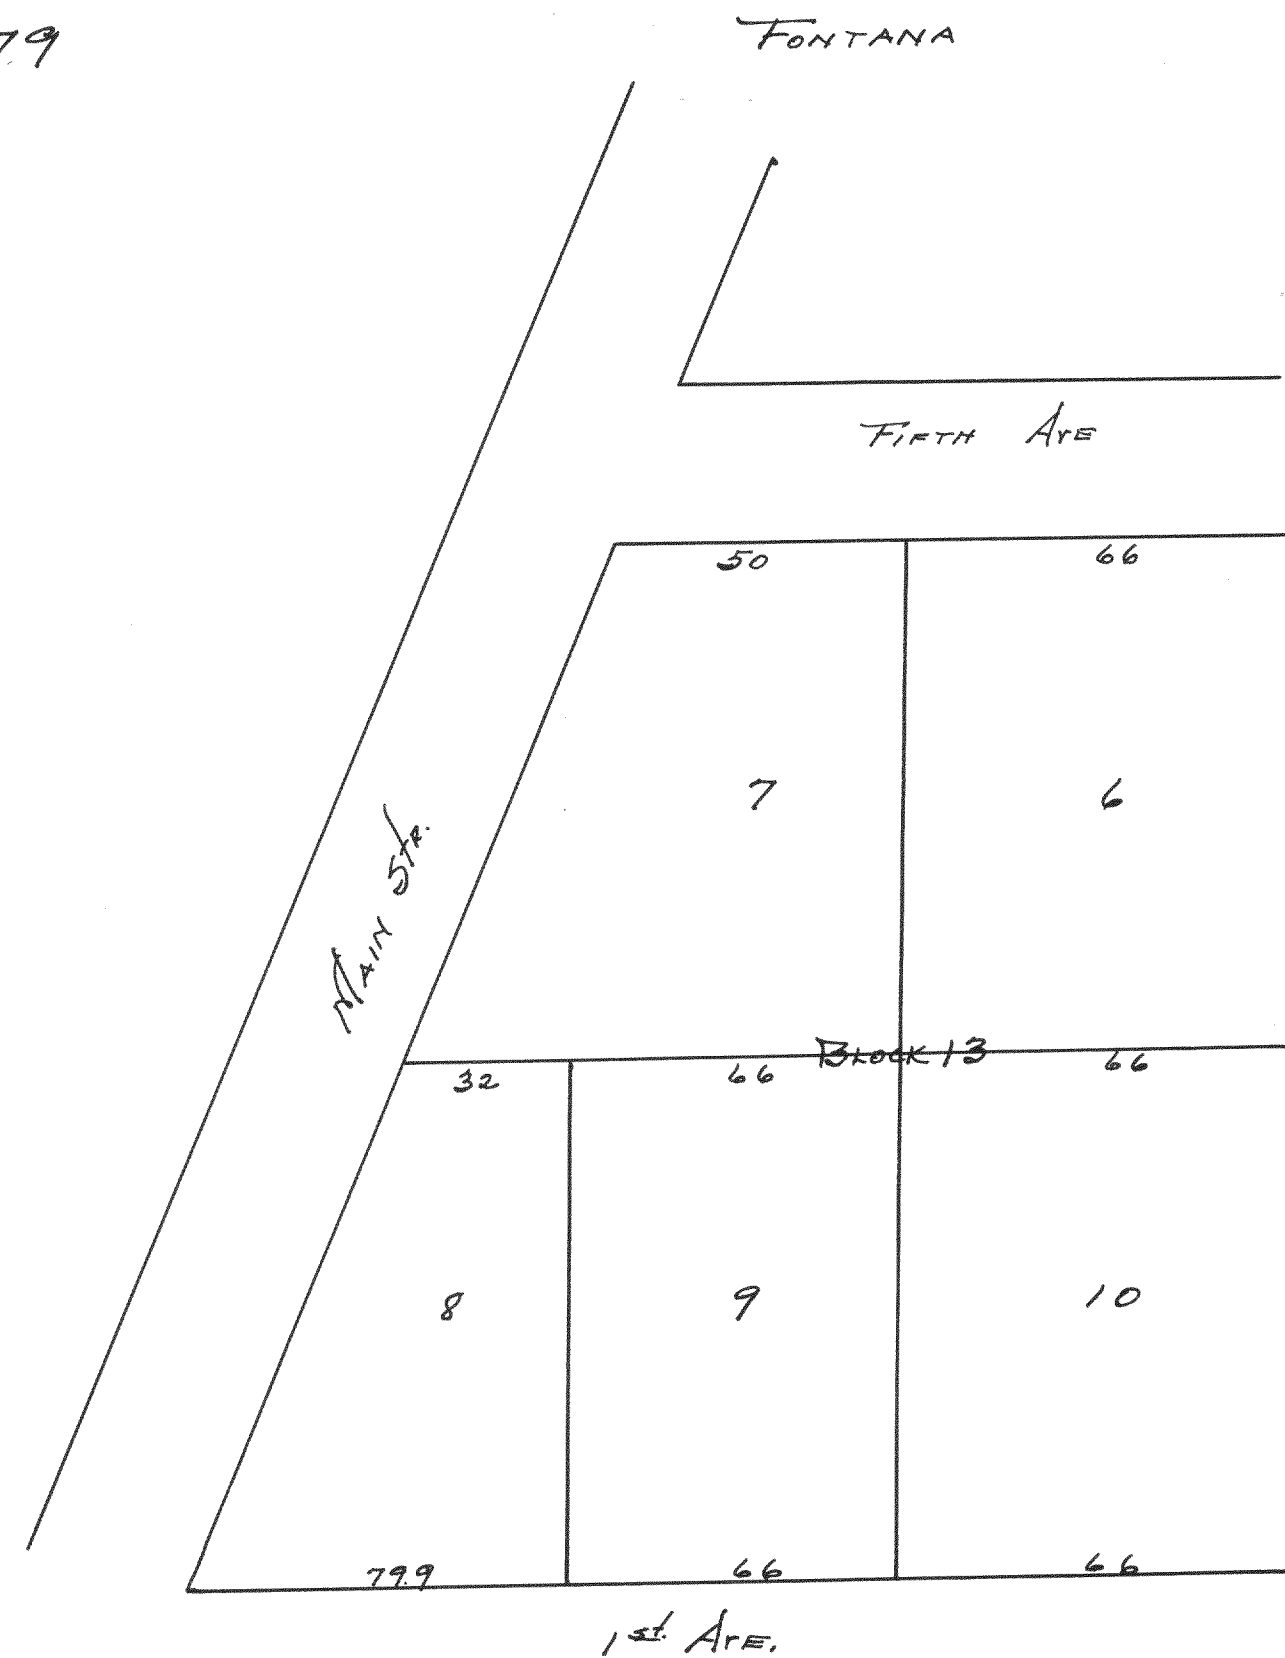

Plot of a survey in Blk. 13 of
The Village of Fontana, Walworth Co.
Wisconsin.

Surveyed by Wm Child^{CS}

Recorded by Lloyd S. Jensen^{CS}
March 14, 1934