

DESCRIPTION

Record of Survey.


OF SECTION, QUARTER SECTION AND QUARTER QUARTER SECTION CORNERS

no 409

26-4-16

Township.....*Resurvey of part of Casswell's Road*.....North, Range.....of 4 Principal Meridian
as presented by the courses and distances on the following plat, and annexed field-notes of survey:

Established the center of the section at the point of intersection of STRAIGHT quarter lines.
Established all quarter-quarter corners upon the section boundary at proportional distances between known
quarter and quarter section corners, according to the original field-notes of the Government survey.
Established all lost corners at proportionate distances between known corners according to the original field
notes of the Government survey.
Beginning at an iron stake on the north and south
quarter section line of Section No. 35, T4N, R16E, being
the town of La Chang, Walworth County, Wisconsin,
531 feet South of the Southwest corner of Block no. 2 in
the recorded plat of Loris land, which plat is on record
in the registers of Deeds Office in and for said Walworth
County, in Volume 5 of plats on page 121, and being also
48 feet north of a line line; Thence South 70° 50' W, 415
feet to an iron stake; Thence S 39° 15' W 110 feet to an
iron stake; Thence S 19° 38' W 400 feet to an iron stake
and 38° 45' E 250 feet to an iron stake 25 feet East
of the north west corner of that certain piece or parcel of
land conveyed by Fred Schoenbeck and wife to
N. Casswell.

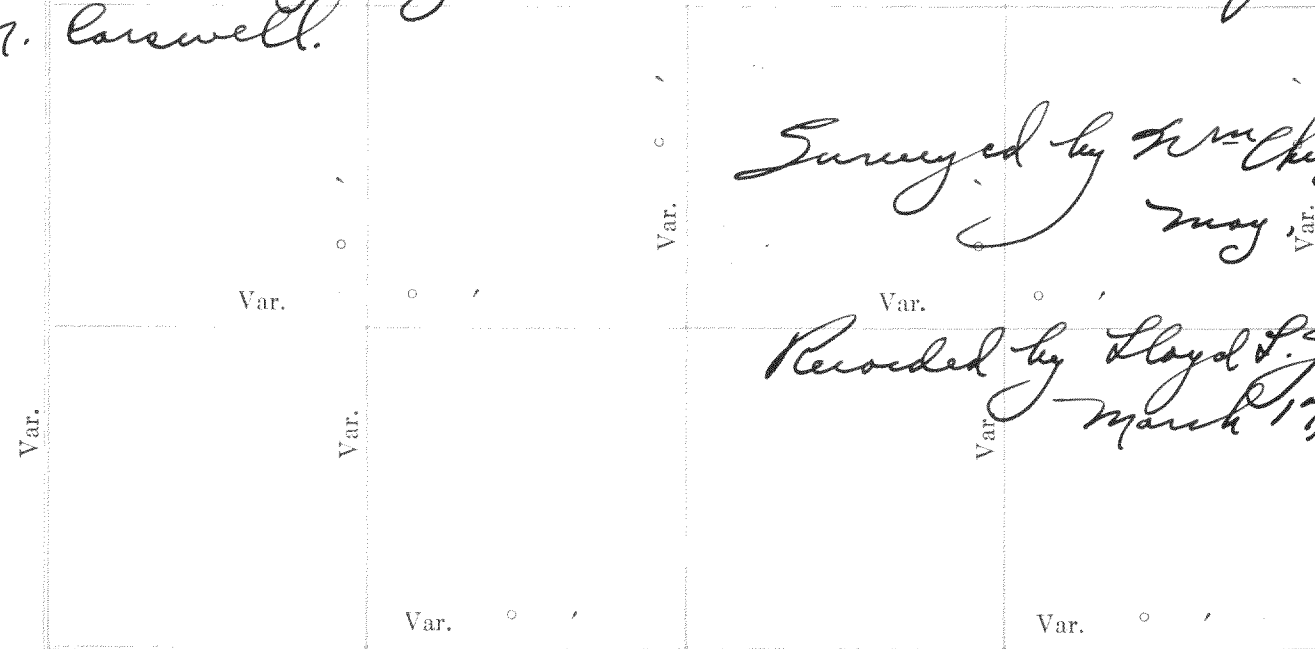

Surveyed by Wm Child
CS.
May 17, 1920

Recorded by Lloyd S. Jensen
CS.
March 17, 1934

Plat of Section....., Township.....North, Range.....of 4 Principal Meridian Scale
80 chains to 6 inches. The figures in red ink are the lengths of the lines as stated in the field-notes of the
Government survey.

Declination of the Magnetic Meridian from the True Meridian.....
Surveyed and sub-divided.....A. D. 1....., in accordance
with the State Laws and Instructions of the Commissioner of the General Land office, and recorded on pages
.....of Register in the County Clerk's office.

Witness my hand this.....day of.....A. D. 1.....

.....SURVEYOR.

GOVERNMENT CORNERS

No.

1. N. W. Sec. Cor. identified,

2. N. E. Sec. Cor. identified,

3. S. E. Sec. Cor. identified,

4. S. W. Sec. Cor. identified,

5. N. ¼ Sec. Cor. identified,

6. E. ¼ Sec. Cor. identified,

7. S. ¼ Sec. Cor. identified,

8. W. ¼ Sec. Cor. identified,

Subdivision Corners

No.

1. Center ¼ Sec. Cor.

2. North ¼-¼s N. W. qr.,

3. East ¼-¼s N. W. qr.,

4. South ¼-¼s N. W. qr.,

5. West ¼-¼s N. W. qr.,

6. Center ¼-¼s N. W. qr.,

7. North ¼-¼s N. E. qr.,

8. East ¼-¼s N. E. qr.,

9. South ¼-¼s N. E. qr.,

10. Center ¼-¼s N. E. qr.,

11. East ¼-¼s S. E. qr.,

12. South ¼-¼s S. E. qr.,

13. West ¼-¼s S. E. qr.,

14. Center ¼-¼s S. E. qr.,

15. South ¼-¼s S. W. qr.,

16. West ¼-¼s S. W. qr.,

17. Center ¼-¼s S. W. qr.

Bearing
Trees

In.
Dia.

Courses
they bear

Links
Distant

Bearing
Trees

In.
Dia.

Courses
they bear

Links
Distant

Bearing
Trees

In.
Dia.

Courses
they bear

Links
Distant

no 410

26-4-16

All of that certain piece or parcel of land being
a part of government lot no. 5, which is the East
half of the Southwest quarter of section 26, T4N,
R16E, being the town of La Chang, Walworth
Co., Wisconsin, and being also a part of block
4 of the plat of Green Lake Park, which plat is on
record in the Register of Deeds office in and for the
said County in Vol 5 of plats on page —, described
as follows to wit:— Beginning at a point on the
Easterly line of a road or drive located along the
Easterly side of Blk. no 2 of the said recorded
Plat and being nearly opposite the center of
lot no 9 and being also the S. Wly. cor. of a lot conveyed
by R. C. Belkley to Alexander, and D. V. Horvack as recorded
in 184-548 of deeds; Thence Easterly being along the
Southerly line of the said Horvack's lot 34 feet to the
SE cor. thereof & continuing on the same course & line
66 feet more to a point. Thence Southerly being
parallel with the Easterly line of the said road or
drive 50 feet to a pt.; Thence westerly 100' to a pt. on
the Easterly line of the said road or drive 50 feet
from the place of beginning; Thence Southerly being
along the line of the road or drive 50 feet to the
place of beginning.

Surveyed by Wm Child
CS.

Recorded by Lloyd S. Jensen
CS.
March 17, 1934

NAMES OF SWORN ASSISTANTS

CHAINMEN

FLAGMEN

AXMEN

No 411

25-4-16

That certain piece or parcel of land on the west line of Section 25-4-16, being the Town of La Grange, Walworth County Wisconsin, described as follows to wit:-

Beginning at an iron pipe stake that is $N 62^{\circ} 15' E$ 56 feet from the point where the West line of said section No. 25 intersects the E° of one certain bridge which connects the Plat of Sanderdale Park with the Plat of Green Island now known as Shekin Isle; Thence $N 27^{\circ} 45' W$ 10 feet; Thence $S 62^{\circ} 15' W$ to the west line said section No. 25; Thence South on the said west line to a point 20 feet Southeastly (measuring at right angles to the above described line running $S 62^{\circ} 15' W$ produced; Thence $N 62^{\circ} 15' E$ to a pt $S 27^{\circ} 45' E$ 10 feet from the place of beginning; Thence $N 27^{\circ} 45' E$ 10 feet to the place of beginning. The center line of the above described piece or parcel of land, being a line beginning at a white oak tree 15 inches in diameter on the said Sanderdale Park; Thence $S 62^{\circ} 15' W$ 85 feet to the iron pipe the place of beginning of the above described piece, 141 to the center of the above mentioned Bridge and section line and 326 feet to an iron pipe stake which is 10.7 feet westerly of a white oak tree and 5.7 feet Northeastly of a yellow oak tree.

Said center line of bridge is the centerline of the bridge as it now stands.

Surveyed by Wm Child_{CS}

Recorded by Lloyd S. Jensen_{CS}

March 17, 1934

No 412

26-4-16

All of That certain piece or parcel of land lying and being, in the northeast quarter of the north west quarter, of section No. 26, T4N, R16E, being the Town of La Grange, Walworth County, Wisconsin, described as follows to wit:- from an iron stake, on the East line of said quarter, quarter section, that is 370 feet South of the northeast corner thereof and being also, 258.5 feet South of the northeast corner, of the land owned and occupied, by the said John Taylor, go $S 55^{\circ} 00' W$, 470 feet to a cement monument. The place of beginning, Thence $S 21^{\circ} 45' E$ 205 feet to a cement monument, and 225 feet more or less to the shore of Green Lake.

Thence southerly, being along the said shore, 100 feet to a stake; Thence $N 22^{\circ} 30' W$ 25 feet, more or less to a cement monument, and continuing on the same course and line 200 feet more, to a cement monument the corner; Thence $N 51^{\circ} 00' E$ 103.5 feet, to the place of beginning.

Surveyed by Wm Child_{CS}

Recorded by Lloyd S. Jensen_{CS}
March 17, 1934