

No 453


28-2-16

H. C. MILLER CO. MFG. STATIONERS, MILWAUKEE X15000

Established the center of the section at the point of intersection of STRAIGHT quarter lines.

Established all quarter-quarter corners upon the section boundary at proportional distances between known section and quarter section corners, according to the original field-notes of the Government survey.

Established all lost corners at proportionate distances between known corners, according to the original field notes of the Government survey.

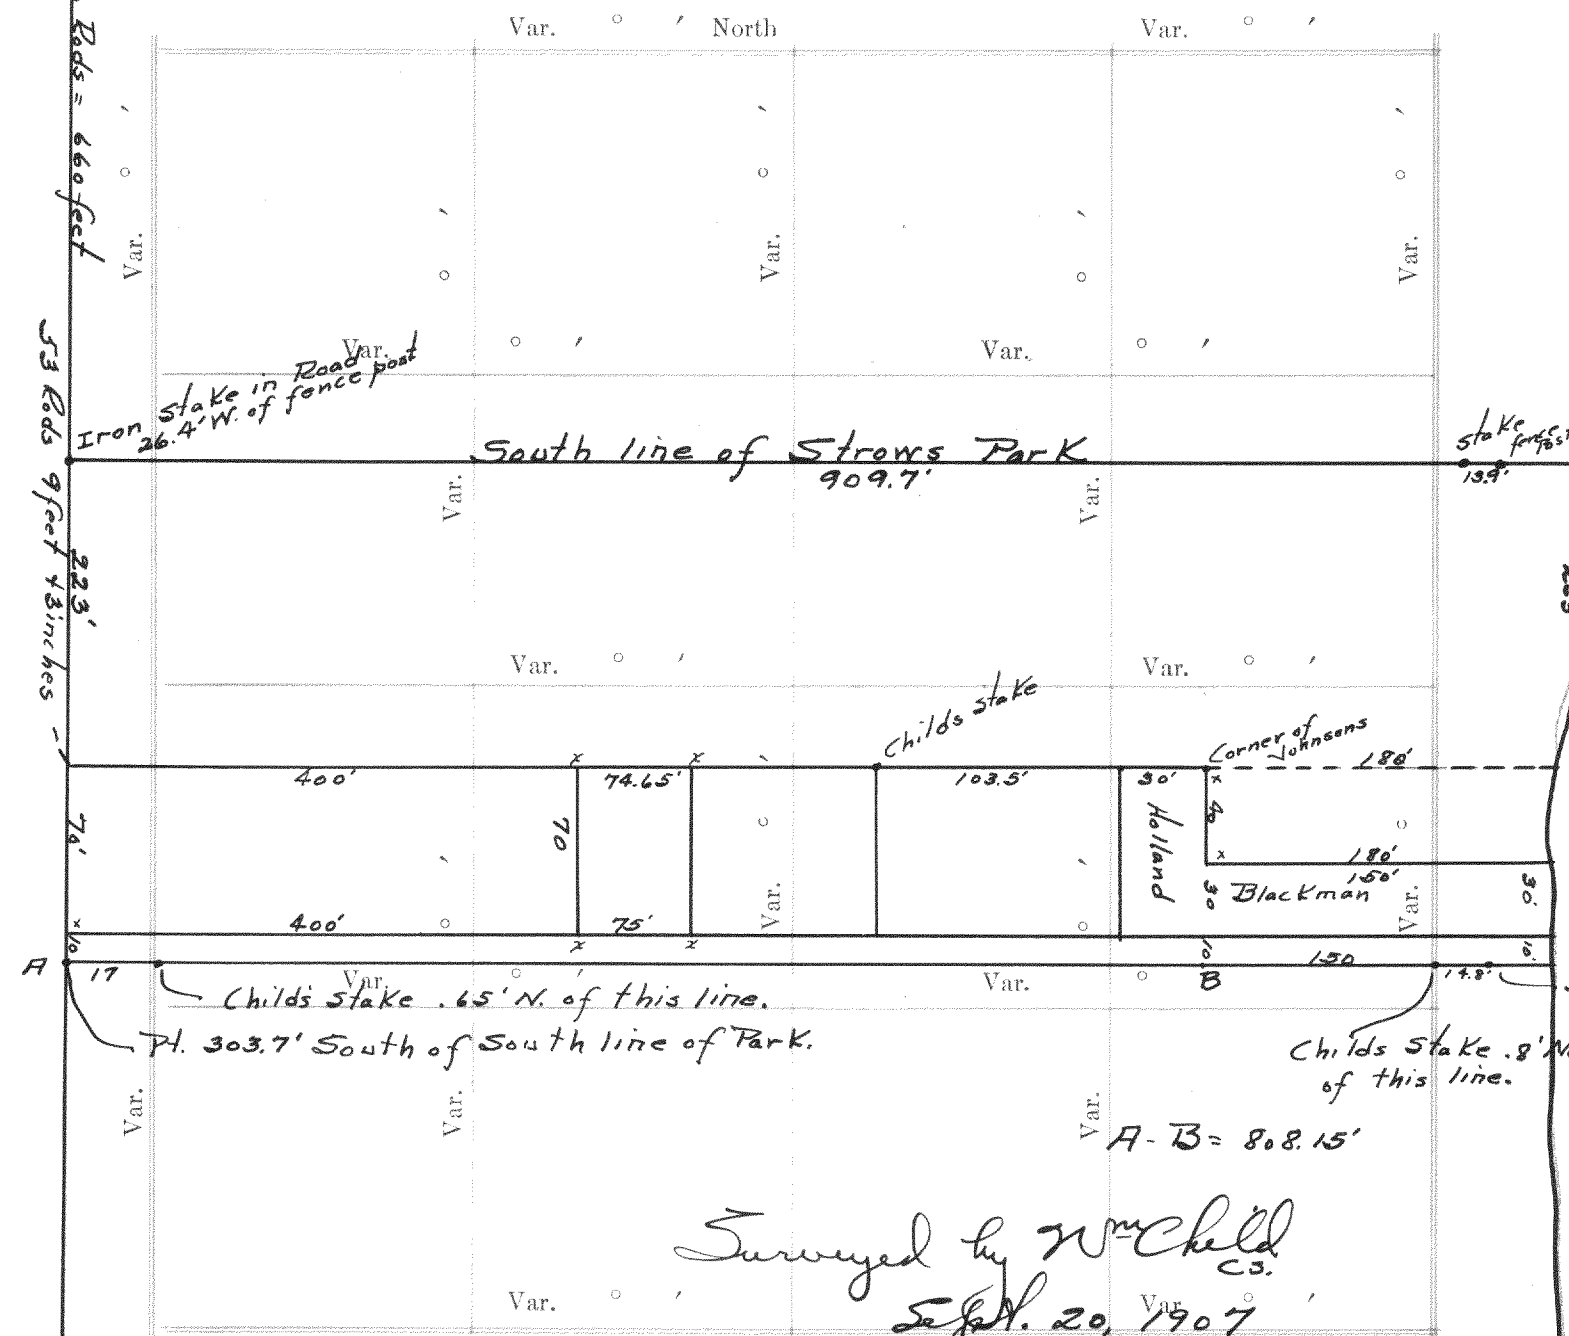

Declination of the Magnetic Meridian from the True Meridian.....

Surveyed and sub-divided..... A. D. 1 , in accordance

with the State Laws and Instructions of the Commissioner of the General Land office, and recorded on pages

.....of Register in the County Clerk's office.

Witness my hand this.....day of.....A. D. 1
SURVEYOR.

1. N. W. Sec. Cor. unidentified,
2. N. E. Sec. Cor. unidentified,
3. S. E. Sec. Cor. unidentified,
4. S. W. Sec. Cor. unidentified,
5. N. $\frac{1}{4}$ Sec. Cor. unidentified,
6. E. $\frac{1}{4}$ Sec. Cor. unidentified,
7. S. $\frac{1}{4}$ Sec. Cor. unidentified,
8. W. $\frac{1}{4}$ Sec. Cor. unidentified,

1. Center $\frac{1}{4}$ Sec. Cor.
2. North $\frac{1}{4}$ - $\frac{1}{4}$ s N. W. qr.,
3. East $\frac{1}{4}$ - $\frac{1}{4}$ s N. W. qr.,
4. South $\frac{1}{4}$ - $\frac{1}{4}$ s N. W. qr.,
5. West $\frac{1}{4}$ - $\frac{1}{4}$ s N. W. qr.,
6. Center $\frac{1}{4}$ - $\frac{1}{4}$ s N. W. qr.,
7. North $\frac{1}{4}$ - $\frac{1}{4}$ s N. E. qr.,
8. East $\frac{1}{4}$ - $\frac{1}{4}$ s N. E. qr.,
9. South $\frac{1}{4}$ - $\frac{1}{4}$ s N. E. qr.,
10. Center $\frac{1}{4}$ - $\frac{1}{4}$ s N. E. qr.,
11. East $\frac{1}{4}$ - $\frac{1}{4}$ s S. E. qr.,
12. South $\frac{1}{4}$ - $\frac{1}{4}$ s S. E. qr.
13. West $\frac{1}{4}$ - $\frac{1}{4}$ s S. E. qr.,
14. Center $\frac{1}{4}$ - $\frac{1}{4}$ s S. E. qr.,
15. South $\frac{1}{4}$ - $\frac{1}{4}$ s S. W. qr.,
16. West $\frac{1}{4}$ - $\frac{1}{4}$ s S. W. qr.,
17. Center $\frac{1}{4}$ - $\frac{1}{4}$ s S. W. qr.

no 454

32-2-16

Beginning at an iron monument as prescribed by law for the recording of Village Plots in the center of the highway and which iron monument is 43.3 feet north and 25 feet east of the quarter section corner on the south line of Section No. 32, in Town 2 North, R 16 E, being the Town of Oshkosh, Walworth Co., Wisconsin.

Thence North parallel with and 25 feet East of the quarter section line of said section No. 32. 949.8 feet to a like iron monument; Thence $N 59^{\circ} 28' E$ being parallel with and 25 feet from (measuring at right angles to) the line of a survey made by James S. Gibbs Aug. 14th 1896 for the rear of Lake shore lots 540.9 feet to a like iron monument; Thence South parallel with the above mentioned quarter section line 920 feet to a like iron monument in the center of the road or highway; Thence $S 57^{\circ} W$ 556.3 feet to the place of beginning.

Surveyed by W^m Child
CS

Recorded by Lloyd S. Jensen
March 26, 1934

NAMES OF SWORN ASSISTANTS

CHAINMEN

FLAGMEN

AXMEN

No 455

27-2-16

Harrington Subdivision

Beginning at an iron monument in the center of one certain road and said iron monument being the Southeast corner of one certain plot known as The Harrington Sub. and which plot is on record in the Register of Deeds office in and for Walworth County, Wisconsin, in Vol. 6 of Plots on page. Thence East 132.5 feet to a stake; Thence South 125 feet to a stake; Thence west 216.5 feet to a stake in the center of the above mentioned road; Thence northeasterly along the center of said road 150.5 feet to the place of beginning containing $\frac{1}{2}$ acre of land.

Surveyed by Wm Child^{cs.}

Recorded by Lloyd S. Jensen^{cs.}
March 26, 1934

No. 456

27-2-16

Description of old Lot 8 of Lake View.

Beginning at a stake at the Southeast corner of Lot no. 7 in the plot of Lake View which plot is on record in the Register of Deeds office in and for Walworth Co., Wisconsin, in Vol. 4 of Plots on page 37, Thence northwesterly along the most southerly line of said lot 7, 313 feet more or less to the shore of the Cavan Lake at low water line; Thence southerly along the shore of said Lake at low water line to a point; Thence southeasterly 23 feet more or less to a stake being on a line of the fore line of the above mentioned plot and 50 feet from a stake on said line on the most southerly side of said lot 7 and producing or extending said line southeasterly 285.7 feet to a stake being in line with the south easterly line of said plot and 65 feet from the South east corner of said lot 7, and 35.5 feet more to a stake in the center of one certain road 10.8 feet northerly from an angle stake in said road; Thence northeasterly along the center of said road 68.2 feet to a stake 2.5 feet southerly from an angle stake in said road; Thence northwesterly 25.4 feet to the place of beginning.

Surveyed by Wm Child^{cs.}

Recorded by Lloyd S. Jensen^{cs.}
March 26, 1934