

DESCRIPTION

Record of Survey.

OF SECTION, QUARTER SECTION AND QUARTER QUARTER SECTION CORNERS

no 474

22-2-16

Township North of Range of 4 Principal Meridian  
as presented by the courses and distances on the following plat, and annexed field-notes of survey  
Established all quarter-quarter corners upon the section boundary at the following distances, between known  
section and quarter section corners, according to the original field-notes of the Government survey.  
Established all 1/4 corner distances between known corners according to the original field  
notes of the Government survey.  
Beginning at a point 75° 58' 16" E 17.5 feet from  
The southeasterly corner of lot no. 1 in the plat of  
Mereness Springs (said plat being on record in the  
register of deeds office in and for said Walworth  
County in Vol. no 5 of plats on page 11) and said point  
being also the southeasterly corner of that certain  
piece or parcel of land conveyed to one Wagner, the deed  
of which conveyance is recorded in the above mentioned  
Register's office, in Vol. 114 of deeds, on page 379. Thence  
Southeasterly being the southeasterly line of said  
Wagner's land produced 30 feet more or less to the center  
of the road or ~~highway~~ highway; thence southeasterly along  
the center of said road or highway to a point where a  
line drawn parallel with and 100 feet southeasterly  
of (measuring at right angles to) the southeasterly line  
of said Wagner's lot would intersect said center line.  
Thence northwesterly on a line parallel with and 100  
feet from and measuring right angles to the southeasterly  
line of said Wagner's lot, 400 ft. more or less to the  
shore of Delavan Lake at low water line. Thence in a  
southwesterly direction along the low water line of  
said lake to the southeasterly corner of said Wagner's  
lot. Thence southeasterly along the southeasterly line  
of said Wagner's lot to the place of beginning.

Government survey.

Declination of the Magnetic Meridian from the True Meridian.

Surveyed and sub-divided.

with the State Laws and Instructions of the Commissioner of the General Land office, and recorded on pages

of Register in the County Clerk's office.

Witness my hand this day of A. D. 1

SURVEYOR.

GOVERNMENT CORNERS

- No. 1. N. W. Sec. Cor. identified,  
2. N. E. Sec. Cor. identified,  
3. S. E. Sec. Cor. identified,  
4. S. W. Sec. Cor. identified,  
5. N. 1/4 Sec. Cor. identified,  
6. E. 1/4 Sec. Cor. identified,  
7. S. 1/4 Sec. Cor. identified,  
8. W. 1/4 Sec. Cor. identified,  
Subdivision Corners  
No. 1. Center 1/4 Sec. Cor.  
2. North 1/4-1/4s N. W. qr.,  
3. East 1/4-1/4s N. W. qr.,  
4. South 1/4-1/4s N. W. qr.,  
5. West 1/4-1/4s N. W. qr.,  
6. Center 1/4-1/4s N. W. qr.,  
7. North 1/4-1/4s N. E. qr.,  
8. East 1/4-1/4s N. E. qr.,  
9. South 1/4-1/4s N. E. qr.,  
10. Center 1/4-1/4s N. E. qr.,  
11. East 1/4-1/4s S. E. qr.,  
12. South 1/4-1/4s S. E. qr.,  
13. West 1/4-1/4s S. E. qr.,  
14. Center 1/4-1/4s S. E. qr.,  
15. South 1/4-1/4s S. W. qr.,  
16. West 1/4-1/4s S. W. qr.,  
17. Center 1/4-1/4s S. W. qr.


CHAINMEN

| Bearing | In.  | Courses   | Links   | Bearing | In.  | Courses   | Links   | Bearing | In.  | Courses   | Links   | Bearing | In.  | Courses   | Links   |
|---------|------|-----------|---------|---------|------|-----------|---------|---------|------|-----------|---------|---------|------|-----------|---------|
| Trees   | Dia. | they bear | Distant | Trees   | Dia. | they bear | Distant | Trees   | Dia. | they bear | Distant | Trees   | Dia. | they bear | Distant |

no 475

29-2-16

North line

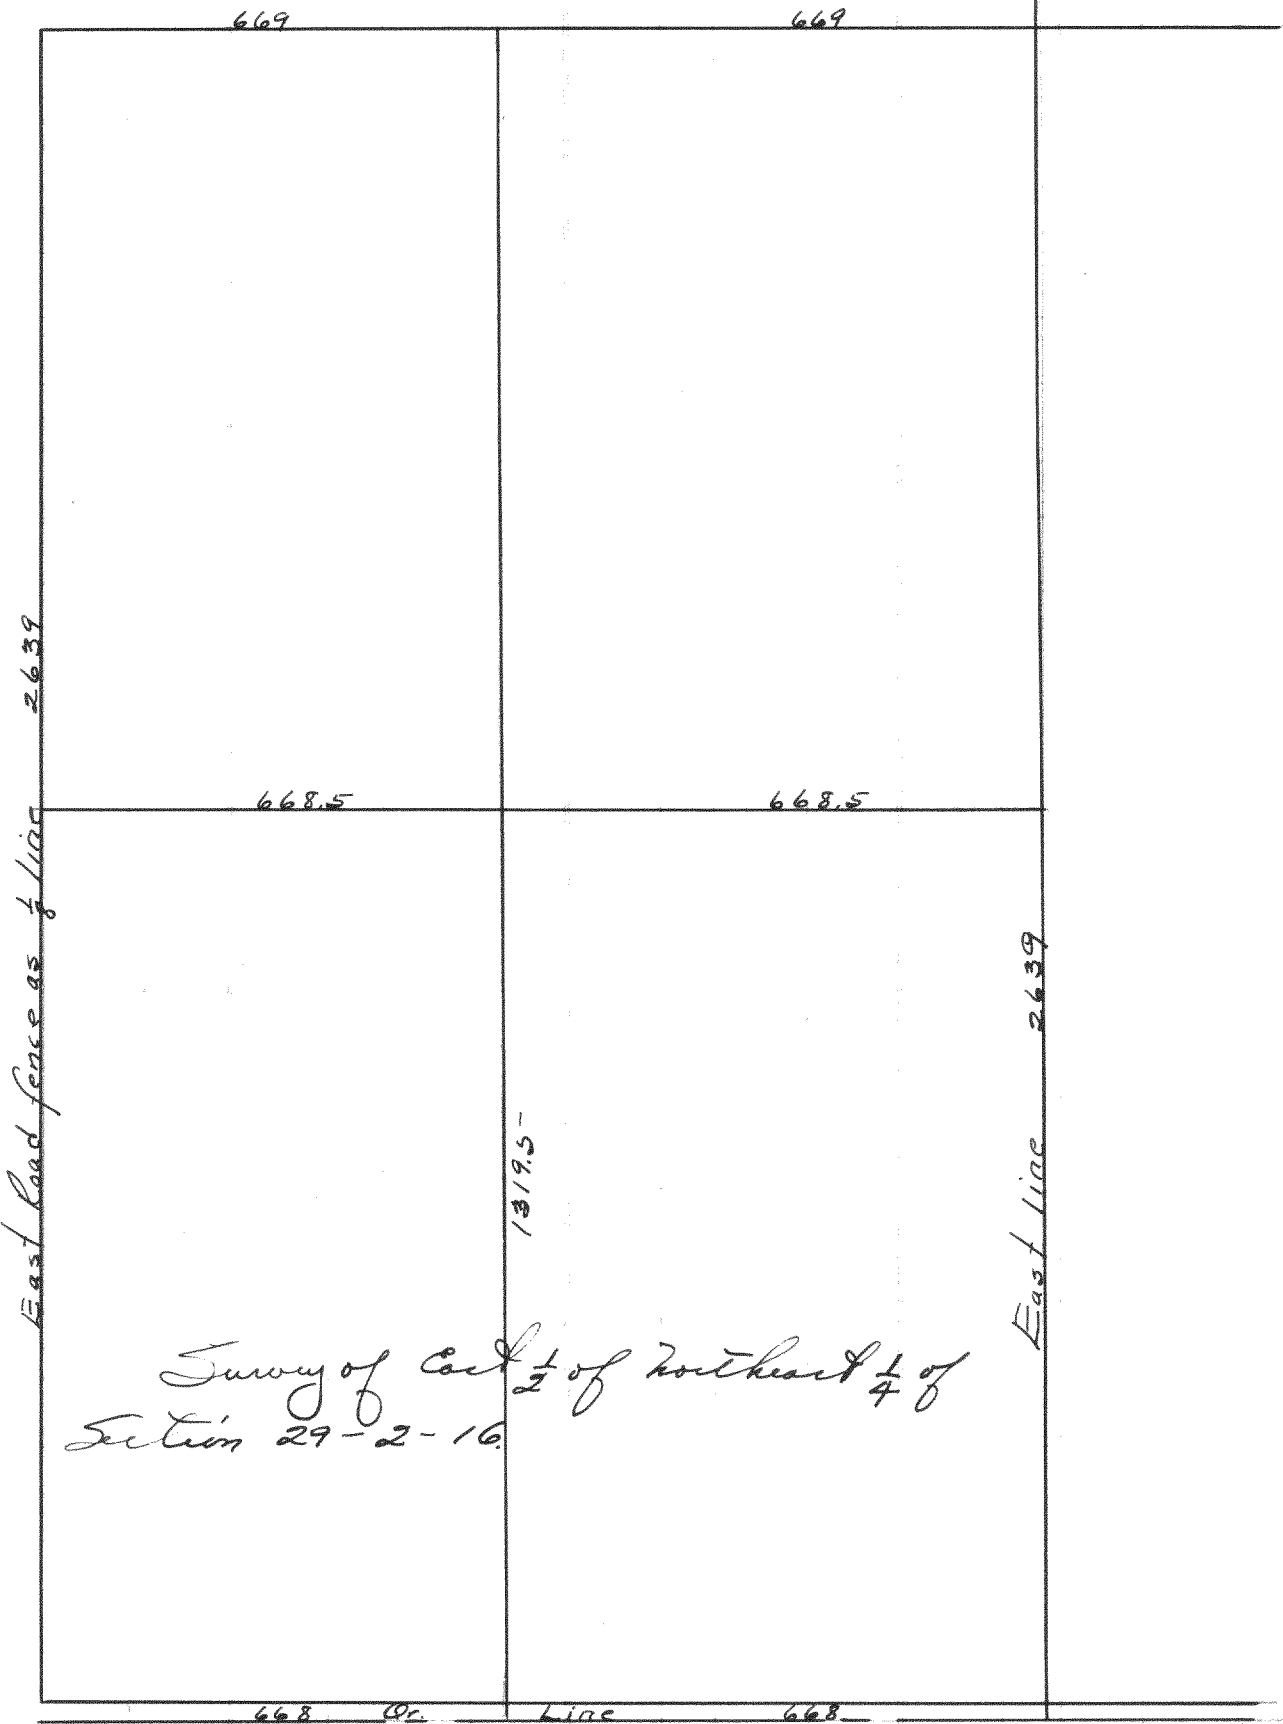

NAMES OF SWORN ASSISTANTS

FLAGMEN

AXMEN

Surveyed by Wm Child

Recorded by Lloyd S. Jensen  
March 29, 1934

