

## Record of Survey.

no 482


32-2-16

Township....., North of Range..... of 4 Principal Meridian  
as presented by the courses and distances on the following plat, and annexed field-notes of survey:

Established the center of the section at the point of intersection of STRAIGHT quarter lines.

Established all quarter-quarter corners upon the section boundary at proportional distances between known section and quarter section corners, according to the original field-notes of the Government survey.

Established all lost corners at proportionate distances between known corners, according to the original field notes of the Government survey.

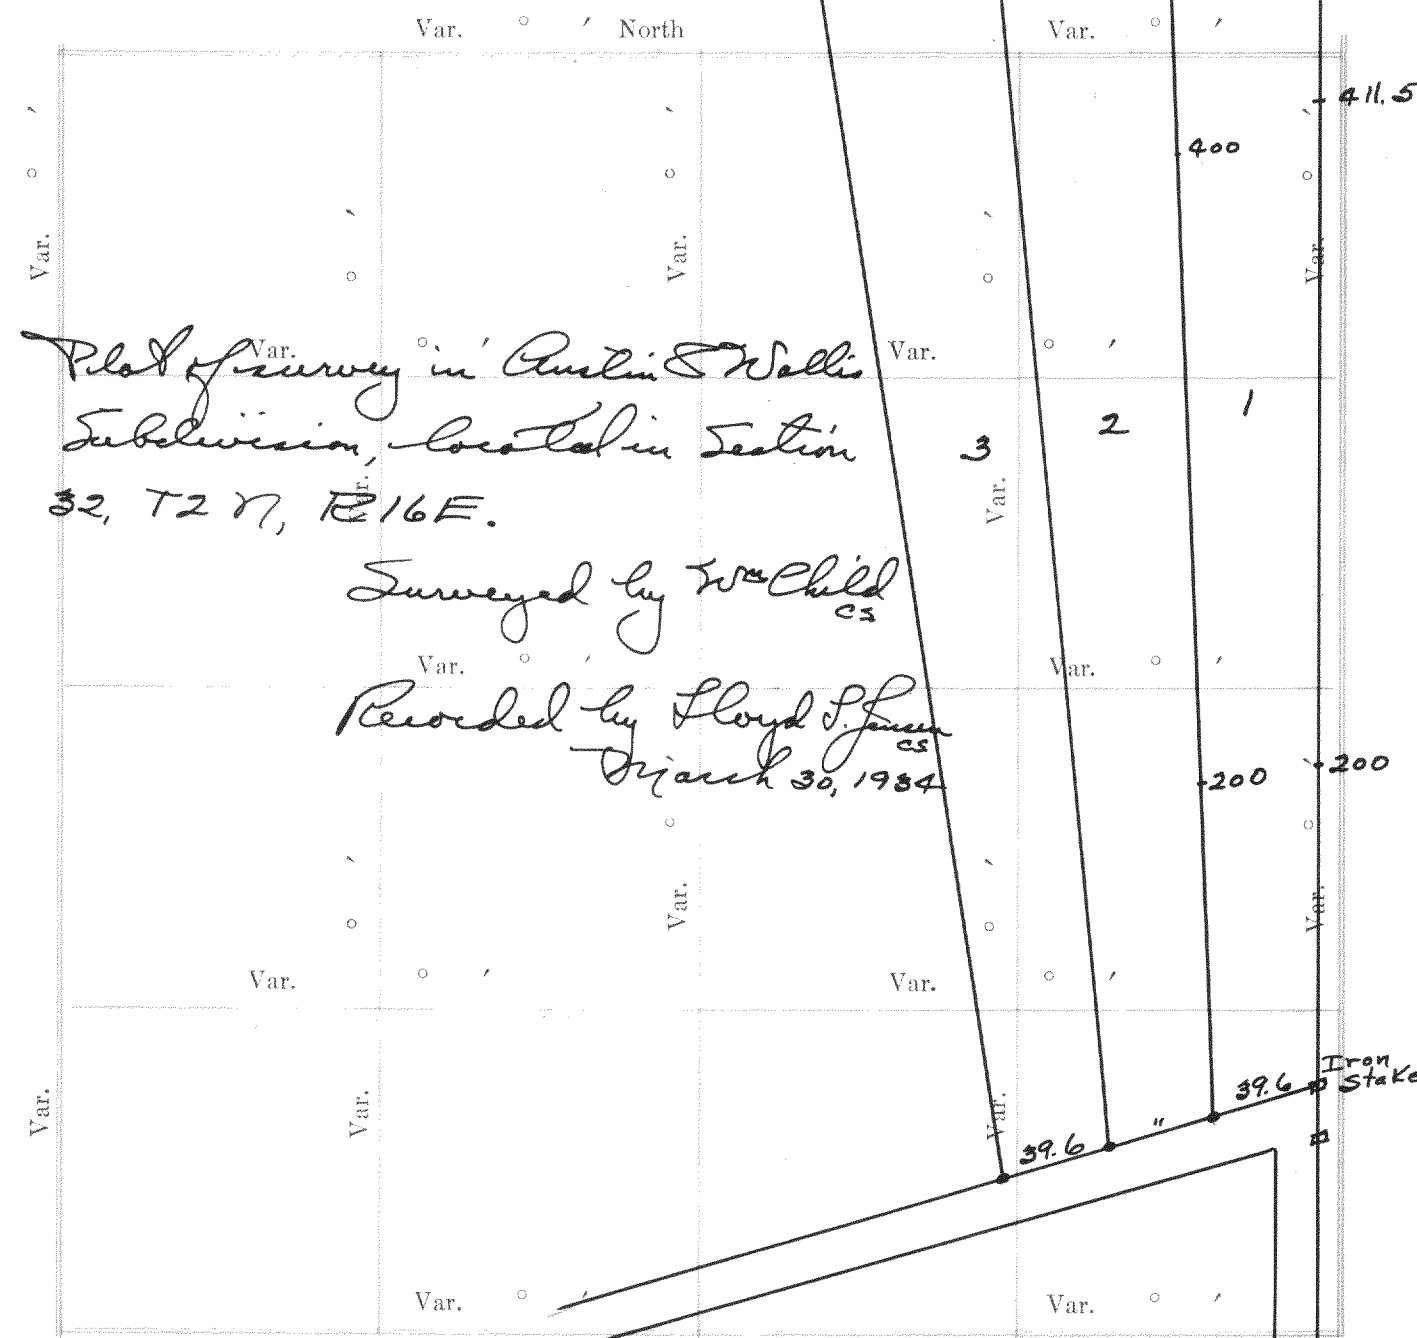

Plat of Section....., Township.....North, Range.....of 4 Principal Meridian Scale  
80 chains to 6 inches. The figures in red ink are the lengths of the lines as stated in the field-notes of the  
Government survey.

Declination of the Magnetic Meridian from the True Meridian.....

Surveyed and sub-divided..... A. D. 1....., in accordance  
with the State Laws and Instructions of the Commissioner of the General Land office, and recorded on pages  
.....of Register in the County Clerk's office.

Witness my hand this..... day of..... A. D. 1.....

...SURVEYOR.

## DESCRIPTION

OF SECTION, QUARTER SECTION AND QUARTER QUARTER SECTION CORNERS

27-2-16

H. C. MILLER CO. MFG. STATIONERS, MILWAUKEE, WIS. X15000

GOVERNMENT CORNERS

| No. | Bearing<br>Trees                       | In.<br>Dia. | Courses<br>they bear | Links<br>Distant | Bearing<br>Trees | In.<br>Dia. | Courses<br>they bear | Links<br>Distant | Bearing<br>Trees | In.<br>Dia. | Courses<br>they bear | Links<br>Distant |
|-----|----------------------------------------|-------------|----------------------|------------------|------------------|-------------|----------------------|------------------|------------------|-------------|----------------------|------------------|
| 1.  | N. W. Sec. Cor. identified,            |             |                      |                  |                  |             |                      |                  |                  |             |                      |                  |
| 2.  | N. E. Sec. Cor. identified,            |             |                      |                  |                  |             |                      |                  |                  |             |                      |                  |
| 3.  | S. E. Sec. Cor. identified,            |             |                      |                  |                  |             |                      |                  |                  |             |                      |                  |
| 4.  | S. W. Sec. Cor. identified,            |             |                      |                  |                  |             |                      |                  |                  |             |                      |                  |
| 5.  | N. $\frac{1}{4}$ Sec. Cor. identified, |             |                      |                  |                  |             |                      |                  |                  |             |                      |                  |
| 6.  | E. $\frac{1}{4}$ Sec. Cor. identified, |             |                      |                  |                  |             |                      |                  |                  |             |                      |                  |
| 7.  | S. $\frac{1}{4}$ Sec. Cor. identified, |             |                      |                  |                  |             |                      |                  |                  |             |                      |                  |
| 8.  | W. $\frac{1}{4}$ Sec. Cor. identified, |             |                      |                  |                  |             |                      |                  |                  |             |                      |                  |

Subdivision Corners

| No. | Course                                            | Distance | Notes |
|-----|---------------------------------------------------|----------|-------|
| 1.  | Center $\frac{1}{4}$ Sec. Cor.                    |          |       |
| 2.  | North $\frac{1}{4}$ - $\frac{1}{4}$ s N. W. qr.,  |          |       |
| 3.  | East $\frac{1}{4}$ - $\frac{1}{4}$ s N. W. qr.,   |          |       |
| 4.  | South $\frac{1}{4}$ - $\frac{1}{4}$ s N. W. qr.,  |          |       |
| 5.  | West $\frac{1}{4}$ - $\frac{1}{4}$ s N. W. qr.,   |          |       |
| 6.  | Center $\frac{1}{4}$ - $\frac{1}{4}$ s N. W. qr., |          |       |
| 7.  | North $\frac{1}{4}$ - $\frac{1}{4}$ s N. E. qr.,  |          |       |
| 8.  | East $\frac{1}{4}$ - $\frac{1}{4}$ s N. E. qr.,   |          |       |
| 9.  | South $\frac{1}{4}$ - $\frac{1}{4}$ s N. E. qr.,  |          |       |
| 10. | Center $\frac{1}{4}$ - $\frac{1}{4}$ s N. E. qr., |          |       |
| 11. | East $\frac{1}{4}$ - $\frac{1}{4}$ s S. E. qr.,   |          |       |
| 12. | South $\frac{1}{4}$ - $\frac{1}{4}$ s S. E. qr.,  |          |       |
| 13. | West $\frac{1}{4}$ - $\frac{1}{4}$ s S. E. qr.,   |          |       |
| 14. | Center $\frac{1}{4}$ - $\frac{1}{4}$ s S. E. qr., |          |       |
| 15. | South $\frac{1}{4}$ - $\frac{1}{4}$ s S. W. qr.,  |          |       |
| 16. | West $\frac{1}{4}$ - $\frac{1}{4}$ s S. W. qr.,   |          |       |
| 17. | Center $\frac{1}{4}$ - $\frac{1}{4}$ s S. W. qr., |          |       |

no 483

Lot 17

Iron stake base line on Plat of Subd.

Fondren S. line of Harrington Subd.

New 151 line


New 91.5 line

Stake 10 feet from barn.

Corner of Bailey's Subd.

Iron Stake

Plat of survey of land consisting of part of  
The Harrington Subd. and part of Bailey's Subd.  
Surveyed by J. M. Child  
Recorded by Lloyd L. Luman

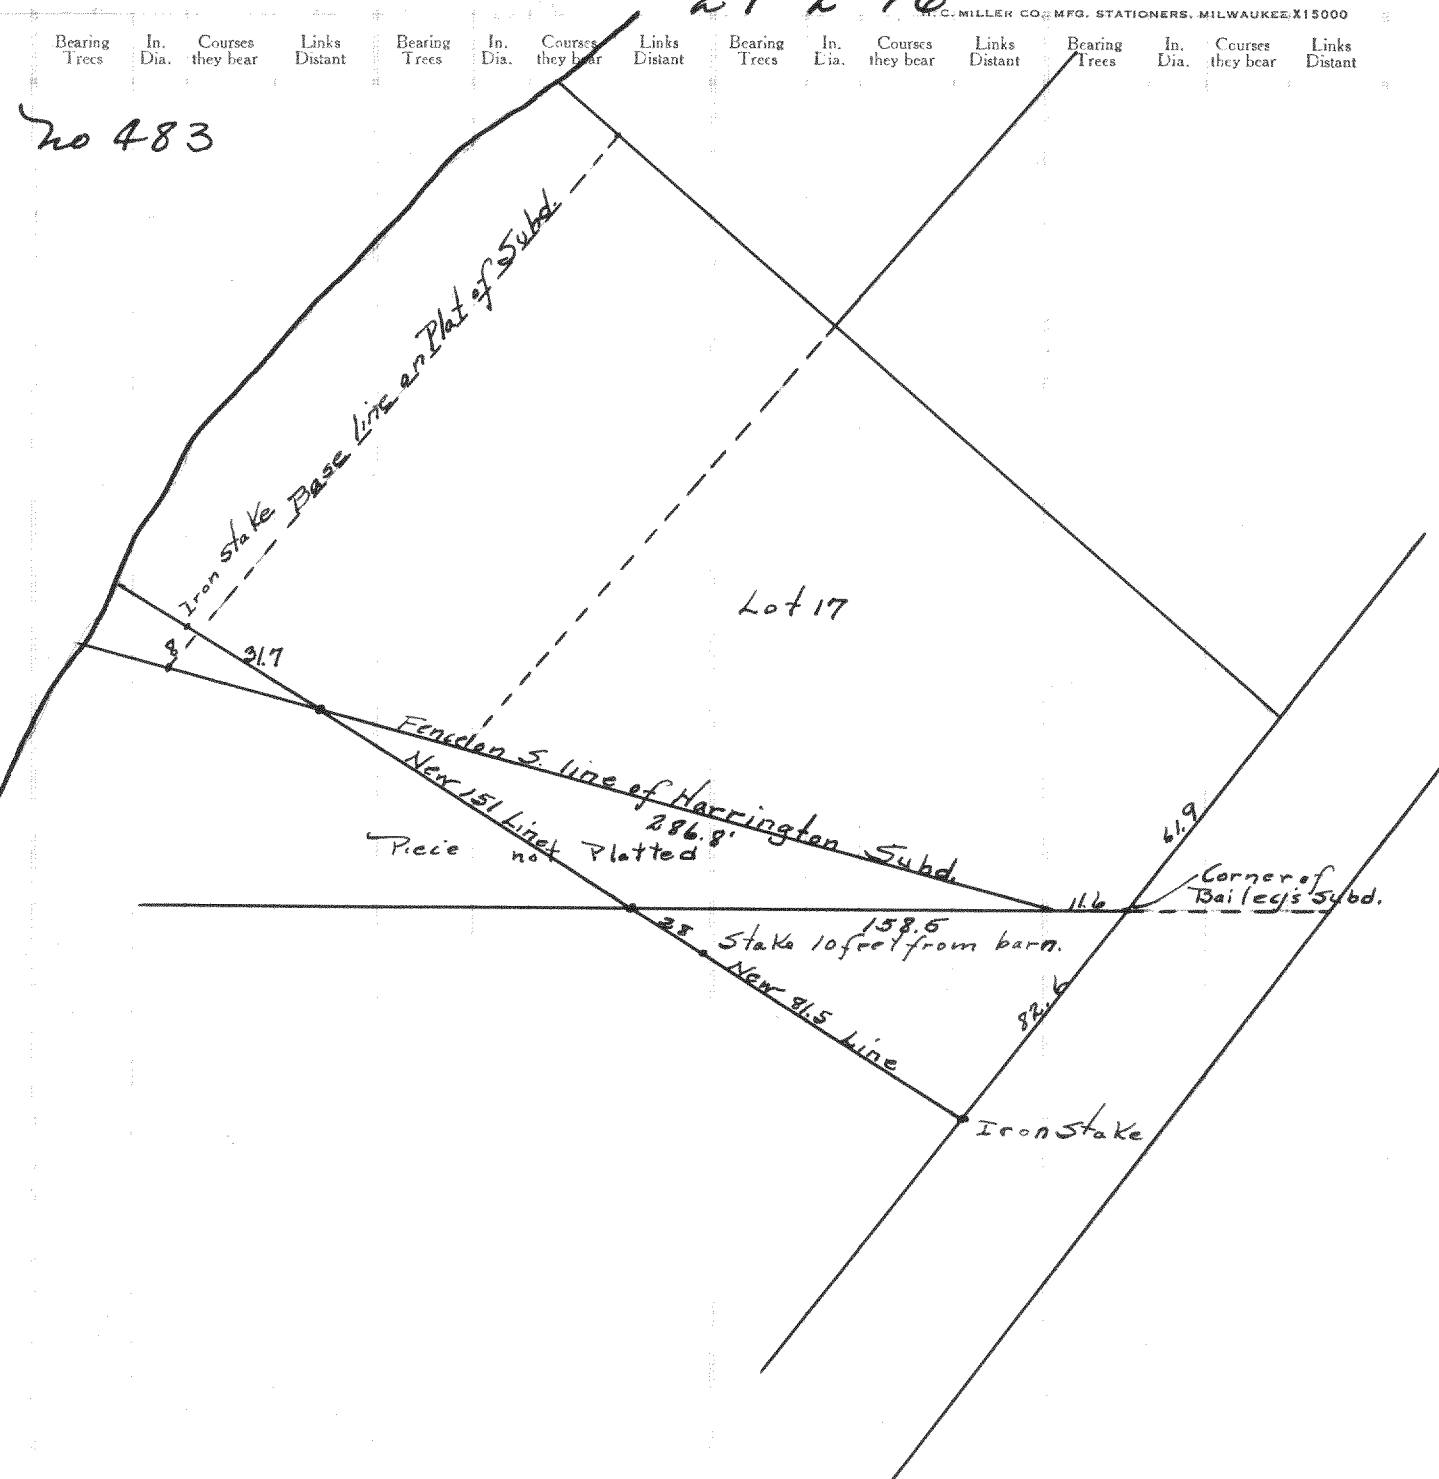

Plot of survey of land consisting of part of  
The Harrington Subd. and part of Bailey's Subd.  
Surveyed by J. M. Childs

Recorded by Lloyd S. Jensen  
March 30, 1934

NAMES OF SWORN ASSISTANTS


FLAGMEN

AXMEN

CHAINMEN

No 784

(Cont' from No 472 on Page 155)

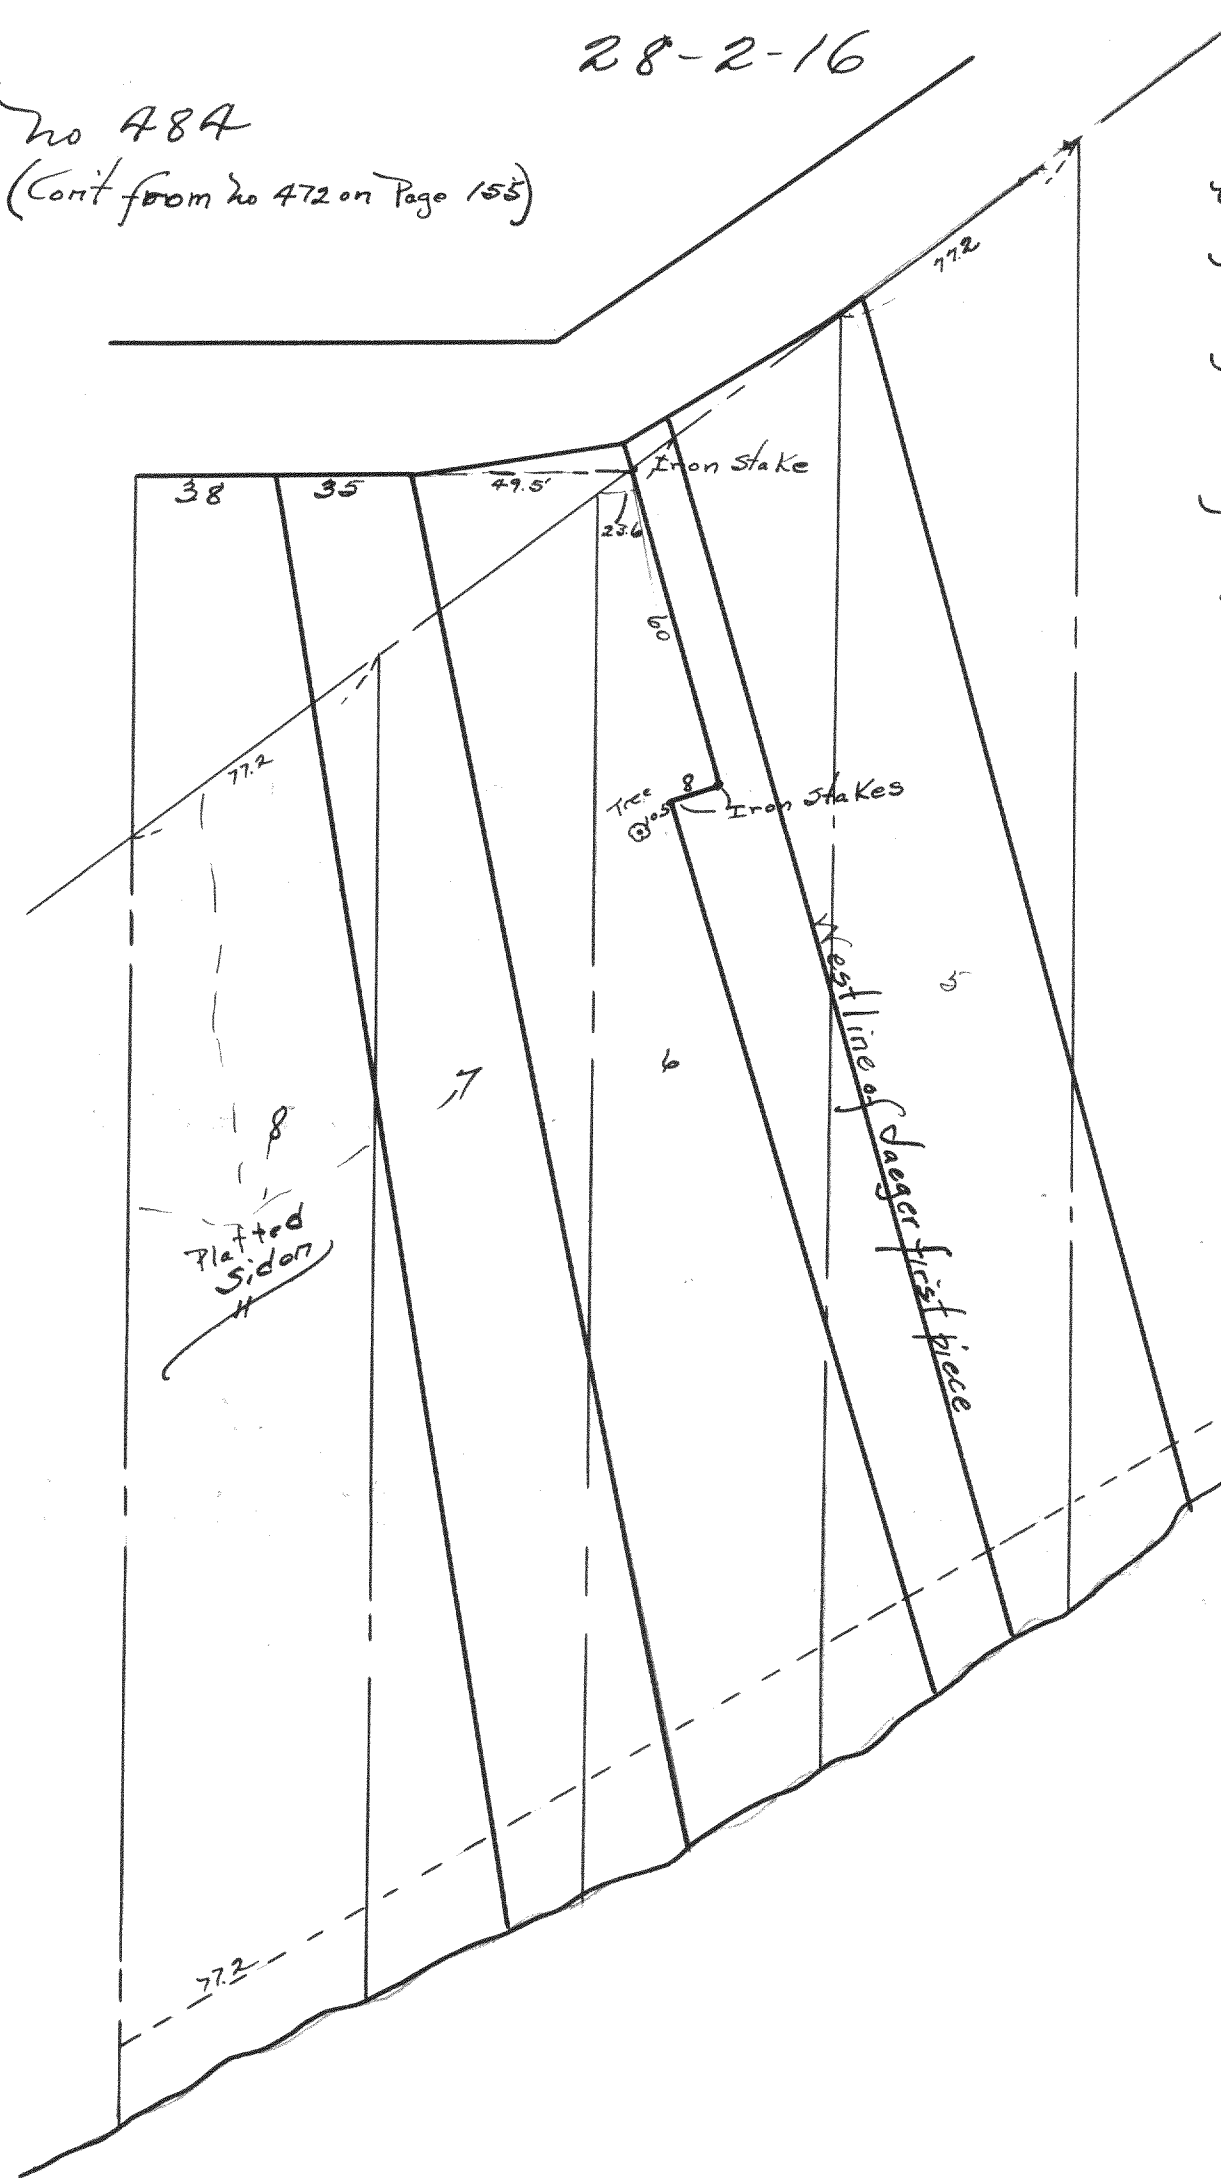

And being 49.5 feet East of the place of beginning and continuing on the same course and line 13 feet, more or less, to the southeasterly line of the said road; Thence Southwesterly to the place of beginning.

Mr. Jaeger

Beginning at an iron stake on the northwesterly line of lot no. 6 of the said Plot 23.6 feet northeasterly of the northwest corner thereof and being on the west line of land conveyed to E. F. Jaeger. The deed of which conveyance is on record in the said Register of Deeds office in Volume 163 of deeds on page 477; Thence southeasterly being along the southwesterly line of the said Jaeger's land to the shore of Delavan Lake passing through an iron stake on the base line of the said plot 35.9 feet southwesterly of the point of intersection of the said base line of the said plot with the East line of lot no. 5; Thence southwesterly being along the shore of said lake 22 feet, more or less, to a point; Thence northwesterly 25 feet more or less to an iron stake that is 20 feet southwesterly of the iron stake mentioned in the said Jaeger's deed as being on the base line of the said plot and continuing on the same course and line 164 feet, more to an iron stake that is 10.5 feet northeasterly of a nail in an iron wood cue; Thence northeasterly eight (8) feet to an iron stake; Thence northwesterly 60.2 feet to an iron stake in line with the south line of the said road and continuing on the same course and line 13 feet, more or less, to the southeasterly line of the said road; Thence northeasterly along the southeasterly line of said road 9 feet, more or less, to a point that is in line with the first described line being the northwest corner of the said Jaeger's land; Thence southeasterly to the place of beginning.

Surveyed by J<sup>m</sup> Child  
CS

Recorded by Lloyd S. Jensen  
March 30, 1934