


185
no 553

Unit No. 2 - County Club Estates.

no 554

Lake Como Beach

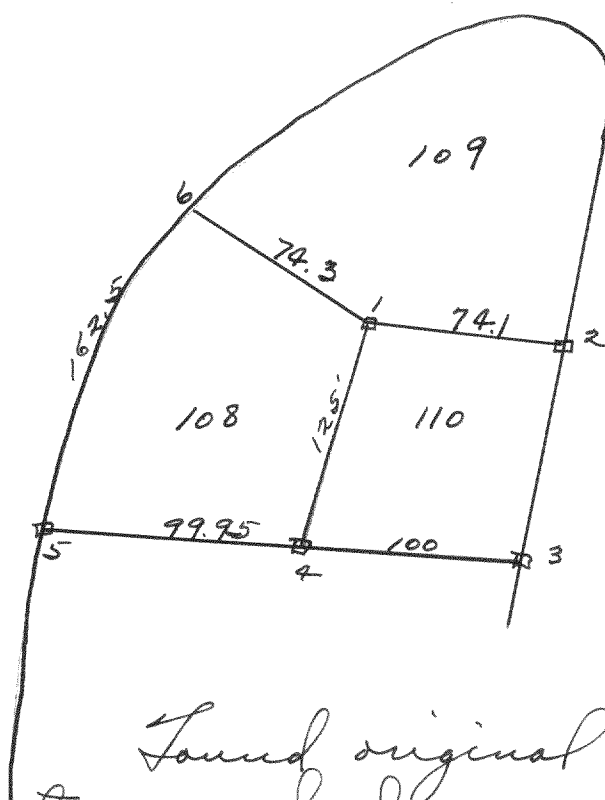


Found original woodstakes at points marked 1, 2, 3, 4 & 5. Replaced 1, 2 & 5 with iron pipes.

Located point 6 by measuring 74.3' from 1 and 162.5' from 5, placed iron pipe at intersection.

Survey made for property owners of the County Club Estates.

Surveyed by Lloyd S. Jensen
County Surveyor

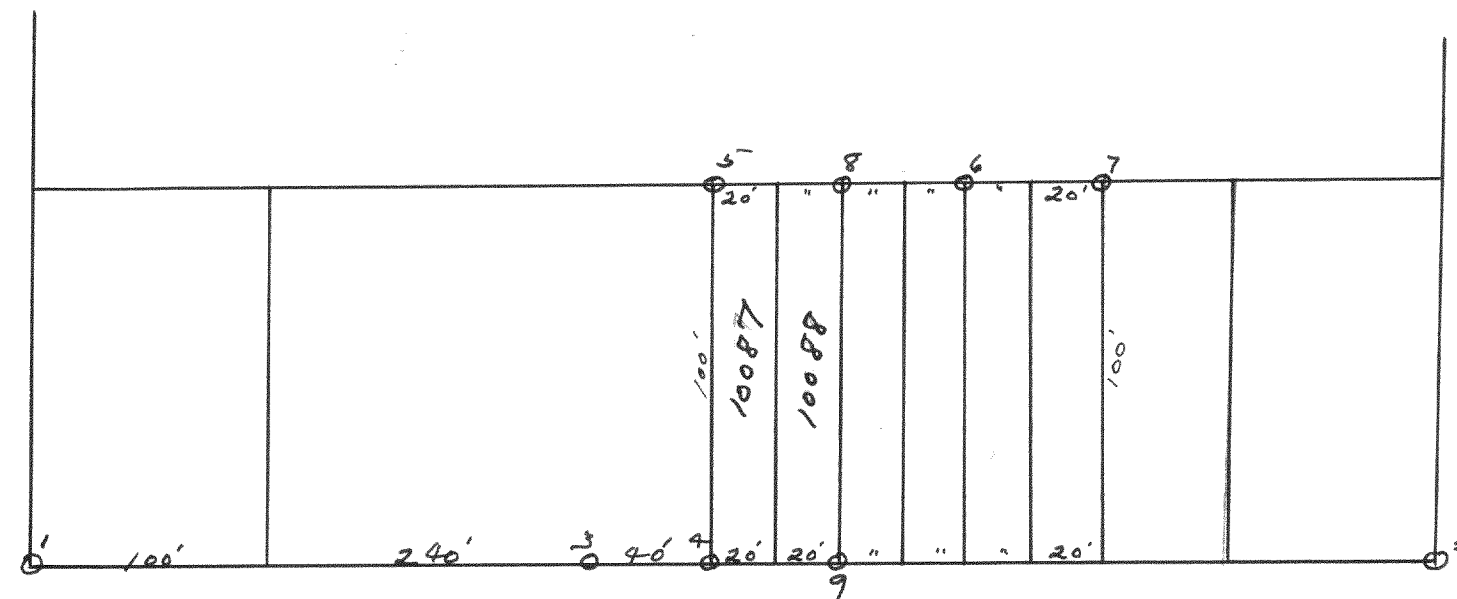

Satinwood Road

Plot of survey of lots 100, 87 & 88 in Lake Como Beach Subdivision.

Found iron pipes at points 1, 2, 3, 4, 5, 6 & 7 at the measured distances given.

Placed iron pipes at points 8 & 9.

Surveyed by Lloyd S. Jensen
County Surveyor