


Record of Survey.
No. 586- LOT IN NE 1/4 SEC 5, T4N, R15E
IN CITY OF WHITEWATER

Township..... North of Range..... of 4 Principal Meridian
as presented by the courses and distances on the following plat, and annexed field-notes of survey:
Established the center of the section at the point of intersection of STRAIGHT quarter lines.
Established all quarter-quarter corners upon the section boundary at proportional distances between known section and quarter section corners, according to the original field-notes of the Government survey.
Established all lost corners at proportionate distances between known corners, according to the original field notes of the Government survey.

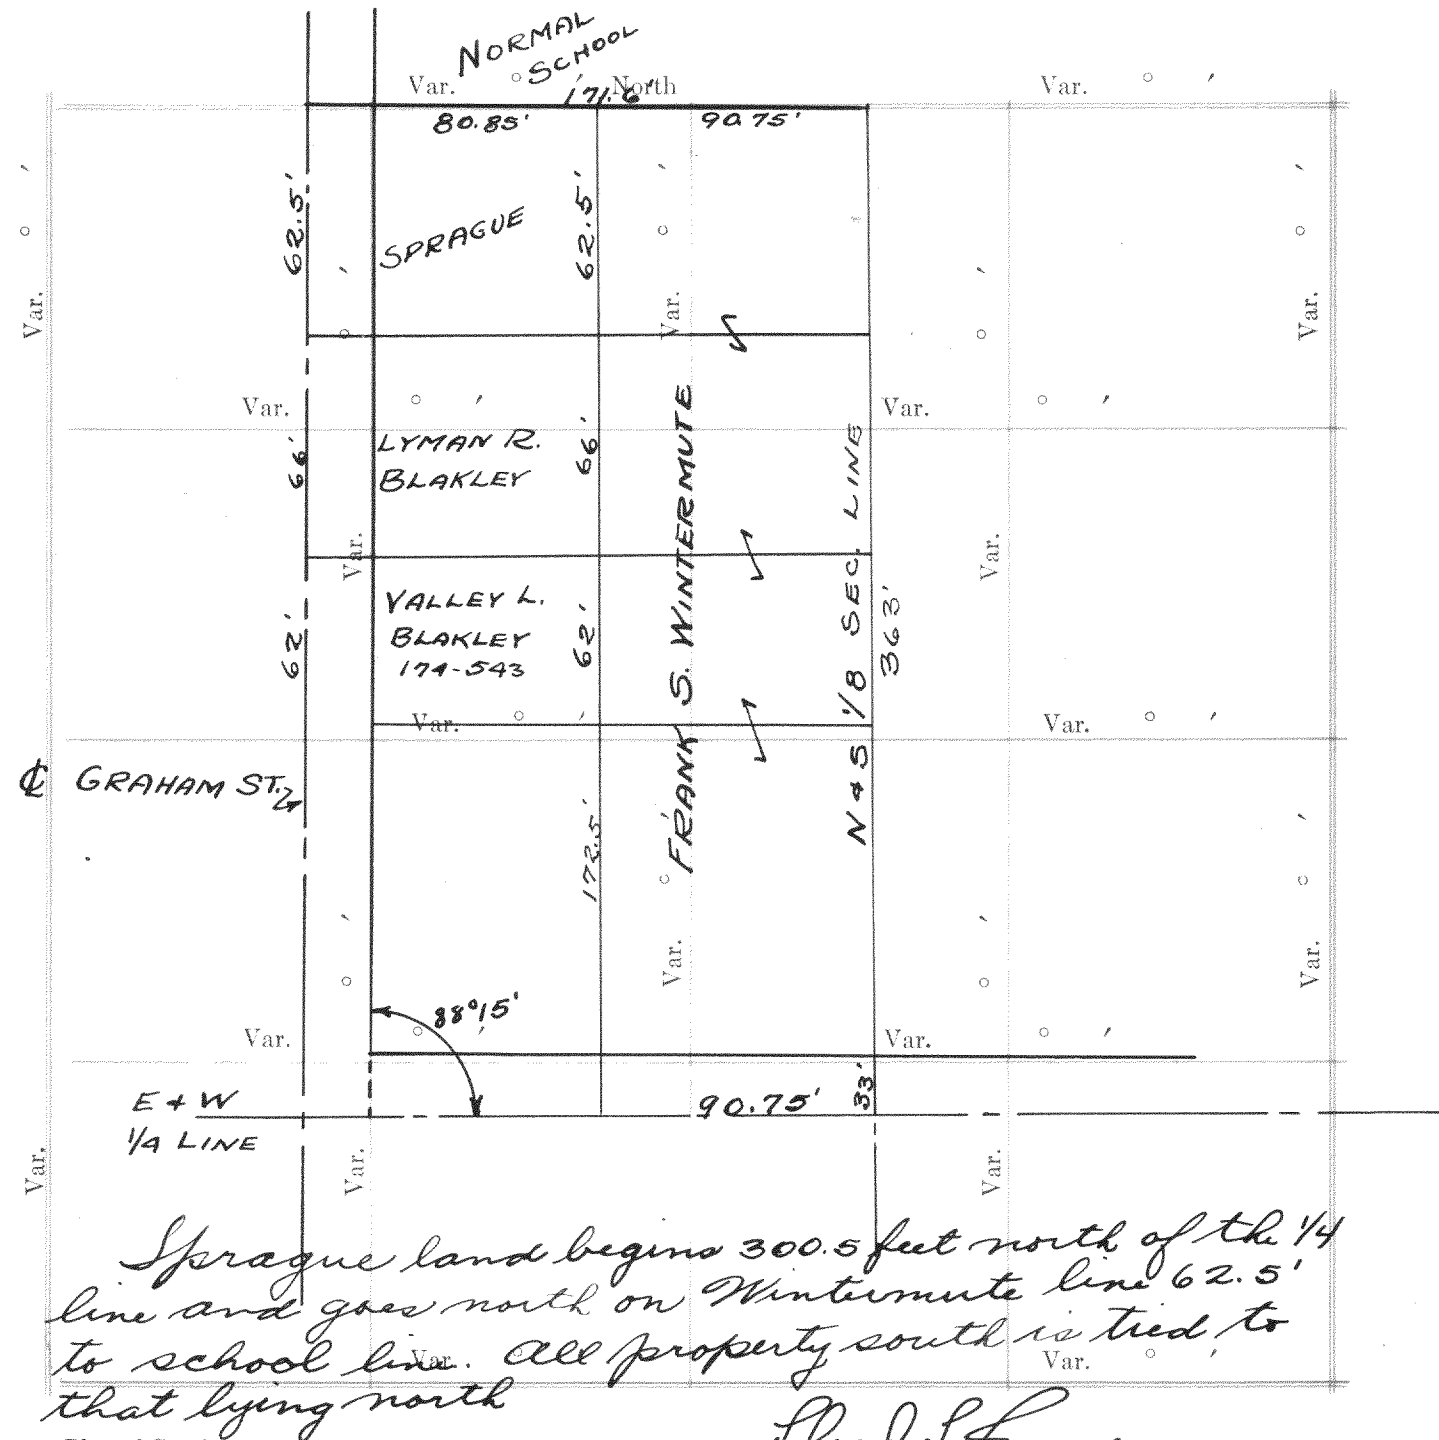

Plat of Section..... Township..... North, Range..... of 4 Principal Meridian Scale
80 chains to 6 inches. The figures in red ink are the lengths of the lines as stated in the field-notes of the Government survey.


Declination of the Magnetic Meridian from the True Meridian.....
Surveyed and sub-divided..... A. D. 1....., in accordance
with the State Laws and Instructions of the Commissioner of the General Land office, and recorded on pages
..... of Register in the County Clerk's office.

Witness my hand this..... day of..... A. D. 1.....
..... SURVEYOR.

DESCRIPTION

OF SECTION, QUARTER SECTION AND QUARTER QUARTER SECTION CORNERS

GOVERNMENT CORNERS				H. C. MILLER & CO. MAP STATIONERS, MILWAUKEE, WIS.				H. C. MILLER & CO. MAP STATIONERS, MILWAUKEE, WIS.			
Bearing	In.	Courses	Links	Bearing	In.	Courses	Links	Bearing	In.	Courses	Links
Traces	Dia.	they bear	Distant	Traces	Dia.	they bear	Distant	Traces	Dia.	they bear	Distant
No. 587- LOTS 12 & 13, BLOCK 62 OF INTERLAKEN SUB.											
1. N. E. Sec. Cor. identified.											
2. N. E. Sec. Cor. identified.											
3. S. E. Sec. Cor. identified.											
4. S. W. Sec. Cor. identified.											
5. N. 1/4 Sec. Cor. identified.											
6. E. 1/4 Sec. Cor. identified.											
7. S. 1/4 Sec. Cor. identified.											
8. W. 1/4 Sec. Cor. identified.											
Subdivision Corners											
No. 1. Center 1/4 Sec. Cor.											
2. North 1/4-1/4s N. W. qr.,											
3. East 1/4-1/4s N. W. qr.,											
4. South 1/4-1/4s N. W. qr.,											
5. West 1/4-1/4s N. W. qr.,											
6. Center 1/4-1/4s N. W. qr.,											
7. North 1/4-1/4s N. E. qr.,											
8. East 1/4-1/4s N. E. qr.,											
9. South 1/4-1/4s N. E. qr.,											
10. Center 1/4-1/4s N. E. qr.,											
11. East 1/4-1/4s S. E. qr.,											
12. South 1/4-1/4s S. E. qr.,											
13. West 1/4-1/4s S. E. qr.,											
14. Center 1/4-1/4s S. E. qr.,											
15. South 1/4-1/4s S. W. qr.,											
16. West 1/4-1/4s S. W. qr.,											
17. Center 1/4-1/4s S. W. qr.											

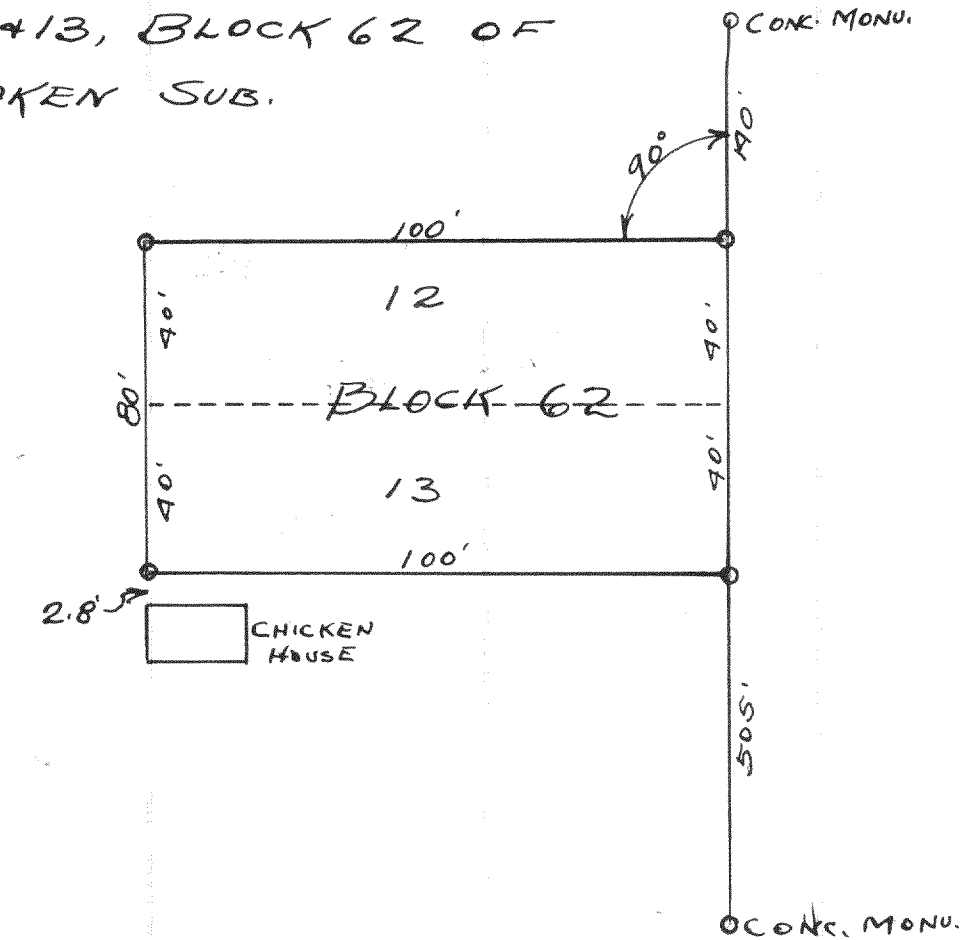


Plat of a survey of lots 12 & 13
of block 62 of Interlaken Sub.

Feb. 6, 1935 Lloyd S. Jensen
Co. Sur.

NAMES OF SWORN ASSISTANTS

CHAINMEN	FLAGMEN	AXMEN

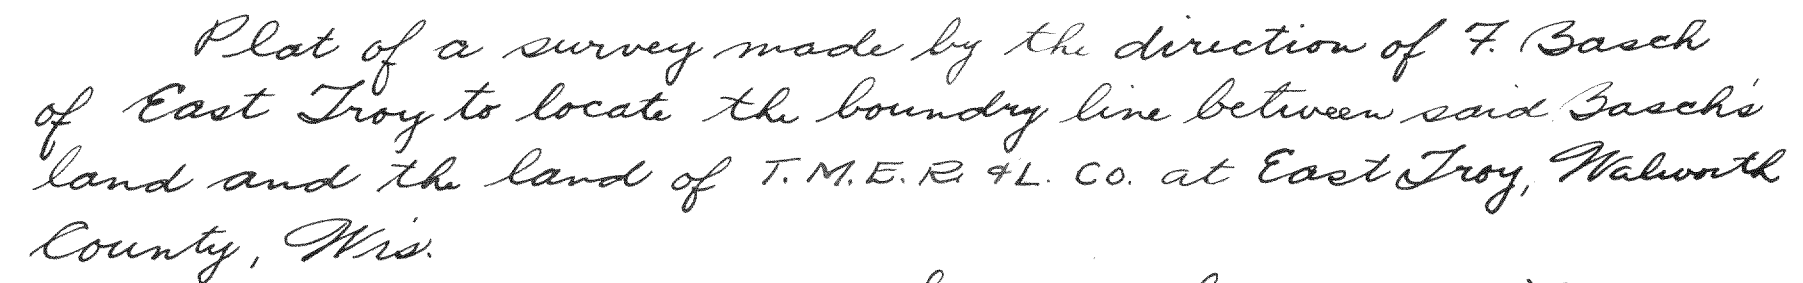

Surveyed by Wm. Child, C. S.
Recorded by Lloyd S. Jensen
C. S.

Plat of a survey in SE 1/4 sec. 13, T1 N,
R15 E for C. F. Corne.

Surveyed by Wm Child, C.S.
Recorded by Lloyd S. Jensen
C. Sur.