


No 590

Record of Survey.

BLOCK 19, ORIGINAL TOWN, EAST TROY

Township....., North of Range.....of 4 Principal Meridian
as presented by the courses and distances on the following plat, and annexed field-notes of survey:
Established the center of the section at the point of intersection of STRAIGHT quarter lines.
Established all quarter-quarter corners upon the section boundary at proportional distances between known section and quarter section corners, according to the original field-notes of the Government survey.
Established all lost corners at proportionate distances between known corners, according to the original field notes of the Government survey.

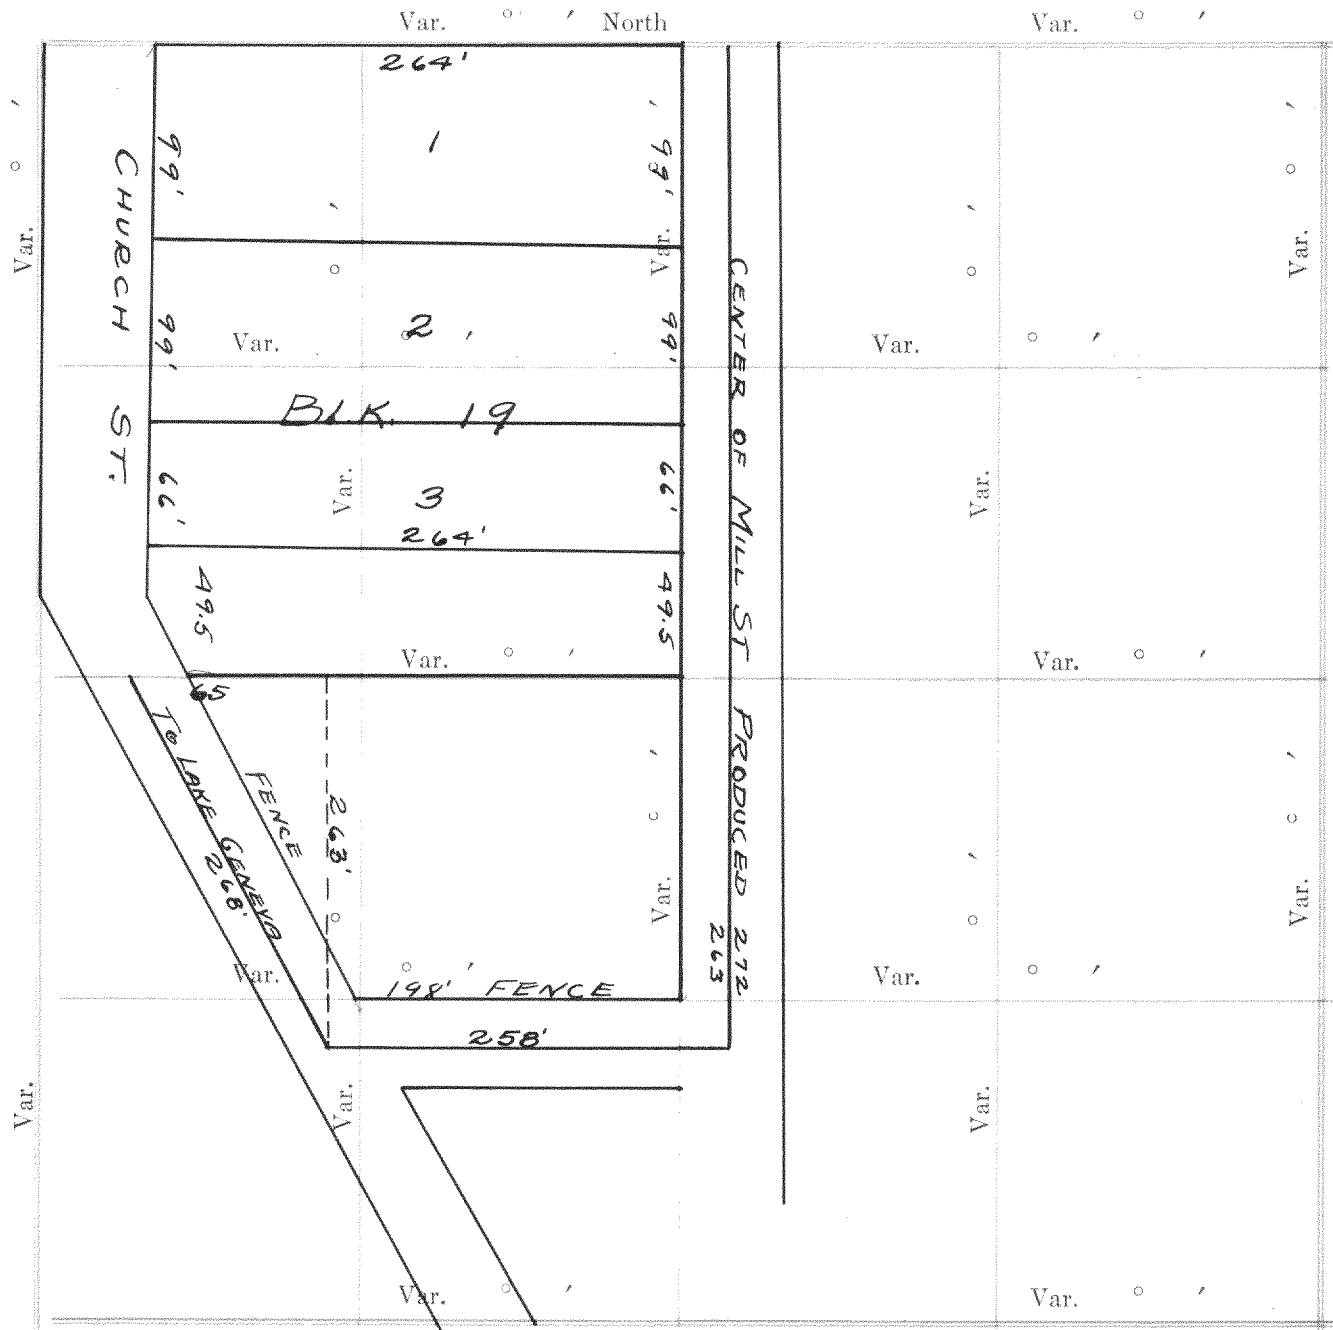

Plat of a survey of block 19 of the original town in the village of East Troy, Walworth County, Wis.

Declination of the Magnetic Meridian from the True Meridian.....
Surveyed and sub-divided.....
with the State Laws and Instructions of the Commissioner of the General Land office, and recorded on pages.....

Witness my hand this.....day of.....A. D. 1.....

SURVEYOR.

DESCRIPTION

OF SECTION, QUARTER SECTION AND QUARTER QUARTER SECTION CORNERS

GOVERNMENT CORNERS

Bearing Trees In. Dia. Courses they bear Links Distant Bearing Trees In. Dia. Courses they bear Links Distant Bearing Trees In. Dia. Courses they bear Links Distant Bearing Trees In. Dia. Courses they bear Links Distant

H. C. MILLER CO., MFG. STATIONERS, MILWAUKEE X15000

No.
1. N. W. Sec. Cor. identified,
2. N. E. Sec. Cor. identified,
3. S. E. Sec. Cor. identified,
4. S. W. Sec. Cor. identified,

NO. 591 BLOCK 1, S.B. EDWARDS ADDITION
TO VILLAGE OF EAST TROY

5. N. $\frac{1}{4}$ Sec. Cor. identified,
6. E. $\frac{1}{4}$ Sec. Cor. identified,
7. S. $\frac{1}{4}$ Sec. Cor. identified,
8. W. $\frac{1}{4}$ Sec. Cor. identified,

Subdivision Corners

No.
1. Center $\frac{1}{4}$ Sec. Cor.
2. North $\frac{1}{4}$ - $\frac{1}{4}$ s N. W. qr.,
3. East $\frac{1}{4}$ - $\frac{1}{4}$ s N. W. qr.,
4. South $\frac{1}{4}$ - $\frac{1}{4}$ s N. W. qr.,
5. West $\frac{1}{4}$ - $\frac{1}{4}$ s N. W. qr.,
6. Center $\frac{1}{4}$ - $\frac{1}{4}$ s N. W. qr.,
7. North $\frac{1}{4}$ - $\frac{1}{4}$ s N. E. qr.,
8. East $\frac{1}{4}$ - $\frac{1}{4}$ s N. E. qr.,
9. South $\frac{1}{4}$ - $\frac{1}{4}$ s N. E. qr.,
10. Center $\frac{1}{4}$ - $\frac{1}{4}$ s N. E. qr.,

11. East $\frac{1}{4}$ - $\frac{1}{4}$ s S. E. qr.,
12. South $\frac{1}{4}$ - $\frac{1}{4}$ s S. E. qr.,
13. West $\frac{1}{4}$ - $\frac{1}{4}$ s S. E. qr.,
14. Center $\frac{1}{4}$ - $\frac{1}{4}$ s S. E. qr.,
15. South $\frac{1}{4}$ - $\frac{1}{4}$ s S. W. qr.,
16. West $\frac{1}{4}$ - $\frac{1}{4}$ s S. W. qr.,
17. Center $\frac{1}{4}$ - $\frac{1}{4}$ s S. W. qr.

Plat of a survey in Block 1 of
S. B. Edwards Addition to the
Village of East Troy

Surveyed by Wm. Child, C.S.
Recorded by Lloyd S. Jensen

Plat of a survey in Block 1 of S. B. Edwards Addition to the Village of East Troy

Surveyed by Wm. Child, C.S.
Recorded by Floyd C. Jensen
Co. Sur.

NAMES OF SWORN ASSISTANTS

FLAGMEN

AXMEN

CHAINMEN

