

No. 682

Survey and construction notes for The Borg
Dam located in Section 20, T2N, R16E.

June to Dec. 1934

Lloyd V. Jensen
County Surveyor.


No. 683

Survey of lots 8 & 9 of Block 8 of Tupper
2nd Addition to the City of Whitewater, Wis.
No stakes were found, measurements were
taken from fences and side walks. This
survey was made to locate the bounds
approximately for grading purposes for
a skating rink.

April 1935

Lloyd V. Jensen
County Surveyor

No. 684 Survey to locate the house on
lot 7 of Mereness Springs and lot 1
of San Sanci, located in Section 22,
T2N, R16E.

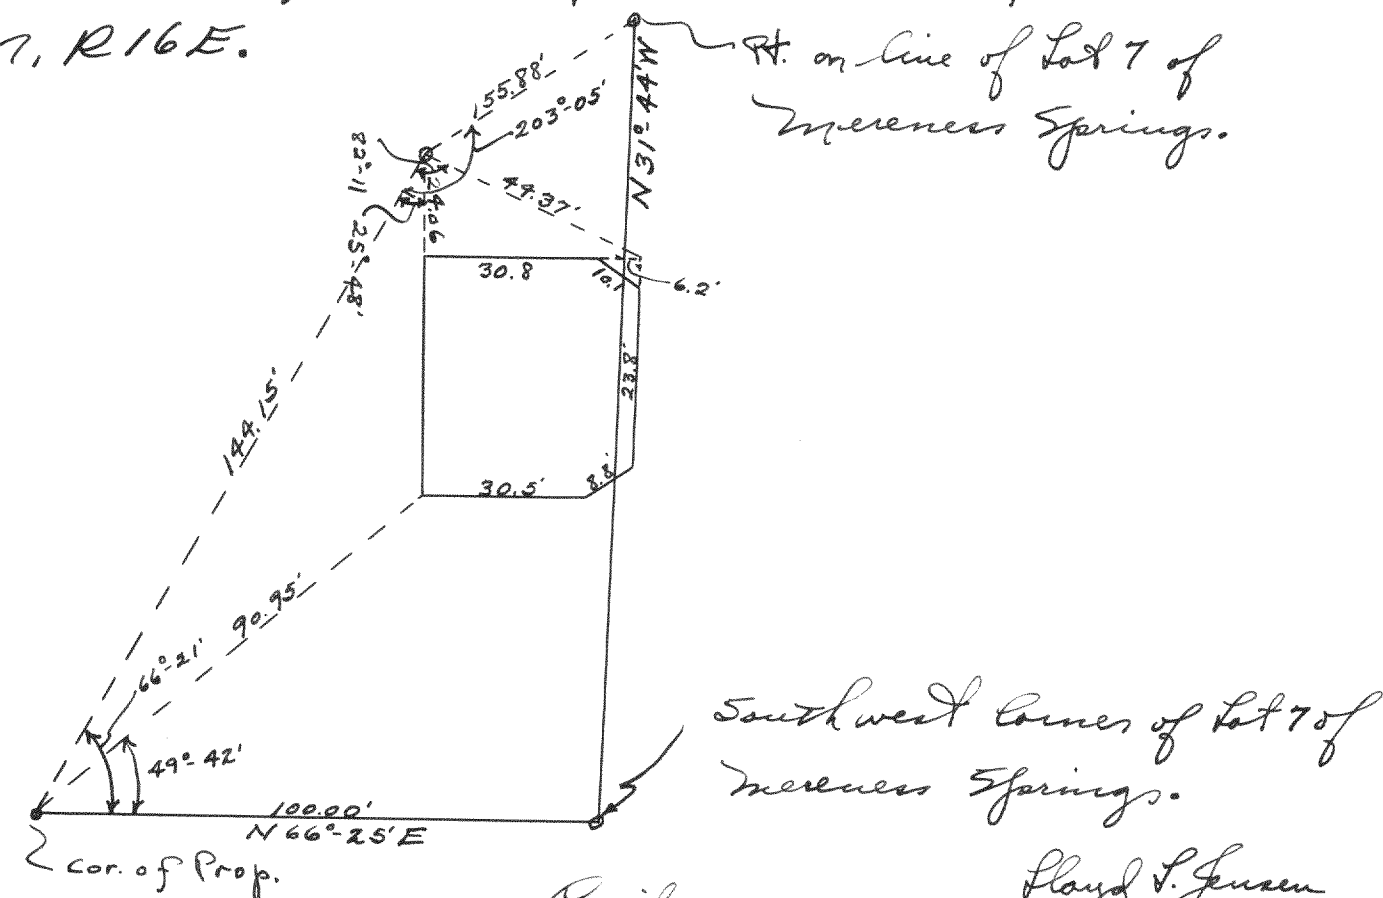

No. 685

Survey of the intersection of St. Trunk Highway 89
and St. Trunk Highway 15. Survey was made to locate
all of the physical objects within the area at the
corner and 300' South and 200' West. The location
of the lot corner on the Northeast corner of the
intersection was gotten from survey No. 628.
Notes were plotted and were used in an
auto accident suit.

April 1935

Lloyd V. Jensen
Co. Surveyor.

No. 686

Survey to locate the physical features
at the intersection of State Trunk Highway 89
and County Trunk Highway "O" located in
Section 7, T1N, R16E. Notes were plotted and
the map was as evidence in an auto
accident case, at Walworth County Circuit
Courtroom.

April 1935

Lloyd V. Jensen
County Surveyor