


Record of Survey.

Township....., North of Range.....of 4 Principal Meridian as presented by the courses and distances on the following plat, and annexed field-notes of survey:
Established the center of the section at the point of intersection of STRAIGHT quarter lines.
Established all quarter-quarter corners upon the section boundary at proportional distances between known section and quarter section corners, according to the original field-notes of the Government survey.
Established all lost corners at proportionate distances between known corners, according to the original field notes of the Government survey.

No. 704

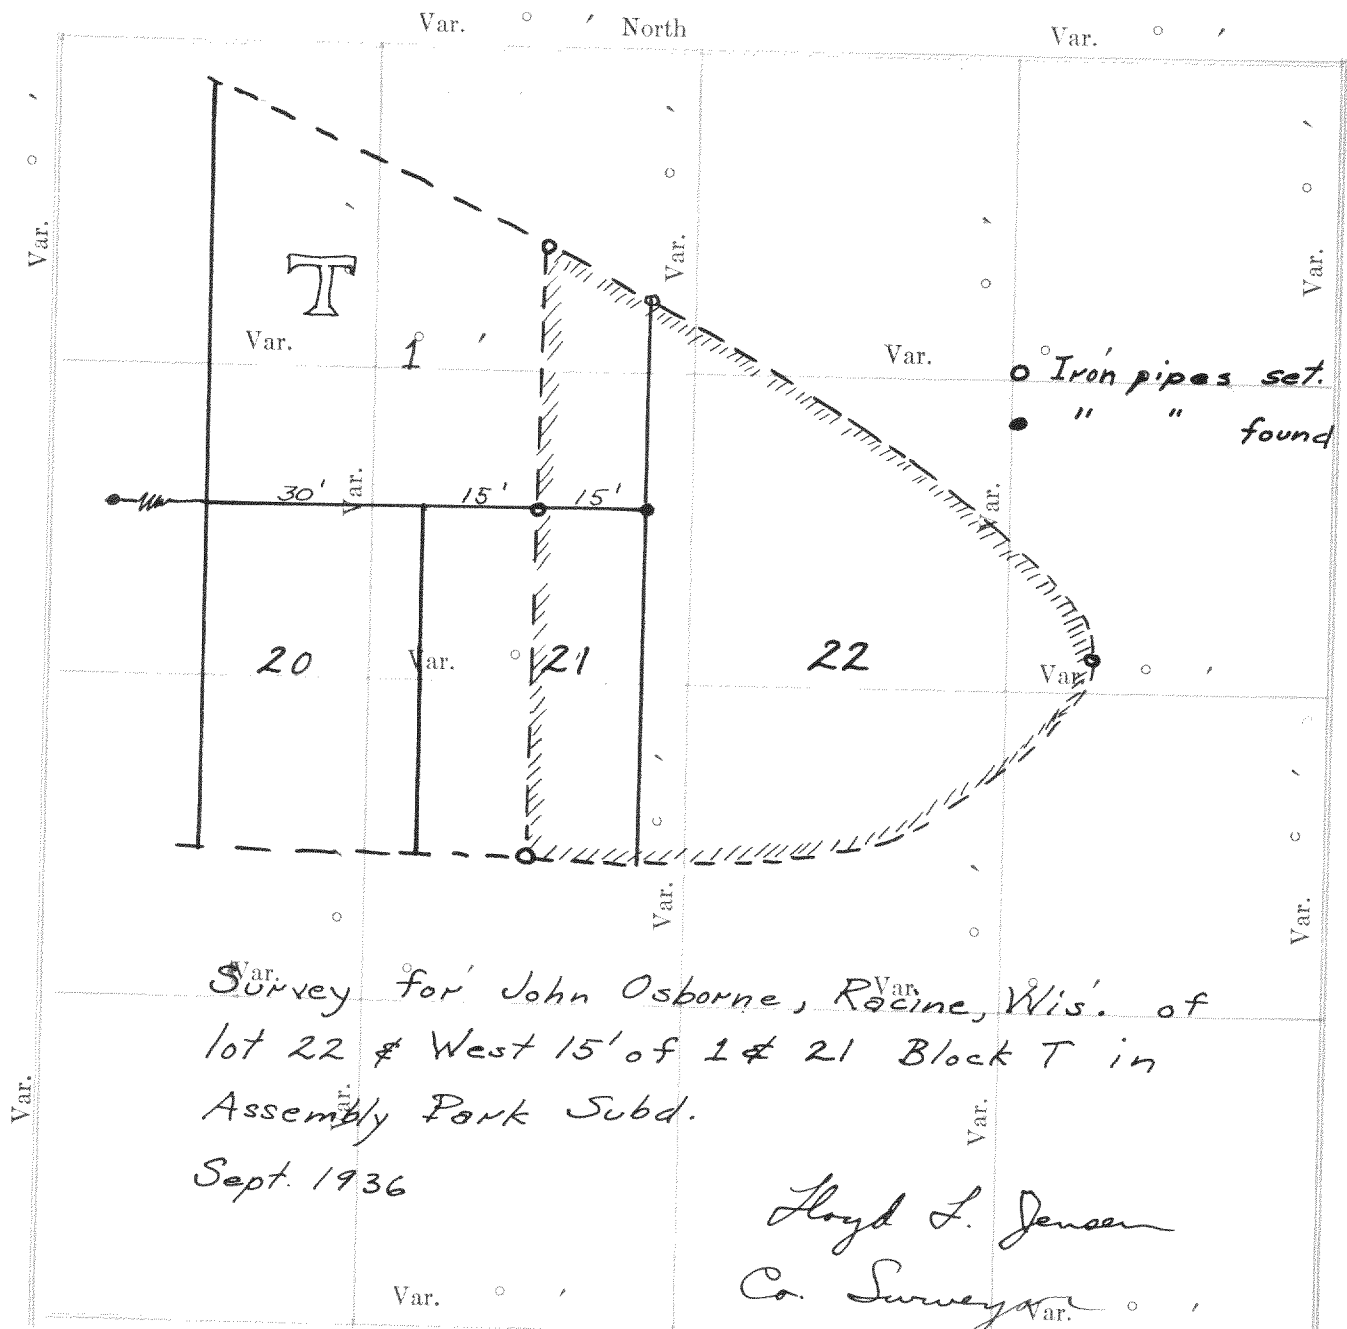

Survey for John Osborne, Racine, Wis. of lot 22 & West 15' of 1 & 21 Block T in Assembly Park Subd.

Sept. 1936

Lloyd L. Jensen
Co. Surveyor

Recorded by W. E. H.

Plat of Section....., Township.....North, Range.....of 4 Principal Meridian Scale 80 chains to 6 inches. The figures in red ink are the lengths of the lines as stated in the field-notes of the Government survey.

Declination of the Magnetic Meridian from the True Meridian.....

Surveyed and sub-divided.....A. D. 1....., in accordance with the State Laws and Instructions of the Commissioner of the General Land office, and recorded on pages.....of Register in the County Clerk's office.

Witness my hand this.....day of.....A. D. 1.....

SURVEYOR.

DESCRIPTION

227

OF SECTION, QUARTER SECTION AND QUARTER QUARTER SECTION CORNERS

GOVERNMENT CORNERS

- No. 1. N. W. Sec. Cor. identified,
2. N. E. Sec. Cor. identified,
3. S. E. Sec. Cor. identified,
4. S. W. Sec. Cor. identified,
5. N. $\frac{1}{4}$ Sec. Cor. identified,
6. E. $\frac{1}{4}$ Sec. Cor. identified,
7. S. $\frac{1}{4}$ Sec. Cor. identified,
8. W. $\frac{1}{4}$ Sec. Cor. identified,


Subdivision Corners

- No. 1. Center $\frac{1}{4}$ Sec. Cor.,
2. North $\frac{1}{4}$ - $\frac{1}{4}$ s N. W. qr.,
3. East $\frac{1}{4}$ - $\frac{1}{4}$ s N. W. qr.,
4. South $\frac{1}{4}$ - $\frac{1}{4}$ s N. W. qr.,
5. West $\frac{1}{4}$ - $\frac{1}{4}$ s N. W. qr.,
6. Center $\frac{1}{4}$ - $\frac{1}{4}$ s N. W. qr.,
7. North $\frac{1}{4}$ - $\frac{1}{4}$ s N. E. qr.,
8. East $\frac{1}{4}$ - $\frac{1}{4}$ s N. E. qr.,
9. South $\frac{1}{4}$ - $\frac{1}{4}$ s N. E. qr.,
10. Center $\frac{1}{4}$ - $\frac{1}{4}$ s N. E. qr.,
11. East $\frac{1}{4}$ - $\frac{1}{4}$ s S. E. qr.,
12. South $\frac{1}{4}$ - $\frac{1}{4}$ s S. E. qr.,
13. West $\frac{1}{4}$ - $\frac{1}{4}$ s S. E. qr.,
14. Center $\frac{1}{4}$ - $\frac{1}{4}$ s S. E. qr.,
15. South $\frac{1}{4}$ - $\frac{1}{4}$ s S. W. qr.,
16. West $\frac{1}{4}$ - $\frac{1}{4}$ s S. W. qr.,
17. Center $\frac{1}{4}$ - $\frac{1}{4}$ s S. W. qr.

Bearing	In.	Courses	Links	Bearing	In.	Courses	Links	Bearing	In.	Courses	Links
Trees	Dia.	they bear	Distant	Trees	Dia.	they bear	Distant	Trees	Dia.	they bear	Distant

No. 705

Cisco Beach Subd.

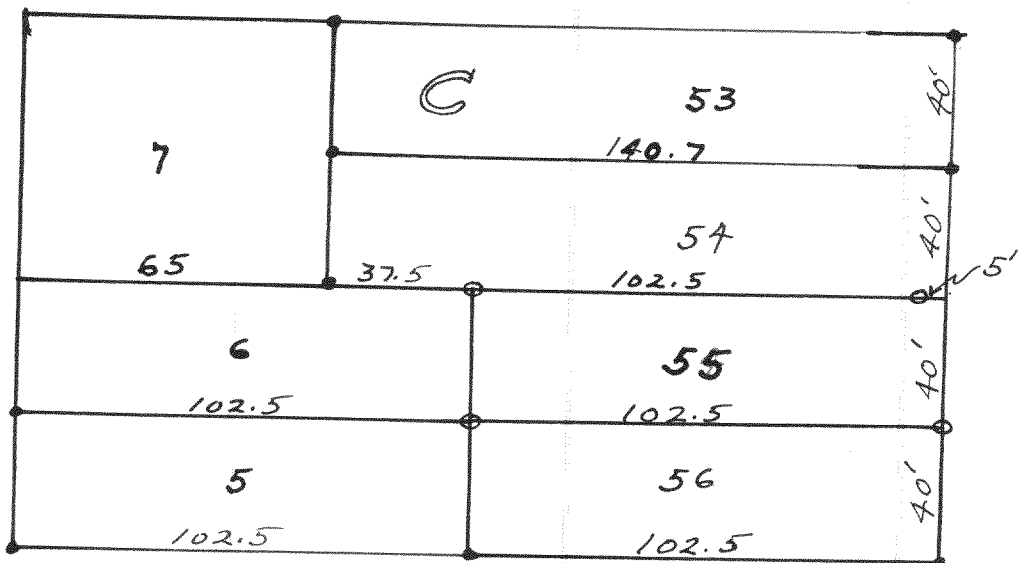

Iron pipes set
pins found

Survey of lot 55, Block C of Cisco Beach Subd. for L. C. Schuster of Chicago, Illinois.

Sept. 1936

Lloyd L. Jensen
Co. Surveyor
Recorded by W. E. H.

NAMES OF SWORN ASSISTANTS

CHAINMEN

FLAGMEN

AXMEN




Sept. 29, 1936

Lloyd L. Jansen
Co. Surveyor
Recorded by W.C.H.

No. 706 a

Woodale Add - Lake Geneva

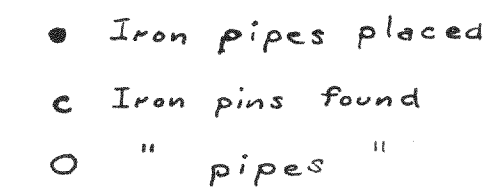

Survey of Lot 26, Block 3 for Arthur B. Jensen
Sept. 29, 1936

Lloyd L. Jensen
Co. Surveyor
Recorded by W. E. H.