

OF SECTION, QUARTER SECTION AND QUARTER QUARTER SECTION CORNERS

Established the center of the section at the point of intersection of STRAIGHT quarter lines.

Established all quarter-quarter corners upon the section boundary at proportional distances between known section and quarter section corners, according to the original field-notes of the Government survey.

Established all lost corners at proportionate distances between known corners, according to the original field notes of the Government survey.

256 are centers of storm

a & b are centers of storm
sewer manhole covers.



Var. Survey of Lot 10 & part of 11, of
Hodges Subd., City of Elkhorn Var.

of 4 Principal Meridian Scale

Witness my hand this.....day of.....A. D. 1.....

...SURVEYOR.


231

OF SECTION, QUARTER SECTION AND QUARTER QUARTER SECTION CORNERS

H. C. MILLER CO. MFG. STATIONERS, MILWAUKEE X15000

No. 720

- No. 1. Center $\frac{1}{4}$ Sec. Cor.
- line*
2. North $\frac{1}{4}$ - $\frac{1}{4}$ s N. W. qr.,
2-16
3. East $\frac{1}{4}$ - $\frac{1}{4}$ s N. W. qr.,
4. South $\frac{1}{4}$ - $\frac{1}{4}$ s N. W. qr.,
walk to house
5. West $\frac{1}{4}$ - $\frac{1}{4}$ s N. W. qr.,
Box Elder
6. Center $\frac{1}{4}$ - $\frac{1}{4}$ s N. W. qr.,
7. North $\frac{1}{4}$ - $\frac{1}{4}$ s N. E. qr.,
pipe with
8. East $\frac{1}{4}$ - $\frac{1}{4}$ s N. E. qr.,
and
9. South $\frac{1}{4}$ - $\frac{1}{4}$ s N. E. qr.,
side of east
10. Center $\frac{1}{4}$ - $\frac{1}{4}$ s N. E. qr.,
11. East $\frac{1}{4}$ - $\frac{1}{4}$ s S. E. qr.,
12. South $\frac{1}{4}$ - $\frac{1}{4}$ s S. E. qr.,
13. West $\frac{1}{4}$ - $\frac{1}{4}$ s S. E. qr.,
14. Center $\frac{1}{4}$ - $\frac{1}{4}$ s S. E. qr.,
15. South $\frac{1}{4}$ - $\frac{1}{4}$ s S. W. qr.,
16. West $\frac{1}{4}$ - $\frac{1}{4}$ s S. W. qr.,
17. Center $\frac{1}{4}$ - $\frac{1}{4}$ s S. W. qr.

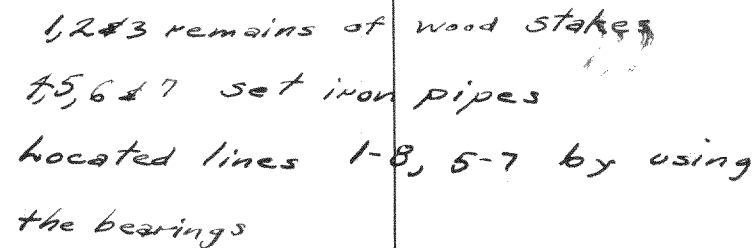

Survey of Lot 5 of La Selva in La Grange
for Mr. Rogers.

Lloyd L. Jensen
Co. Surveyor
Recorded by W. E. H.


CHAINMEN

FLAGMEN

AXMEN

231

No. 721

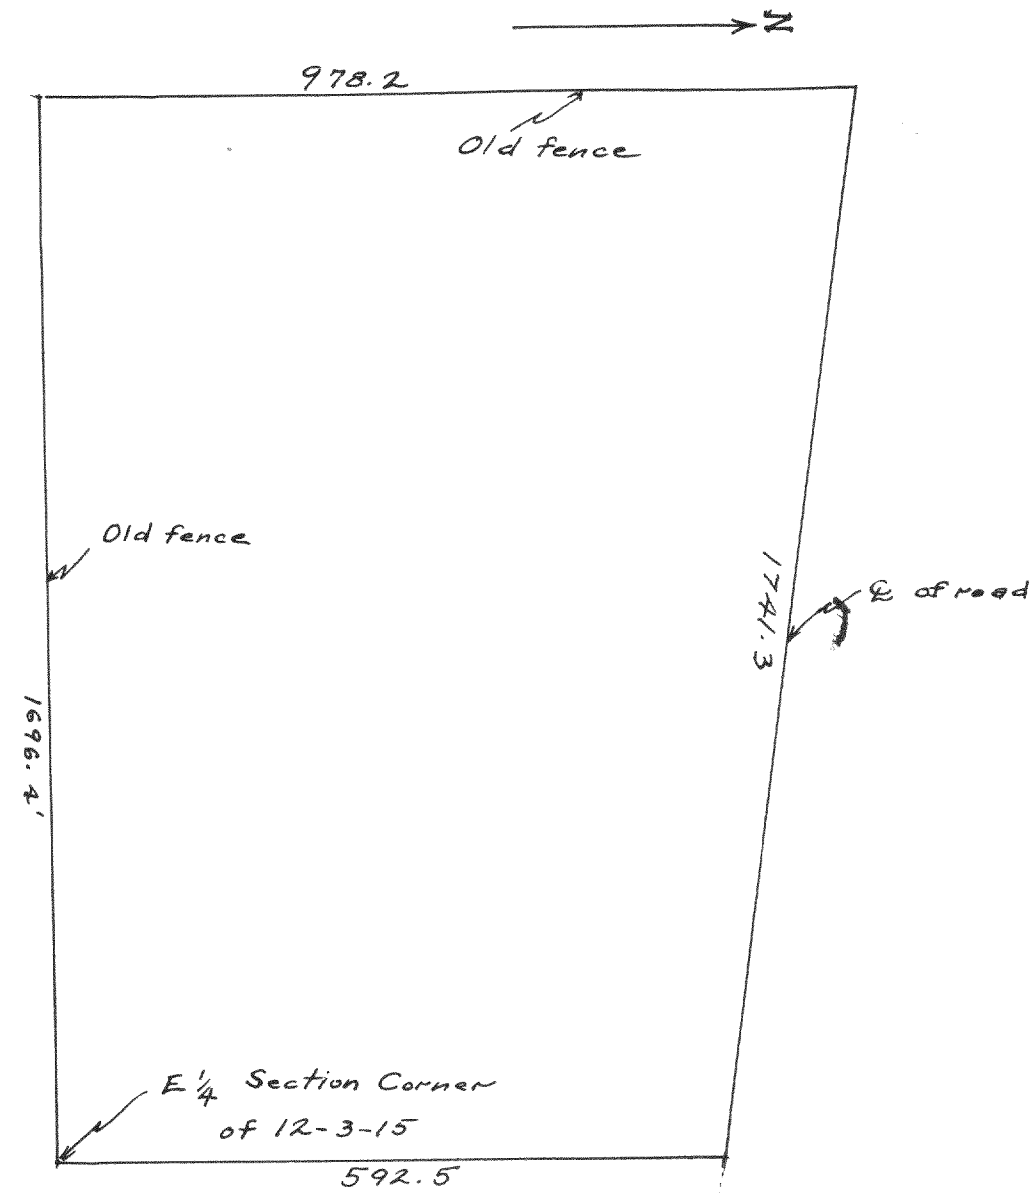


Survey for Walter Topping of
Delavan, Wisconsin.

Lloyd L. Jensen

Co. Surveyor

Recorded by W. E. H.

No. 722

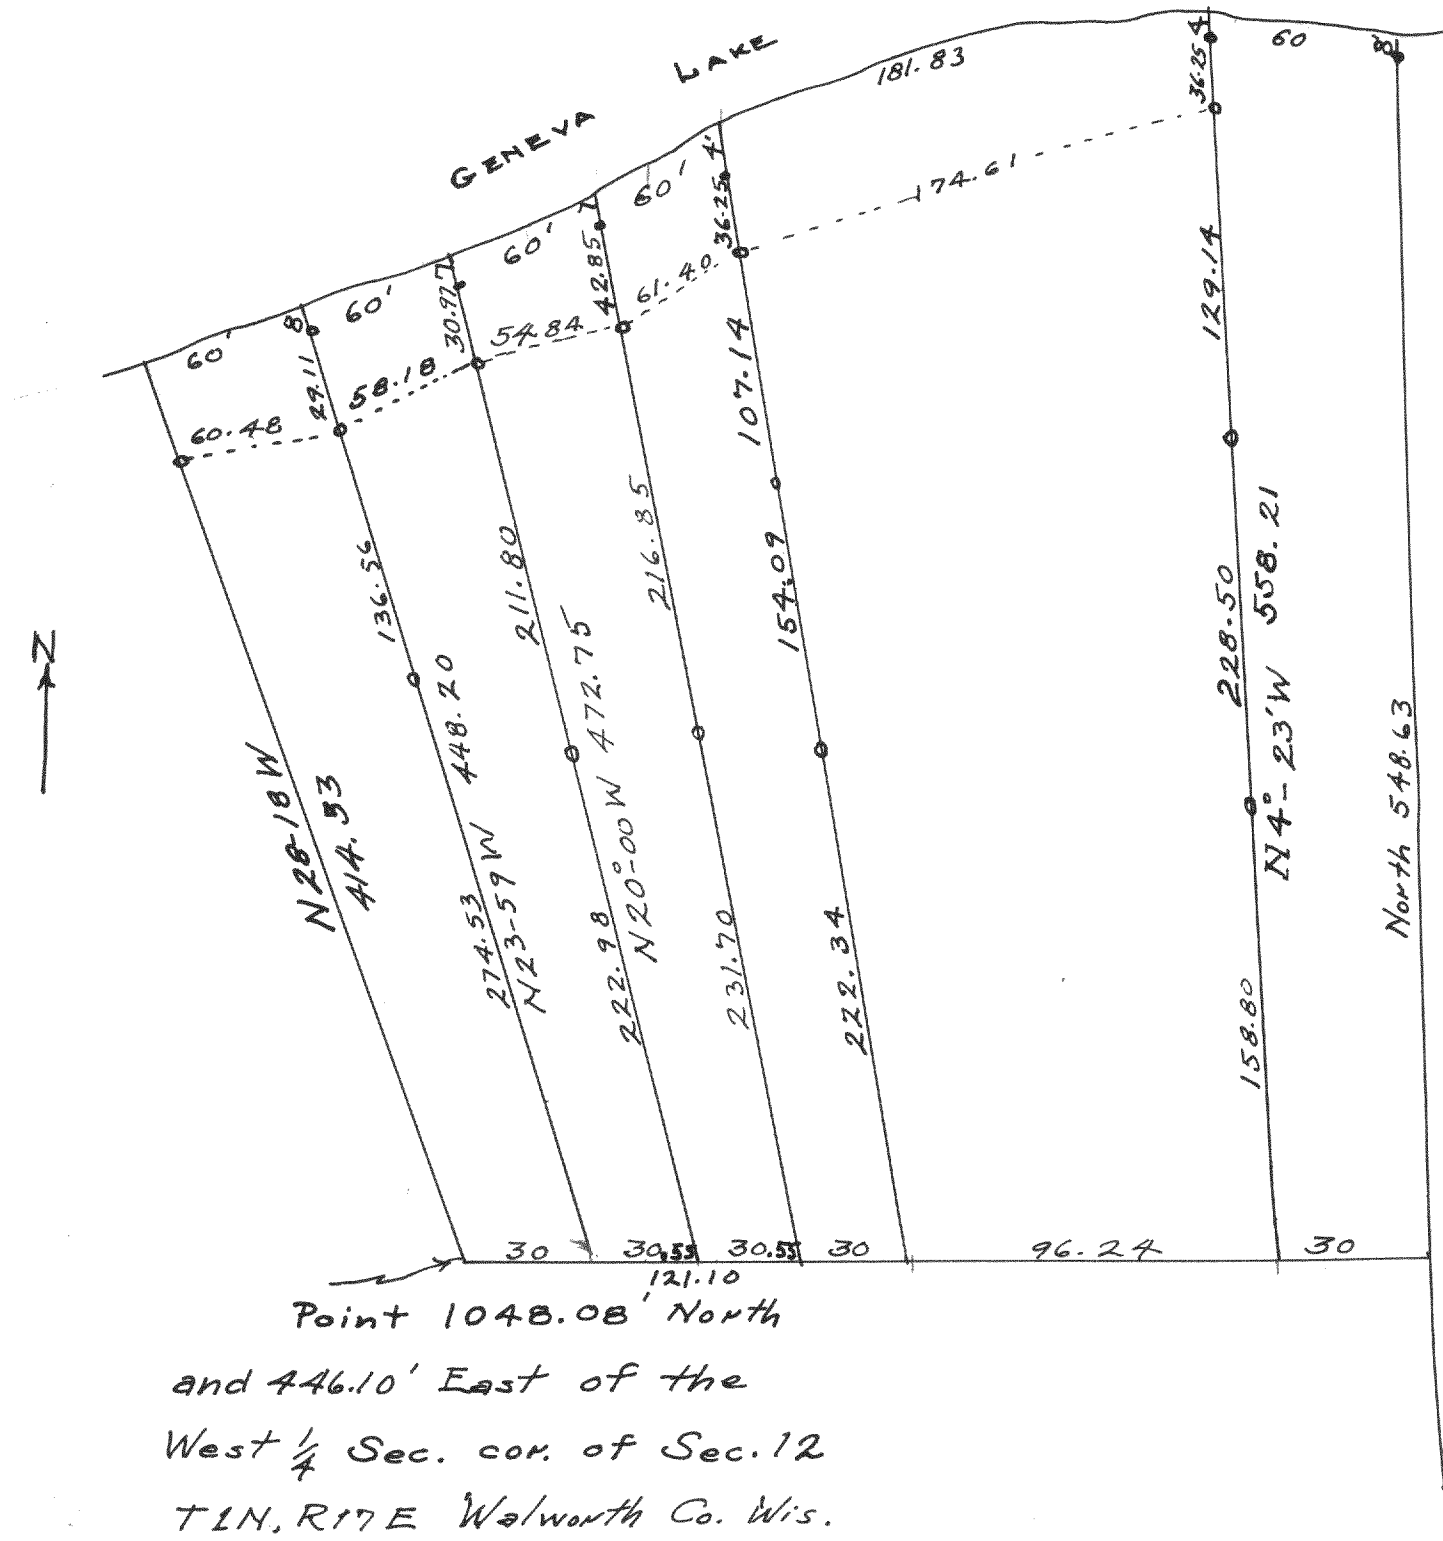

Survey of land in 12-1-17, Aug. 25, 1936 for
Wm. Silcock.

Lloyd L. Jensen

Co. Surveyor

Recorded by W. E. H.