



Township..... North of Range..... of 4 Principal Meridian
as presented by the courses and distances on the following plat, and annexed field-notes of survey:
Established the center of the section at the point of intersection of STRAIGHT quarter lines.
Established all quarter-quarter corners upon the section boundary at proportional distances between known section and quarter section corners, according to the original field-notes of the Government survey.
Established all lost corners at proportionate distances between known corners, according to the original field notes of the Government survey.

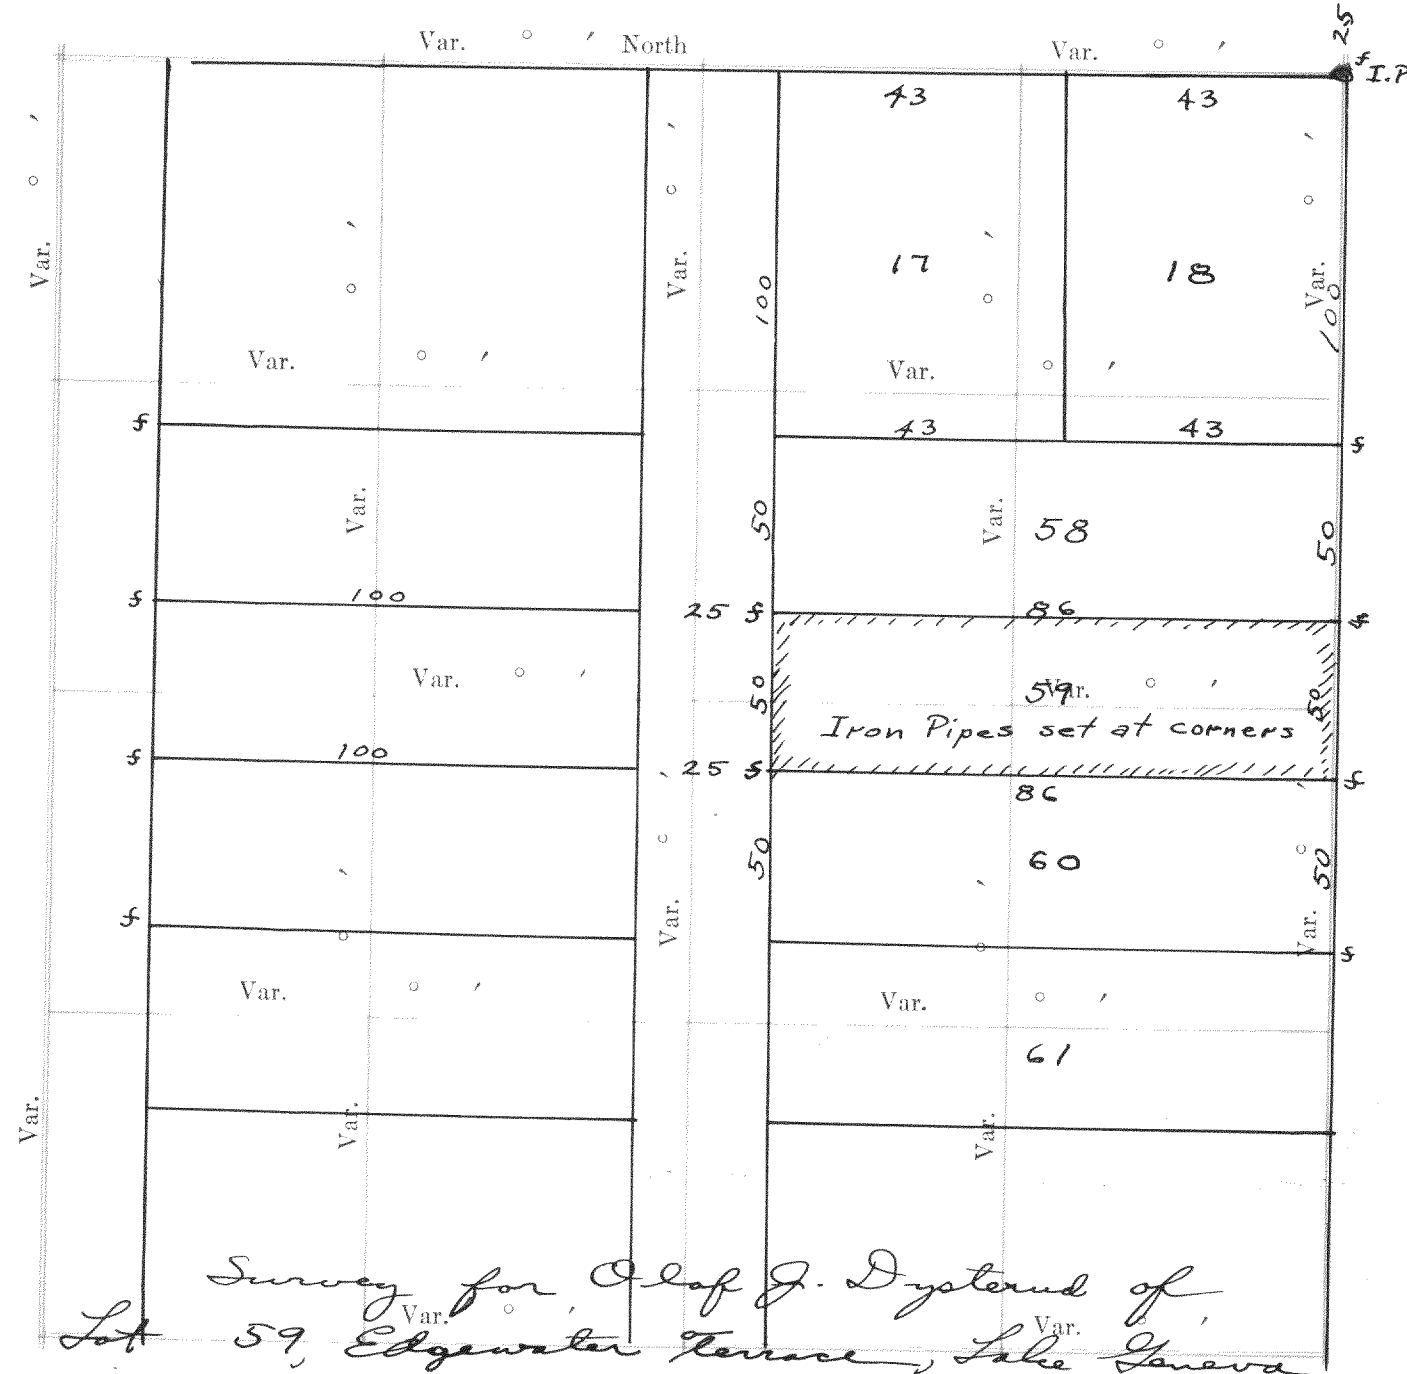

Plat of Section..... Township..... North, Range..... of 4 Principal Meridian Scale
Oct. 19, 1936
80 chains to 6 inches. The figures in red ink are the lengths of the lines as stated in the field-notes of the Government survey.
Declination of the Magnetic Meridian from the True Meridian.....
Surveyed and sub-divided..... A. D. 1..... in accordance
with the State Laws and Instructions of the Commissioner of the General Land office, and recorded on pages
..... of Register in the County Clerk's office.
Witness my hand this..... day of..... A. D. 1.....
..... SURVEYOR.

- GOVERNMENT CORNERS
- No.
1. N. W. Sec. Cor. identified,
 2. N. E. Sec. Cor. identified,
 3. S. E. Sec. Cor. identified,
 4. S. W. Sec. Cor. identified,
 5. N. 1/4 Sec. Cor. identified,
 6. E. 1/4 Sec. Cor. identified,
 7. S. 1/4 Sec. Cor. identified,
 8. W. 1/4 Sec. Cor. identified,

- Subdivision Corners
- No.
1. Center 1/4 Sec. Cor.
 2. North 1/4-1/4s N. W. qr.,
 3. East 1/4-1/4s N. W. qr.,
 4. South 1/4-1/4s N. W. qr.,
 5. West 1/4-1/4s N. W. qr.,
 6. Center 1/4-1/4s N. W. qr.,
 7. North 1/4-1/4s N. E. qr.,
 8. East 1/4-1/4s N. E. qr.,
 9. South 1/4-1/4s N. E. qr.,
 10. Center 1/4-1/4s N. E. qr.,
 11. East 1/4-1/4s S. E. qr.,
 12. South 1/4-1/4s S. E. qr.,
 13. West 1/4-1/4s S. E. qr.,
 14. Center 1/4-1/4s S. E. qr.,
 15. South 1/4-1/4s S. W. qr.,
 16. West 1/4-1/4s S. W. qr.,
 17. Center 1/4-1/4s S. W. qr.,

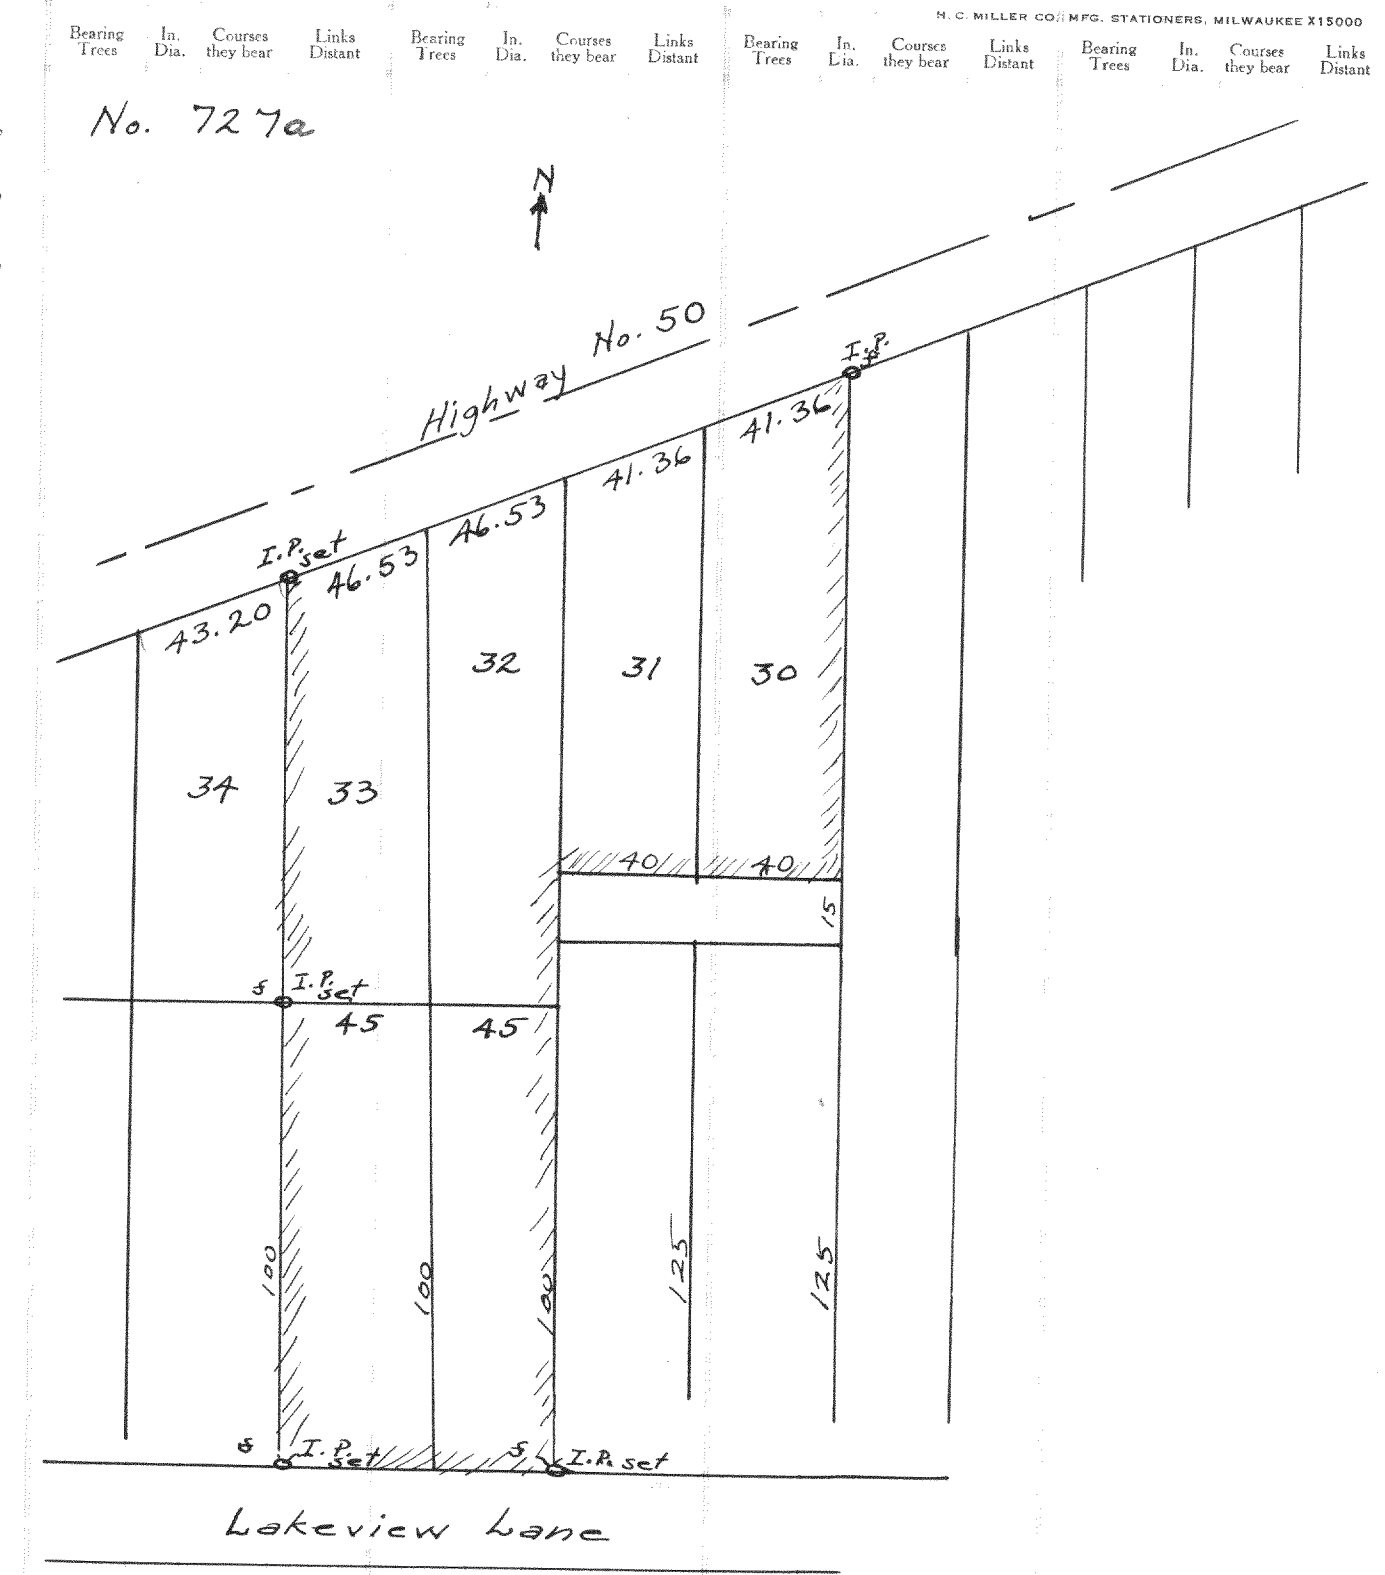


Location of West line of the
property of F. Murphy in Lake Geneva
Knoll Subdivision, Sec 33-2-17
Oct. 16, 1936
Lloyd L. Jensen
County Surveyor
By W. E. H.

CHAINMEN

NAMES OF SWORN ASSISTANTS
FLAGMEN

No. 728

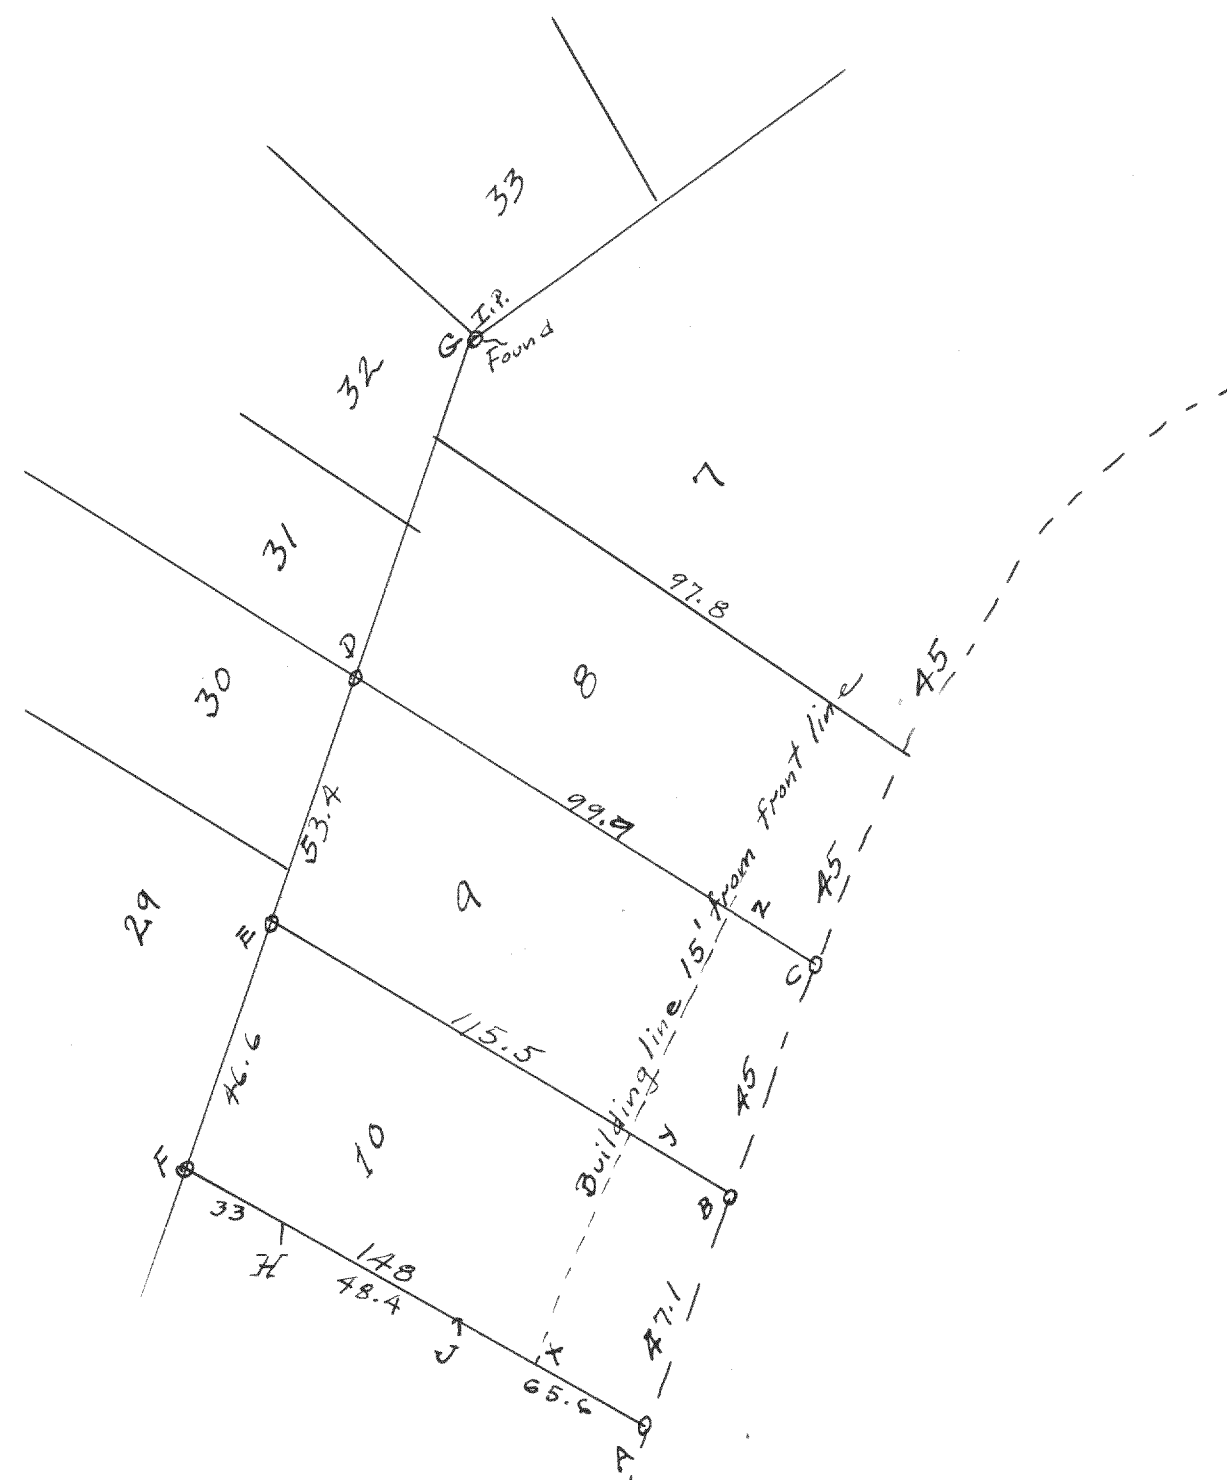


Iron pipes found at F & G
 " pins at A, B, C, D, E, H, & J

Survey of lots 9 & 10, block "G"
 of Cisco Beach for Major Evans.

Oct. 19, 1936

Lloyd L. Jensen
 County Surveyor
 By W. E. H.

No. 729

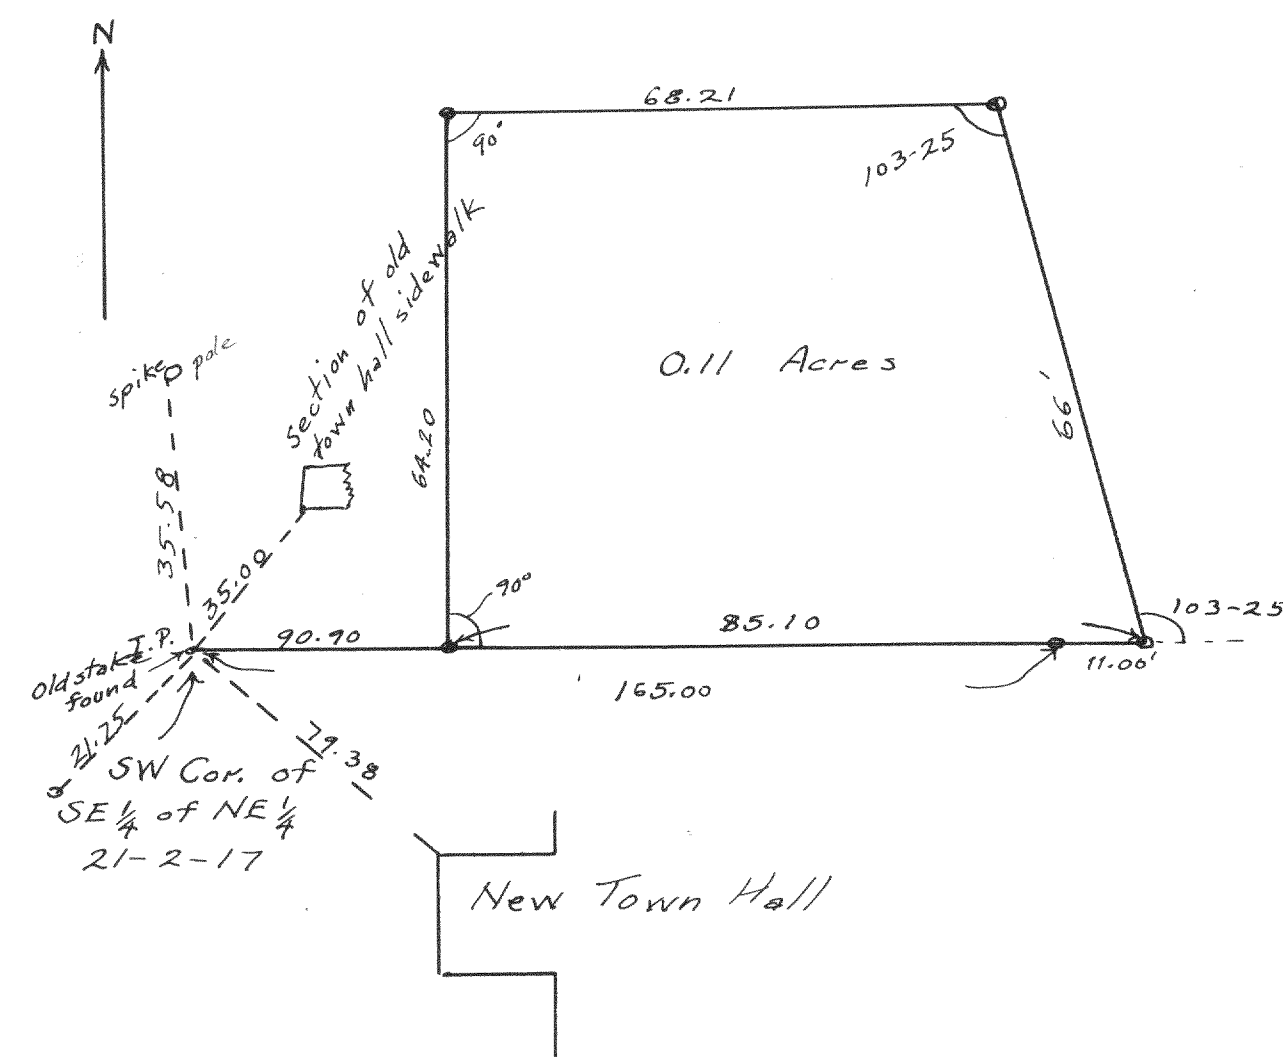

Survey for Town of Geneva.

Lloyd L. Jensen
 County Surveyor
 By W. E. H.