
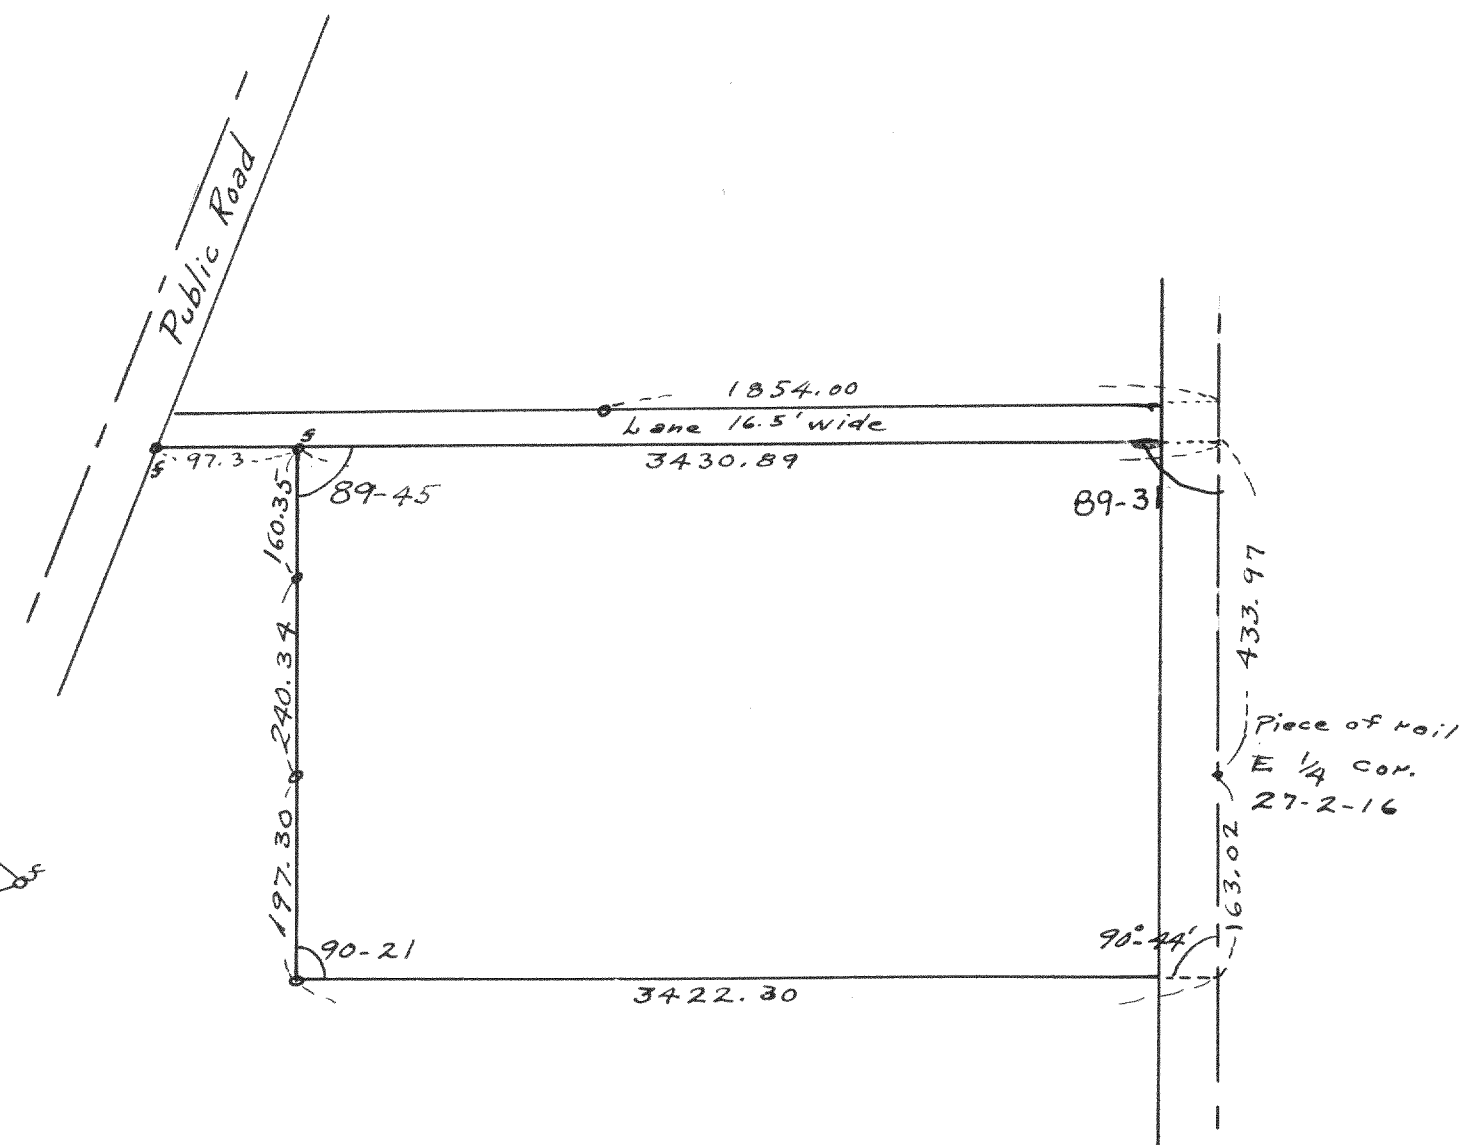


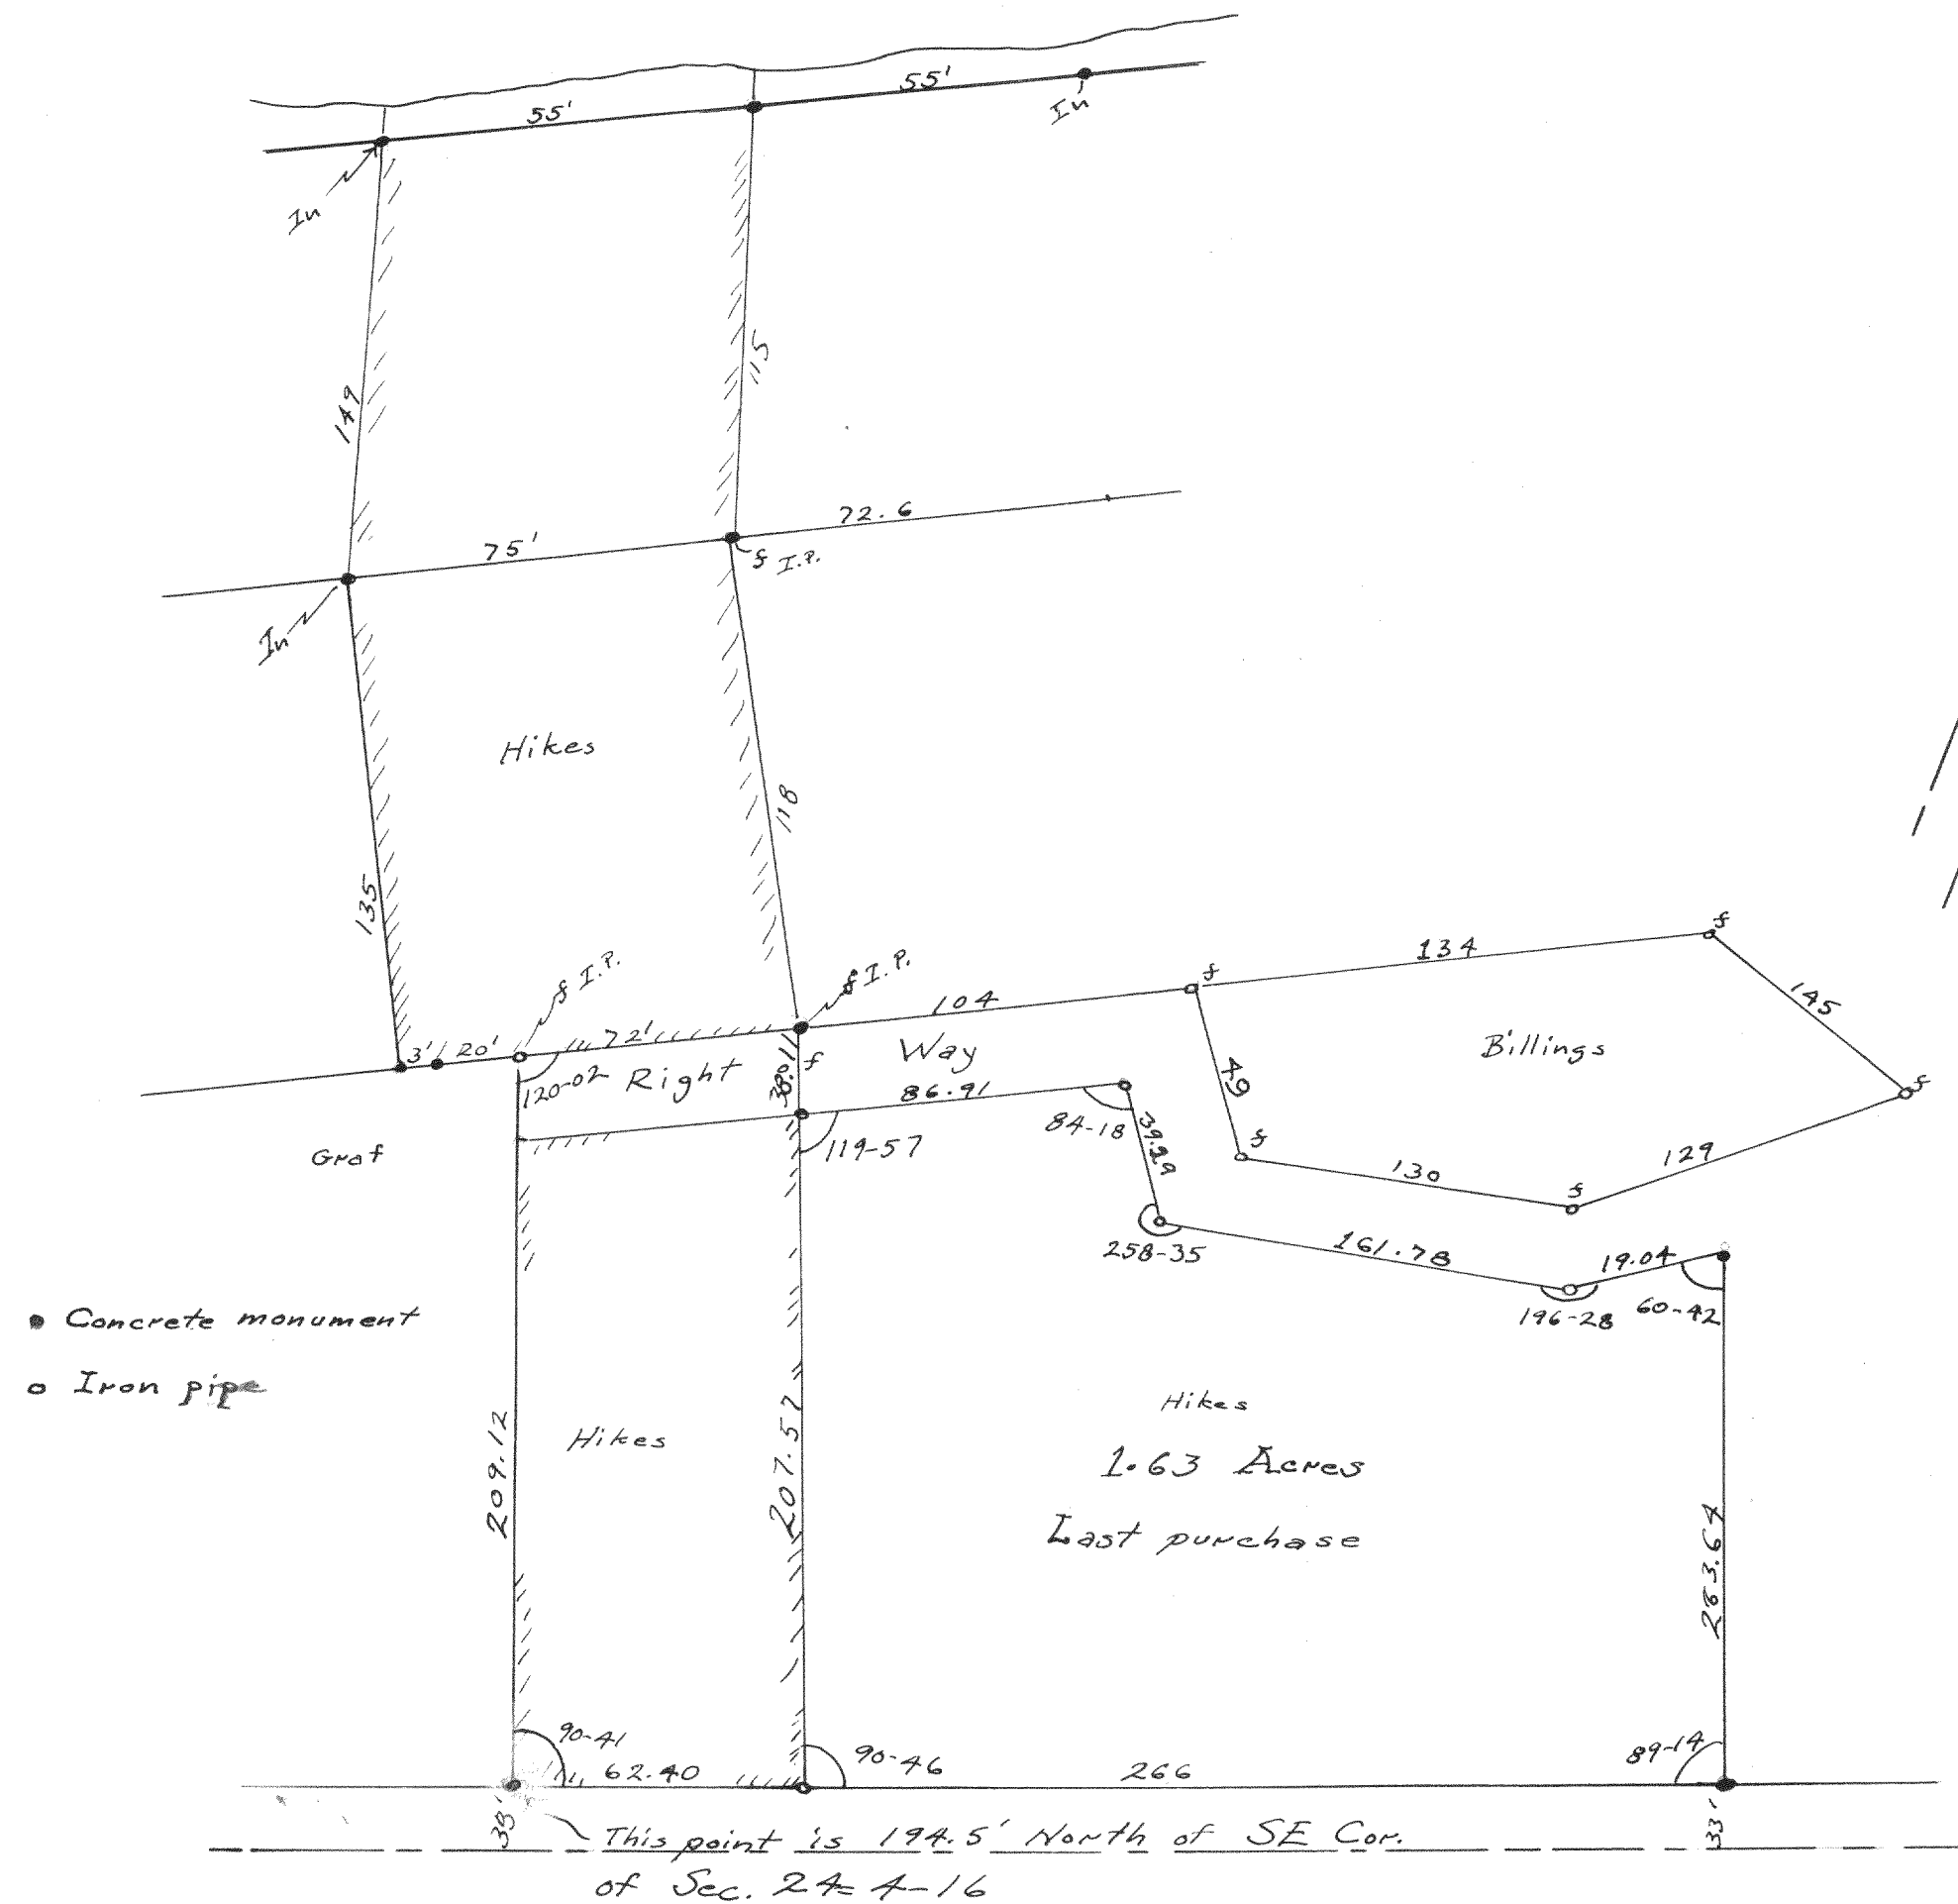

Survey of the farm of Michael Duggan

Lloyd L. Jensen
County Surveyor
By W. E. H.

Survey for Mr. Hikes of a parcel purchased from Mr. Elbeck and placing of concrete monuments as shown.

Lloyd L. Jensen
County Surveyor
By W. E. H.