


Record of Survey.

DESCRIPTION

243

Township....., North of Range.....of 4 Principal Meridian
as presented by the courses and distances on the following plat, and annexed field-notes of survey:
Established the center of the section at the point of intersection of STRAIGHT quarter lines.
Established all quarter-quarter corners upon the section boundary at proportional distances between known section and quarter section corners, according to the original field-notes of the Government survey.
Established all lost corners at proportionate distances between known corners, according to the original field notes of the Government survey.
No. 764

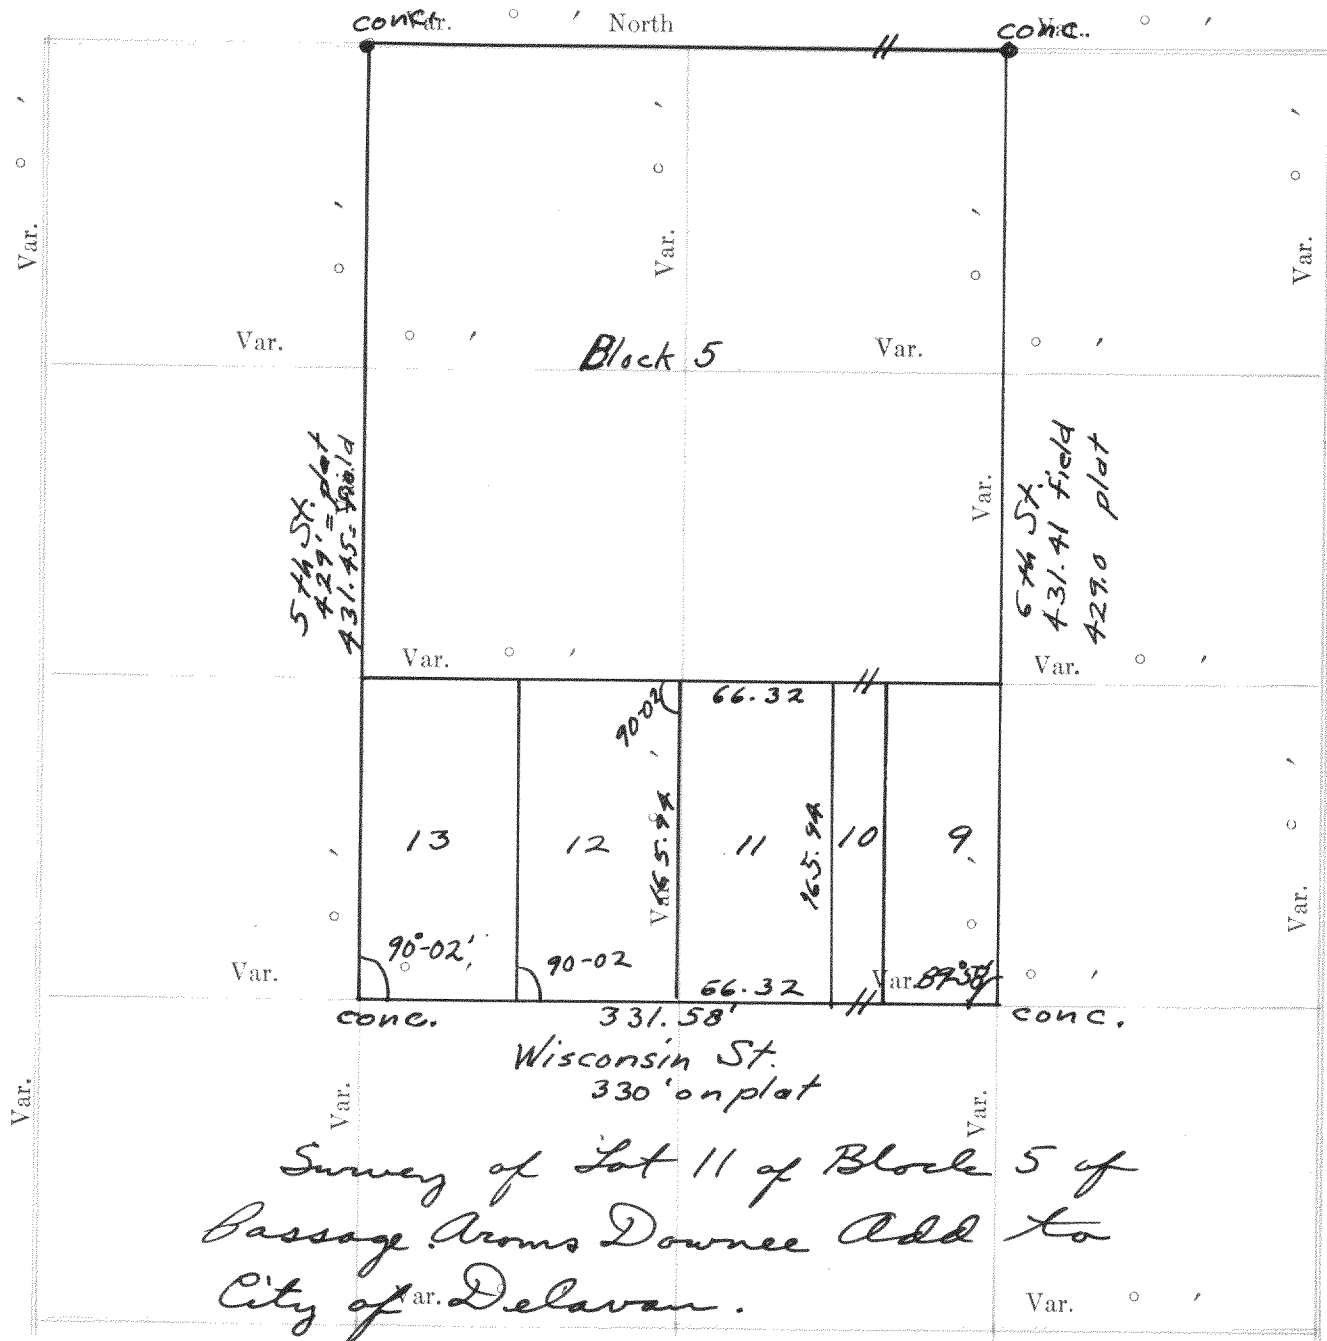

Plat of Section 11 of Block 5 of Passage Arms Downee Add to City of Delavan. Township....., North of Range.....of 4 Principal Meridian Scale 80 chains to 6 inches. The figures in red ink are the lengths of the courses as stated in the field notes of the Government survey.

Declination of the Magnetic Meridian from the True Meridian.....
Surveyed and sub-divided.....A. D. 1....., in accordance with the State Laws and Instructions of the Commissioner of the General Land office, and recorded on pages.....of Register in the County Clerk's office.
Witness my hand this.....day of.....A. D. 1.....

.....SURVEYOR.

OF SECTION, QUARTER SECTION AND QUARTER QUARTER SECTION CORNERS

GOVERNMENT CORNERS


- No.
1. N. W. Sec. Cor. identified,
2. N. E. Sec. Cor. identified,
3. S. E. Sec. Cor. identified,
4. S. W. Sec. Cor. identified,
5. N. 1/4 Sec. Cor. identified,
6. E. 1/4 Sec. Cor. identified,
7. S. 1/4 Sec. Cor. identified,
8. W. 1/4 Sec. Cor. identified,

Subdivision Corners

- No.
1. Center 1/4 Sec. Cor.
2. North 1/4-1/4s N. W. qr.,
3. East 1/4-1/4s N. W. qr.,
4. South 1/4-1/4s N. W. qr.,
5. West 1/4-1/4s N. W. qr.,
6. Center 1/4-1/4s N. W. qr.,
7. North 1/4-1/4s N. E. qr.,
8. East 1/4-1/4s N. E. qr.,
9. South 1/4-1/4s N. E. qr.,
10. Center 1/4-1/4s N. E. qr.,
11. East 1/4-1/4s S. E. qr.,
12. South 1/4-1/4s S. E. qr.,
13. West 1/4-1/4s S. E. qr.,
14. Center 1/4-1/4s S. E. qr.,
15. South 1/4-1/4s S. W. qr.,
16. West 1/4-1/4s S. W. qr.,
17. Center 1/4-1/4s S. W. qr.

Bearing	In.	Courses	Links	Bearing	In.	Courses	Links	Bearing	In.	Courses	Links	Bearing	In.	Courses	Links
Trees	Dia.	they bear	Distant	Trees	Dia.	they bear	Distant	Trees	Dia.	they bear	Distant	Trees	Dia.	they bear	Distant

No. 765

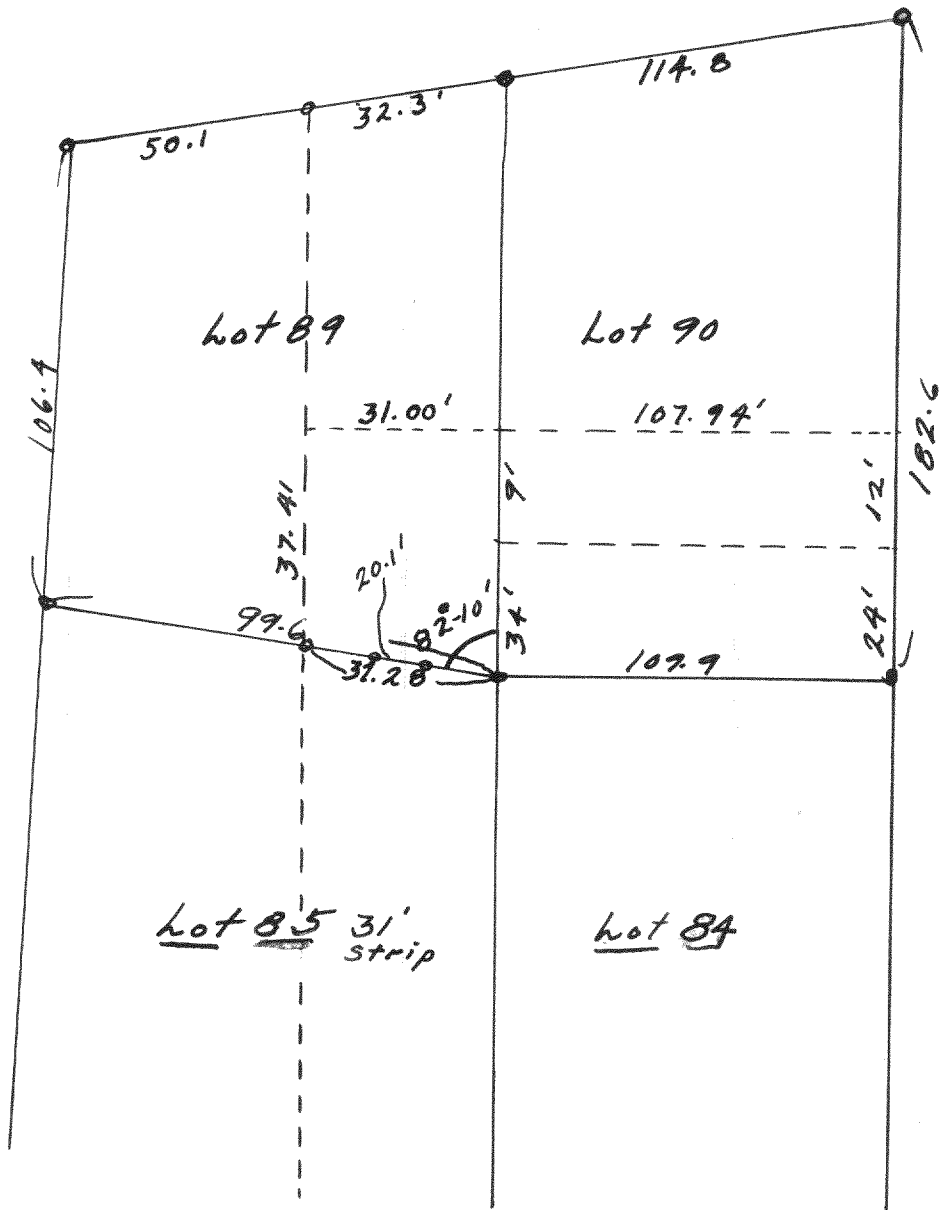

Subdivision of Lots as shown in
Country Club Estates Unit 2.
Aug. 31, 1936

Lloyd L. Jensen
County Surveyor
By W. E. H.


NAMES OF SWORN ASSISTANTS

CHAINMEN

FLAGMEN

AXMEN

No. 766

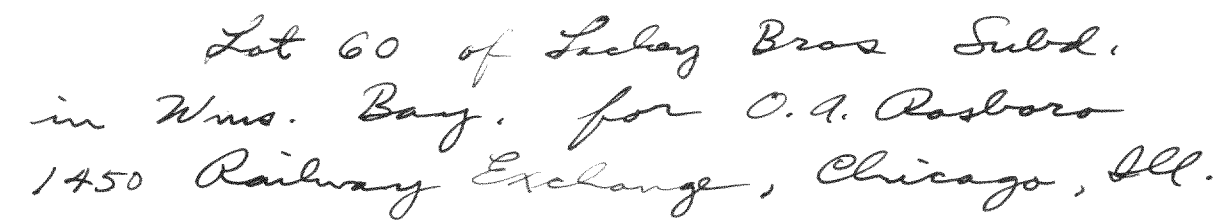

Lloyd L. Jansen
County Surveyor
By W. E. H.

A hand-drawn site plan of a house. The house is represented by a rectangle with a smaller rectangle attached to its bottom side. The main rectangle is labeled "House" and has dimensions 32.4 (width) and 26.5 (height). The smaller rectangle has a width of 8.32 and a height of 4. The setbacks from the property boundaries are indicated by dashed lines and dimensions: 16.5 (left), 32.2' (top), 42.2' (top right), 38.9' (top right), 34.5' (bottom right), and 12' (bottom right). The word "Front" is written at the bottom of the plan.

Location of house on Lot 19 of Block D
Country Club Estates (Unit 3).

Sept. 2, 1936

Lloyd L. Jensen
County Surveyor
By W. E. H.