


Record of Survey.

Township....., North of Range.....of 4 Principal Meridian
as presented by the courses and distances on the following plat, and annexed field-notes of survey:
Established the center of the section at the point of intersection of STRAIGHT quarter lines.
Established all quarter-quarter corners upon the section boundary at proportional distances between known section and quarter section corners, according to the original field-notes of the Government survey.
Established all lost corners at proportionate distances between known corners, according to the original field notes of the Government survey.
No. 790

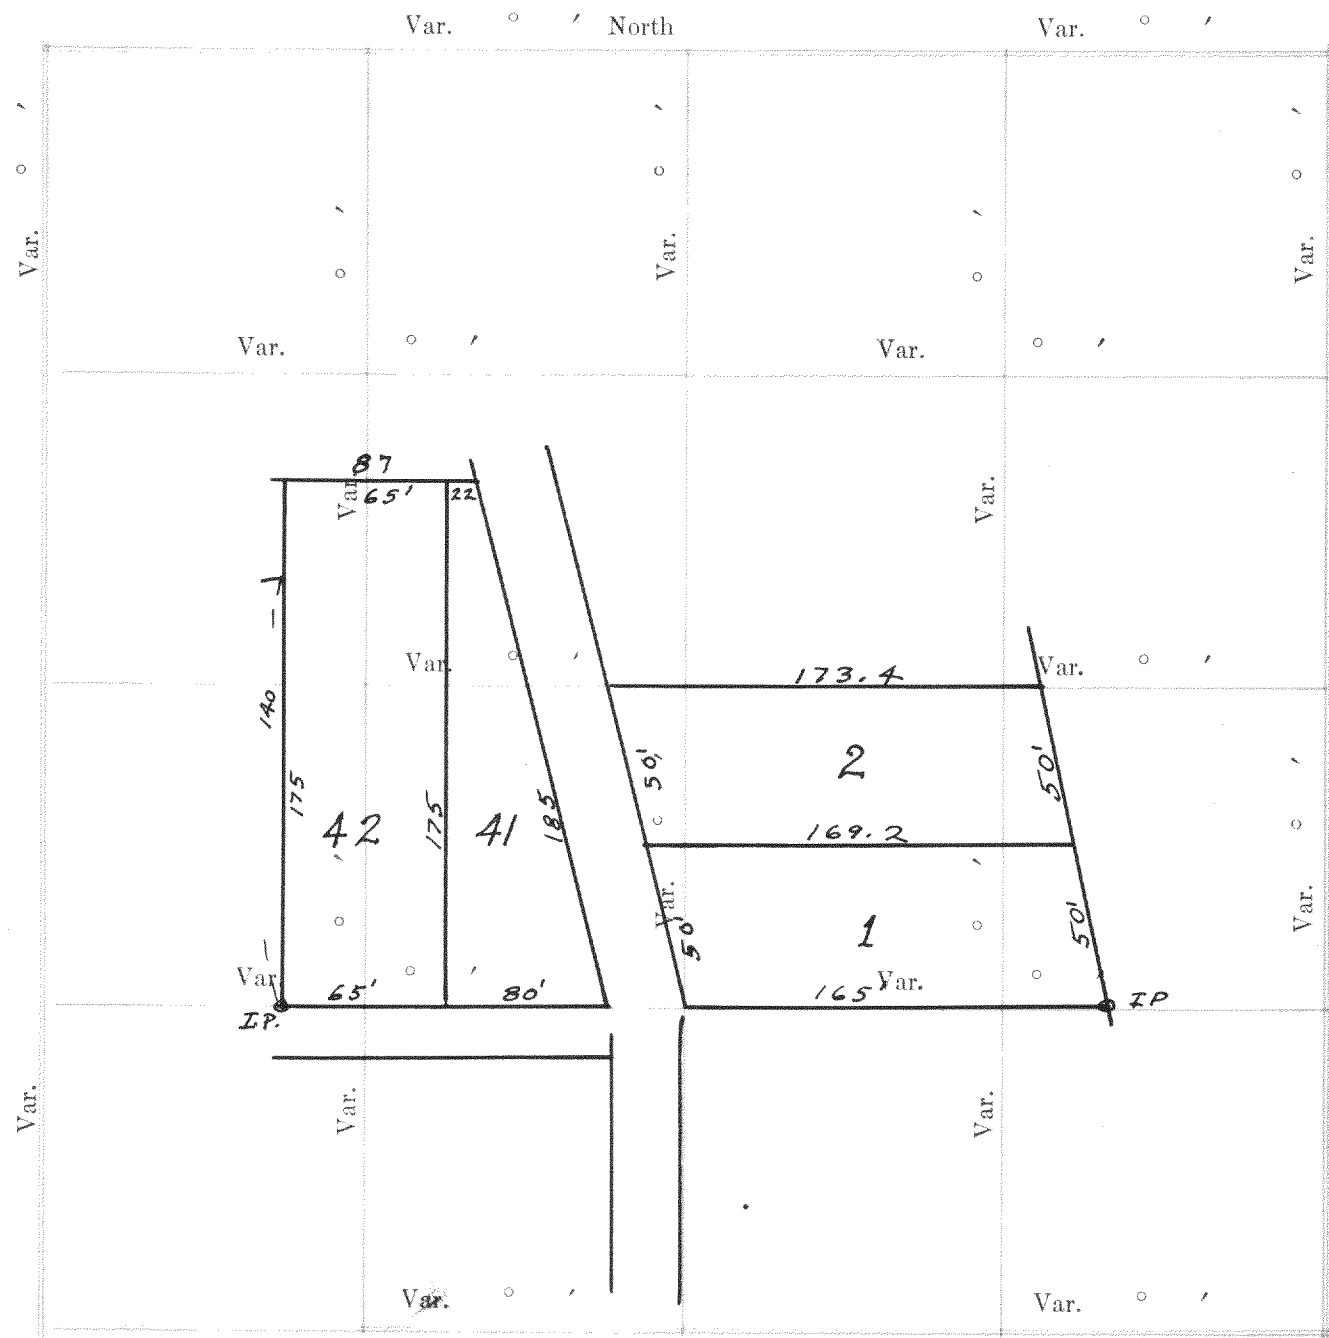

Plat of Section *Survey of Lots 142, 141, 143, 144 of the Annex* Township *14 N*, Range *42 E* of 4 Principal Meridian Scale
80 chains to 6 inches. The figures in red ink are the lengths of the lines as stated in the field-notes of the
Government survey.
Declination of the Magnetic Meridian from the True Meridian.....
Surveyed and sub-divided.....
with the State Laws and Instructions of the Commissioner of the General Land office, and recorded on pages
.....of Register in the County Clerk's office.
Witness my hand this.....day of.....A. D. 1.....
.....SURVEYOR.

DESCRIPTION

OF SECTION, QUARTER SECTION AND QUARTER QUARTER SECTION CORNERS

GOVERNMENT CORNERS


- No.
1. N. W. Sec. Cor. identified,
2. N. E. Sec. Cor. identified,
3. S. E. Sec. Cor. identified,
4. S. W. Sec. Cor. identified,
5. N. ¼ Sec. Cor. identified,
6. E. ¼ Sec. Cor. identified,
7. S. ¼ Sec. Cor. identified,
8. W. ¼ Sec. Cor. identified,

Subdivision Corners

- No.
1. Center ¼ Sec. Cor.,
2. North ¼-¼s N. W. qr.,
3. East ¼-¼s N. W. qr.,
4. South ¼-¼s N. W. qr.,
5. West ¼-¼s N. W. qr.,
6. Center ¼-¼s N. W. qr.,
7. North ¼-¼s N. E. qr.,
8. East ¼-¼s N. E. qr.,
9. South ¼-¼s N. E. qr.,
10. Center ¼-¼s N. E. qr.,
11. East ¼-¼s S. E. qr.,
12. South ¼-¼s S. E. qr.,
13. West ¼-¼s S. E. qr.,
14. Center ¼-¼s S. E. qr.,
15. South ¼-¼s S. W. qr.,
16. West ¼-¼s S. W. qr.,
17. Center ¼-¼s S. W. qr.

Bearing	In.	Courses	Links	Bearing	In.	Courses	Links	Bearing	In.	Courses	Links	Bearing	In.	Courses	Links
Trees	Dia.	they bear	Distant	Trees	Dia.	they bear	Distant	Trees	Dia.	they bear	Distant	Trees	Dia.	they bear	Distant

No. 791

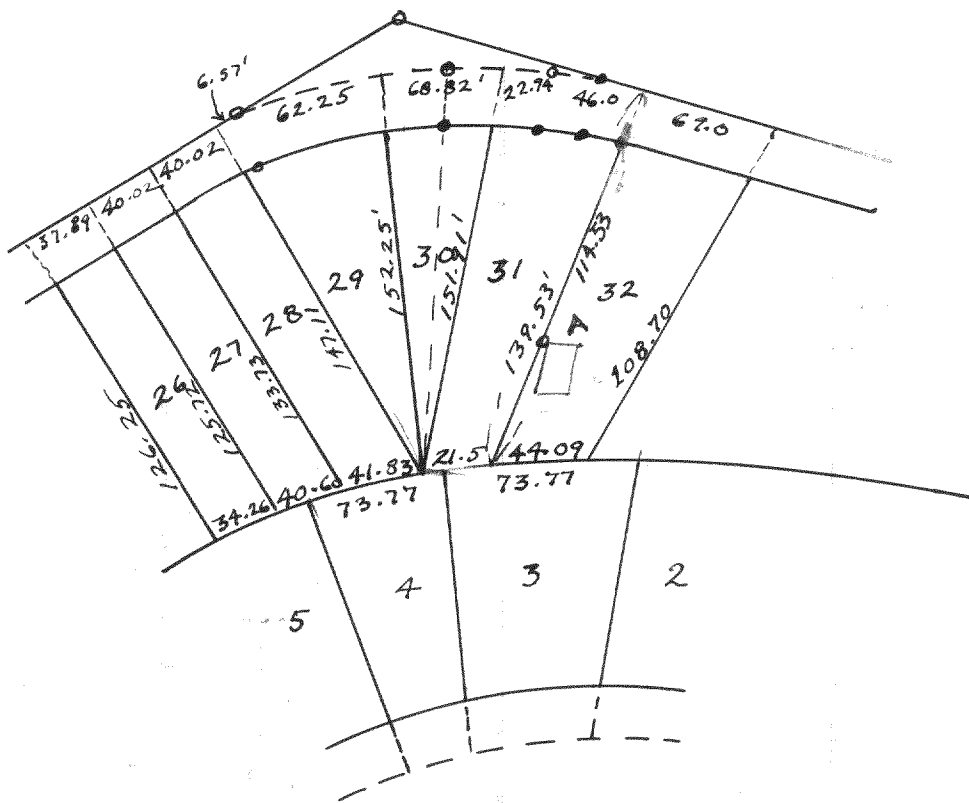

Set iron pipe at "A" on Lot 31 of Block 43, 4th Map of Interlaken Subd. in Sec 11-3-16

*Lloyd L. Jensen
County Surveyor
By H.E.H.*

NAMES OF SWORN ASSISTANTS

CHAINMEN

FLAGMEN

AXMEN

