


Record of Survey.

DESCRIPTION

no. 61

Township..... North of Range..... of 4 Principal Meridian
as presented by the courses and distances on the following plat, and annexed field-notes of survey:
Established the center of the section at the point of intersection of STRAIGHT quarter lines.
Established all quarter-quarter corners upon the section boundary at proportional distances between known section and quarter section corners, according to the original field-notes of the Government survey.
Established all lost corners at proportionate distances between known corners, according to the original field notes of the Government survey.

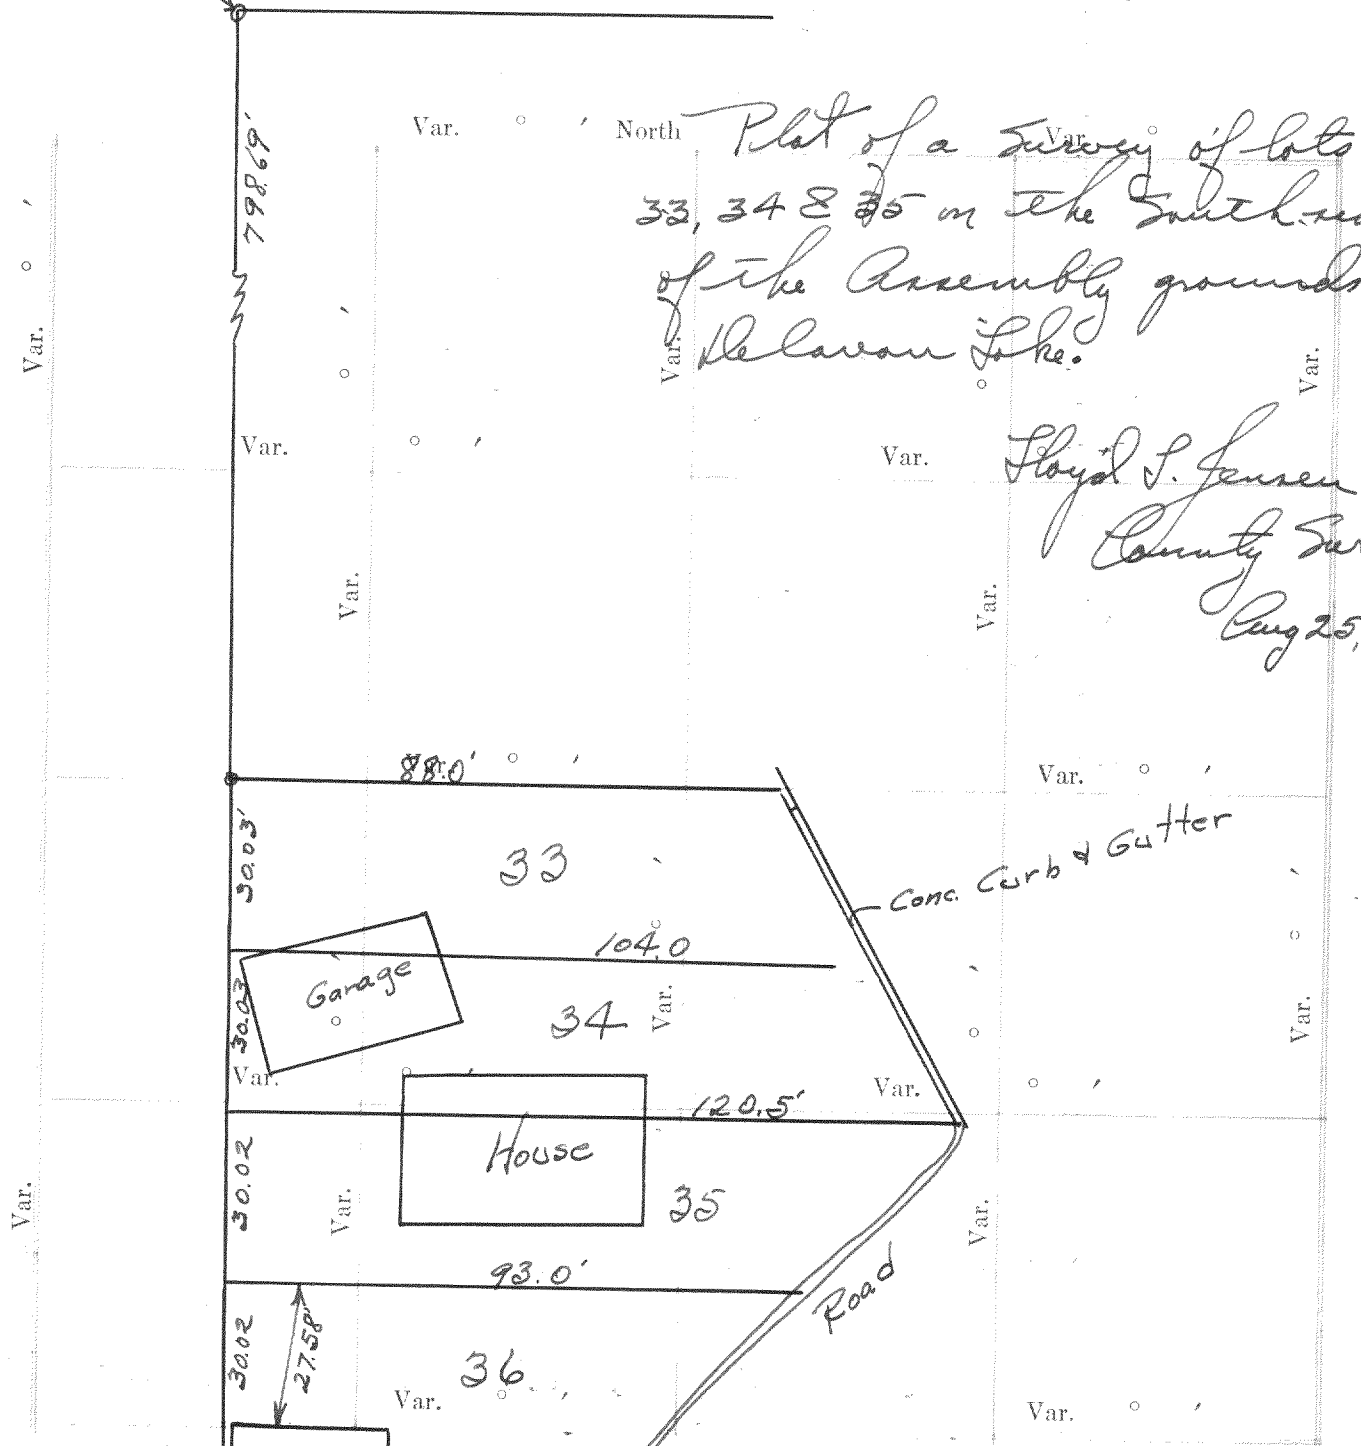

Plat of Section..... Township..... North, Range..... of 4 Principal Meridian Scale
80 chains to 6 inches. The figures in red ink are the lengths of the lines as stated in the field-notes of the
Government survey
Declination of the Magnetic Meridian from the True Meridian.....
Surveyed and subdivided..... A. D. 1..... in accordance
with the State Laws and Instructions of the Commissioner of the General Land Office and recorded on pages
..... of Register in the County Clerk's office.

Witness my hand this..... day of..... A. D. 1.....
..... SURVEYOR.

OF SECTION, QUARTER SECTION AND QUARTER QUARTER SECTION CORNERS

No.	GOVERNMENT CORNERS				SUBDIVISION CORNERS			
	Bearing	In.	Courses	Links	Bearing	In.	Courses	Links
	Trees	Dia.	they bear	Distant	Trees	Dia.	they bear	Distant

- No. 1. N. W. Sec. Cor. identified,
2. N. E. Sec. Cor. identified,
3. S. E. Sec. Cor. identified,
4. S. W. Sec. Cor. identified,
5. N. 1/4 Sec. Cor. identified,
6. E. 1/4 Sec. Cor. identified,
7. S. 1/4 Sec. Cor. identified,
8. W. 1/4 Sec. Cor. identified,
Subdivision Corners
No. 1. Center 1/4 Sec. Cor.
2. North 1/4-1/4s N. W. qr.,
3. East 1/4-1/4s N. W. qr.,
4. South 1/4-1/4s N. W. qr.,
5. West 1/4-1/4s N. W. qr.,
6. Center 1/4-1/4s N. W. qr.,
7. North 1/4-1/4s N. E. qr.,
8. East 1/4-1/4s N. E. qr.,
9. South 1/4-1/4s N. E. qr.,
10. Center 1/4-1/4s N. E. qr.,
11. East 1/4-1/4s S. E. qr.,
12. South 1/4-1/4s S. E. qr.,
13. West 1/4-1/4s S. E. qr.,
14. Center 1/4-1/4s S. E. qr.,
15. South 1/4-1/4s S. W. qr.,
16. West 1/4-1/4s S. W. qr.,
17. Center 1/4-1/4s S. W. qr.



Plat of survey for Mrs. Wadsworth
Location Sec. 27, T. 27, R. 15 E
April 24, 1933
Floyd S. Jensen
County Surveyor


NAMES OF SWORN ASSISTANTS

CHAINMEN	FLAGMEN	AXMEN


No. 63

The Lyons Milk Company

No. 64

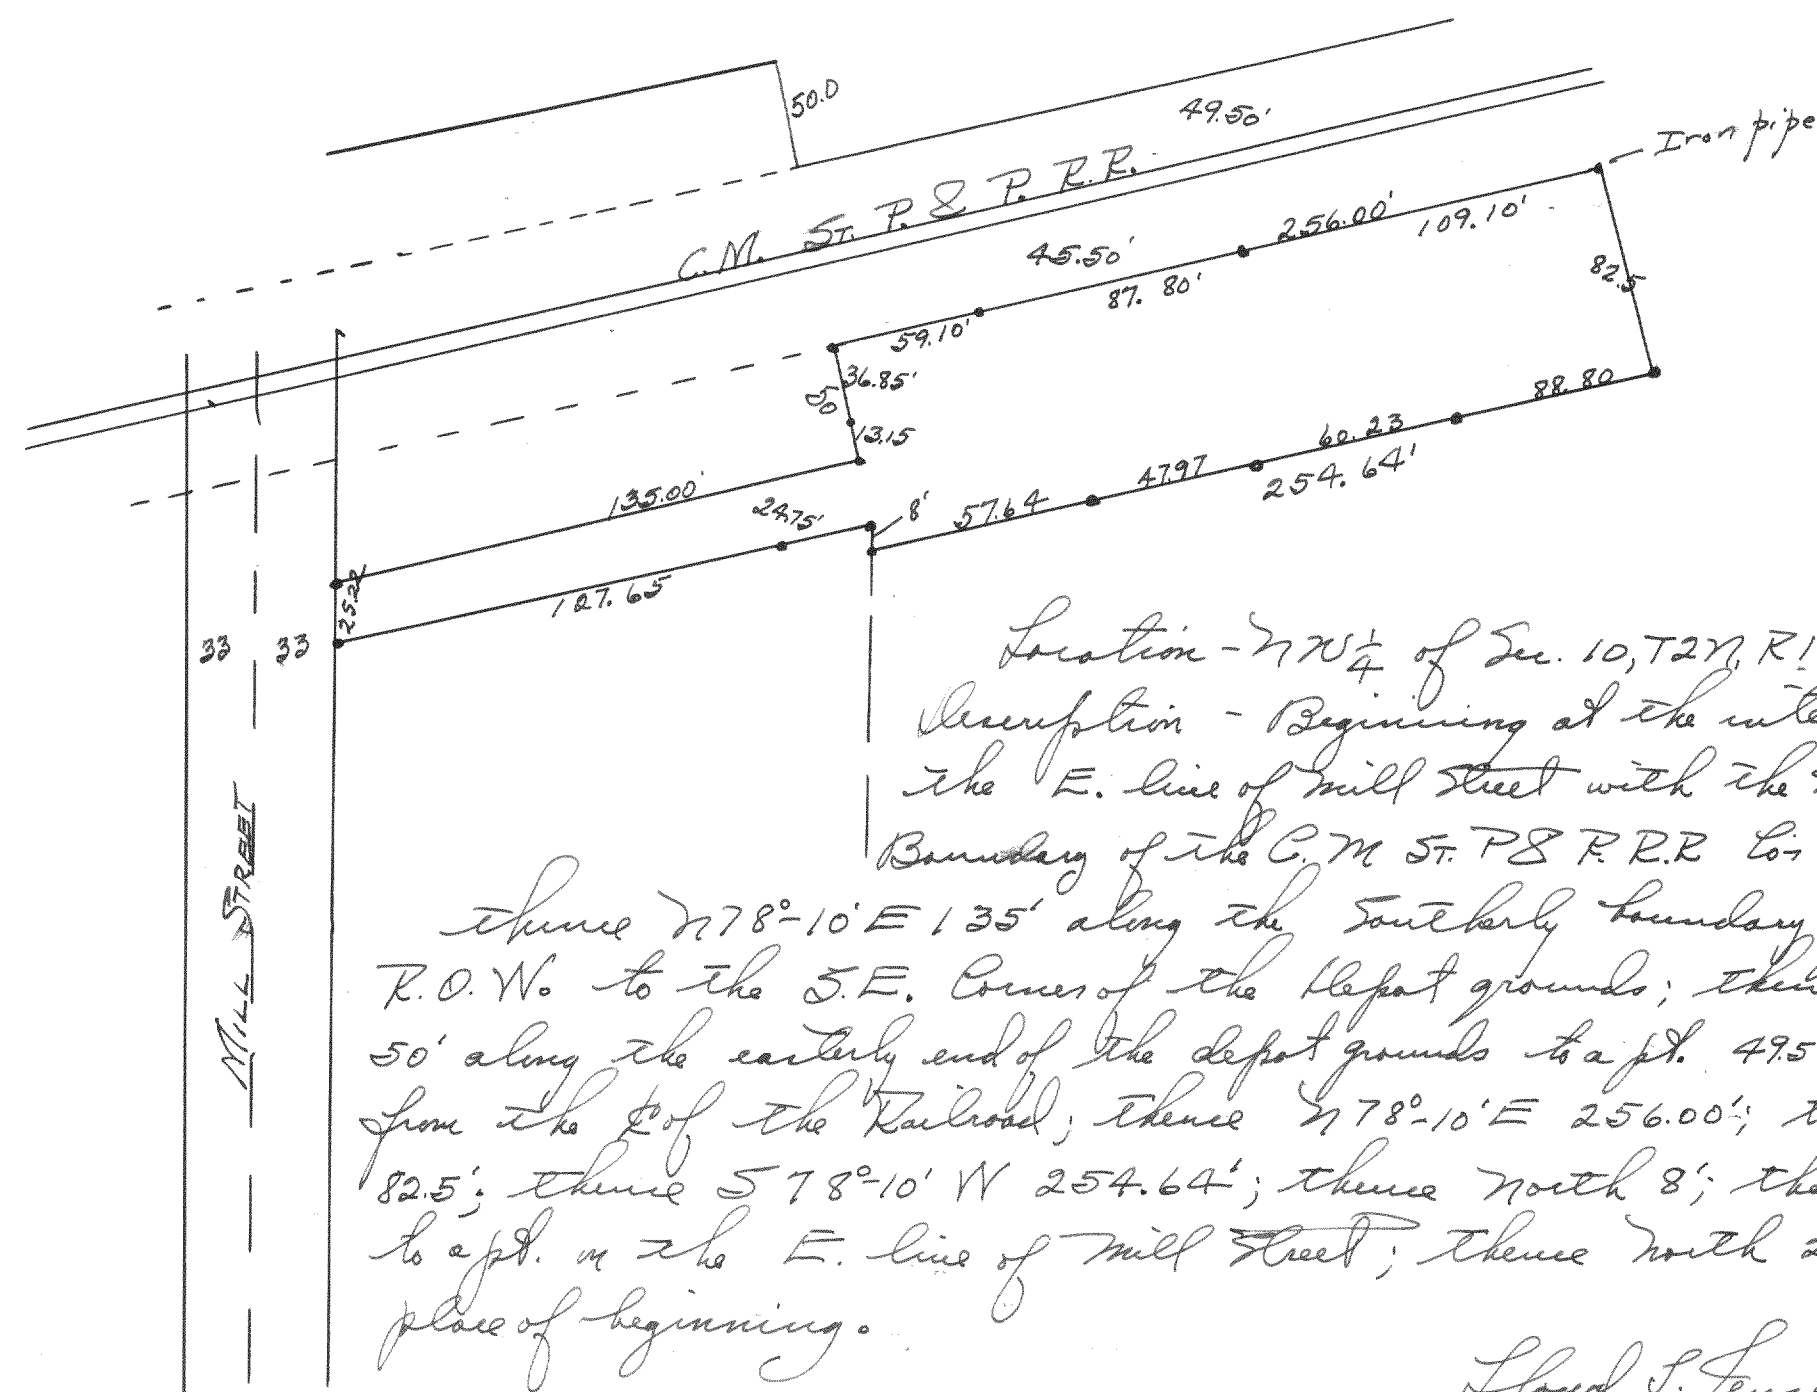

April 10, 1933

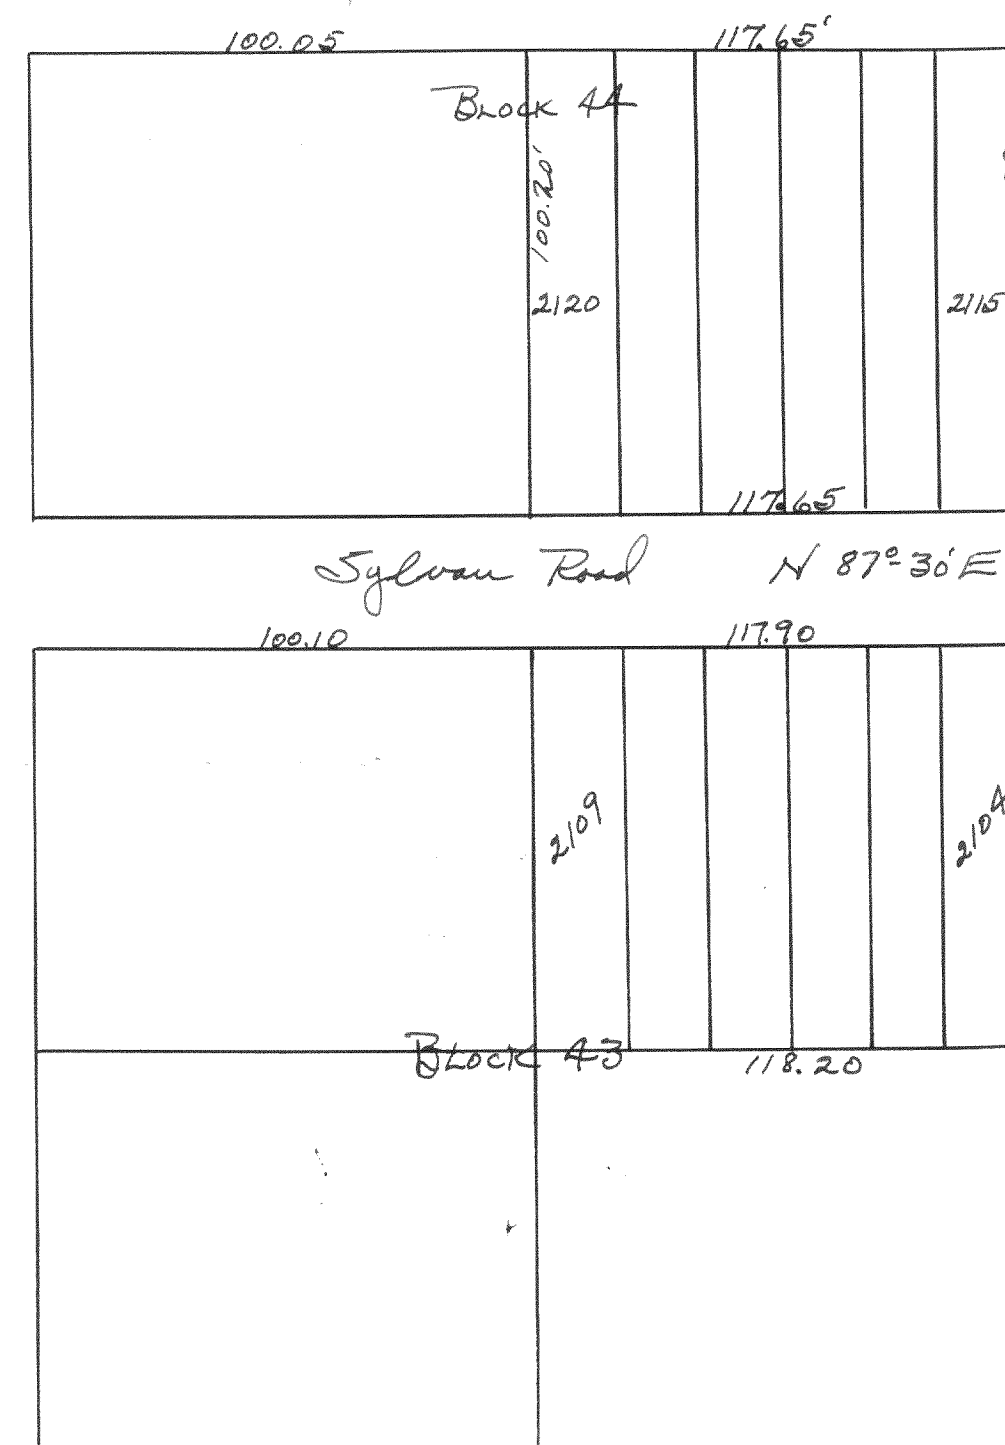Lloyd S. Jensen
County SurveyorN
Lincoln Road N2°-30'W

Survey of lots for C. W. English Jr.
 Location - in Section 2 of Tall Lake Plots.
 Lloyd S. Jensen
 County Surveyor
 March 29, 1933